


PROJECT DESCRIPTION AND LOCATION

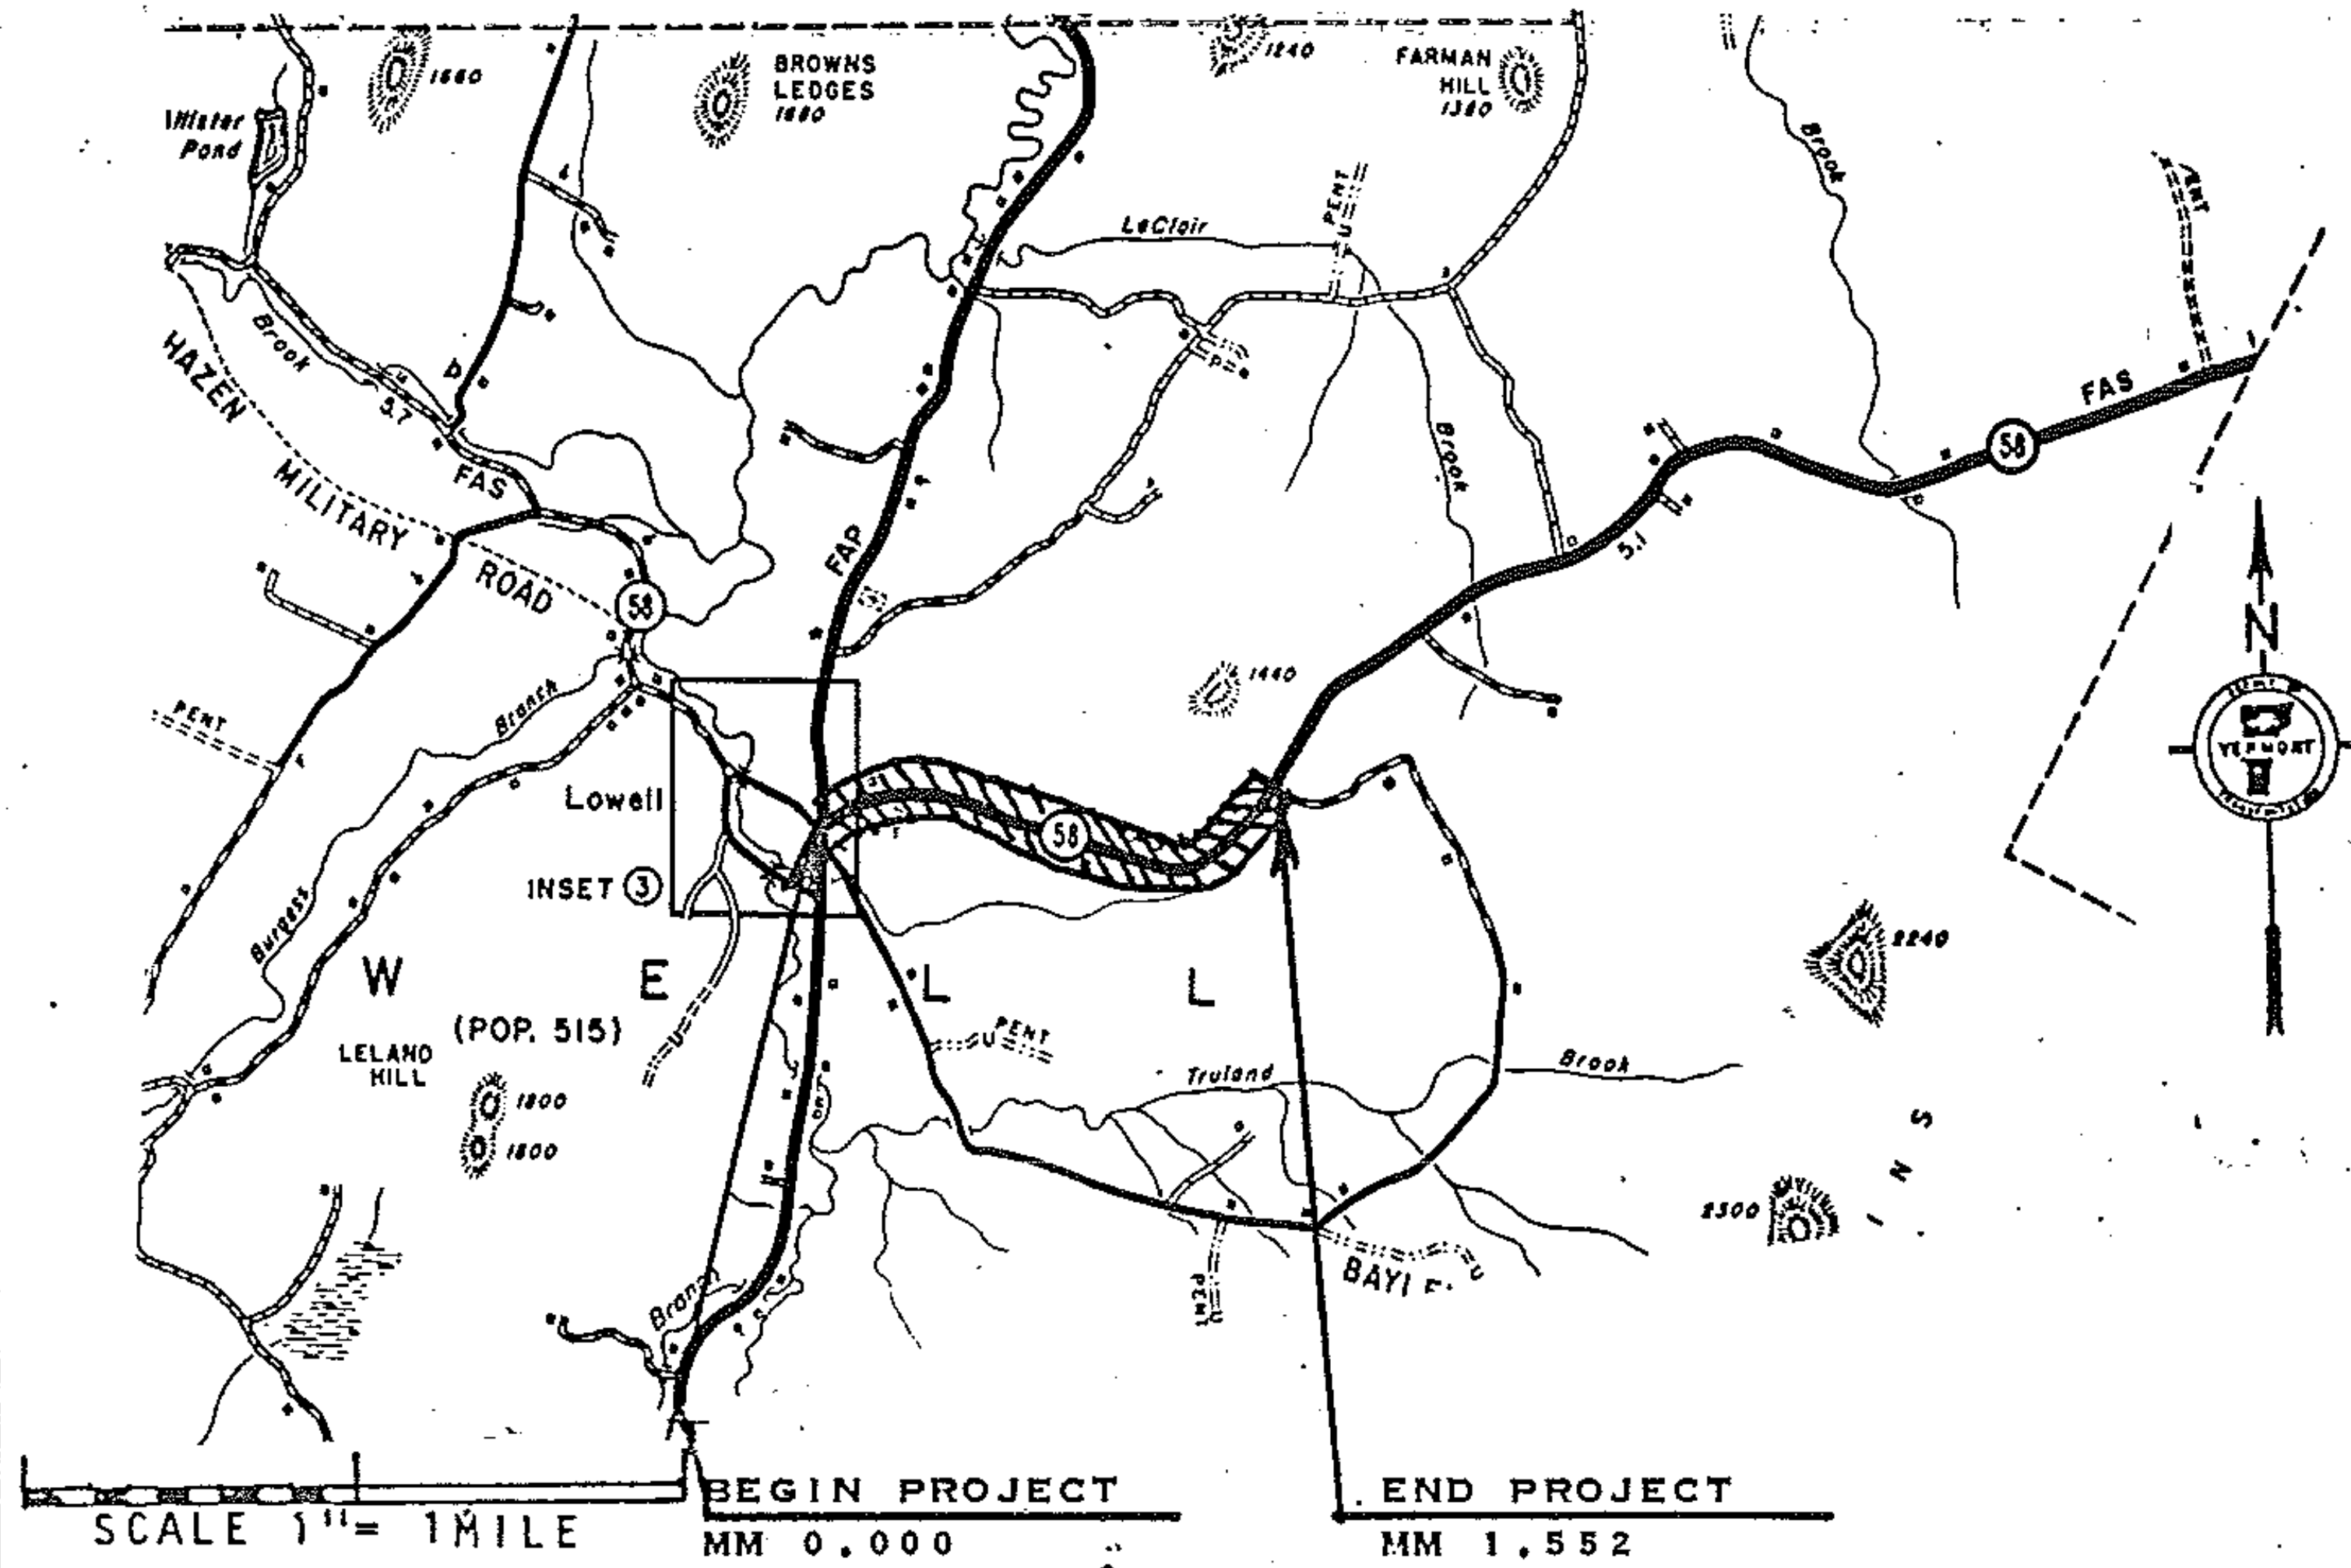

VT 58- IN THE TOWN OF LOWELL BEGINNING AT MM0.000 AND EXTENDING
1.552 MILES EASTERLY TO MM 1.552.

LENGTH OF PROJECT
1.552 MILES
8195 FEET

PROJECT LOWELL

NO. RS 0308(6)

SHEET 4 OF 20 SHEETS