


TYPICAL SECTIONS & DESIGN DATA

ITEM 406.25 BITUMINOUS CONCRETE PAVEMENT
LEVELING COURSE TYPE III OR IV (250 TONS/MILE)
AS DIRECTED BY THE ENGINEER
3/4" WEARING COURSE (± 1/4") TYPE IV

GRAVEL SHOULDER
3" AVE DEPTH
MATCH TO PAVEMENT
EDGE

GRAVEL SHOULDER
3" AVE DEPTH
MATCH TO PAVEMENT
EDGE

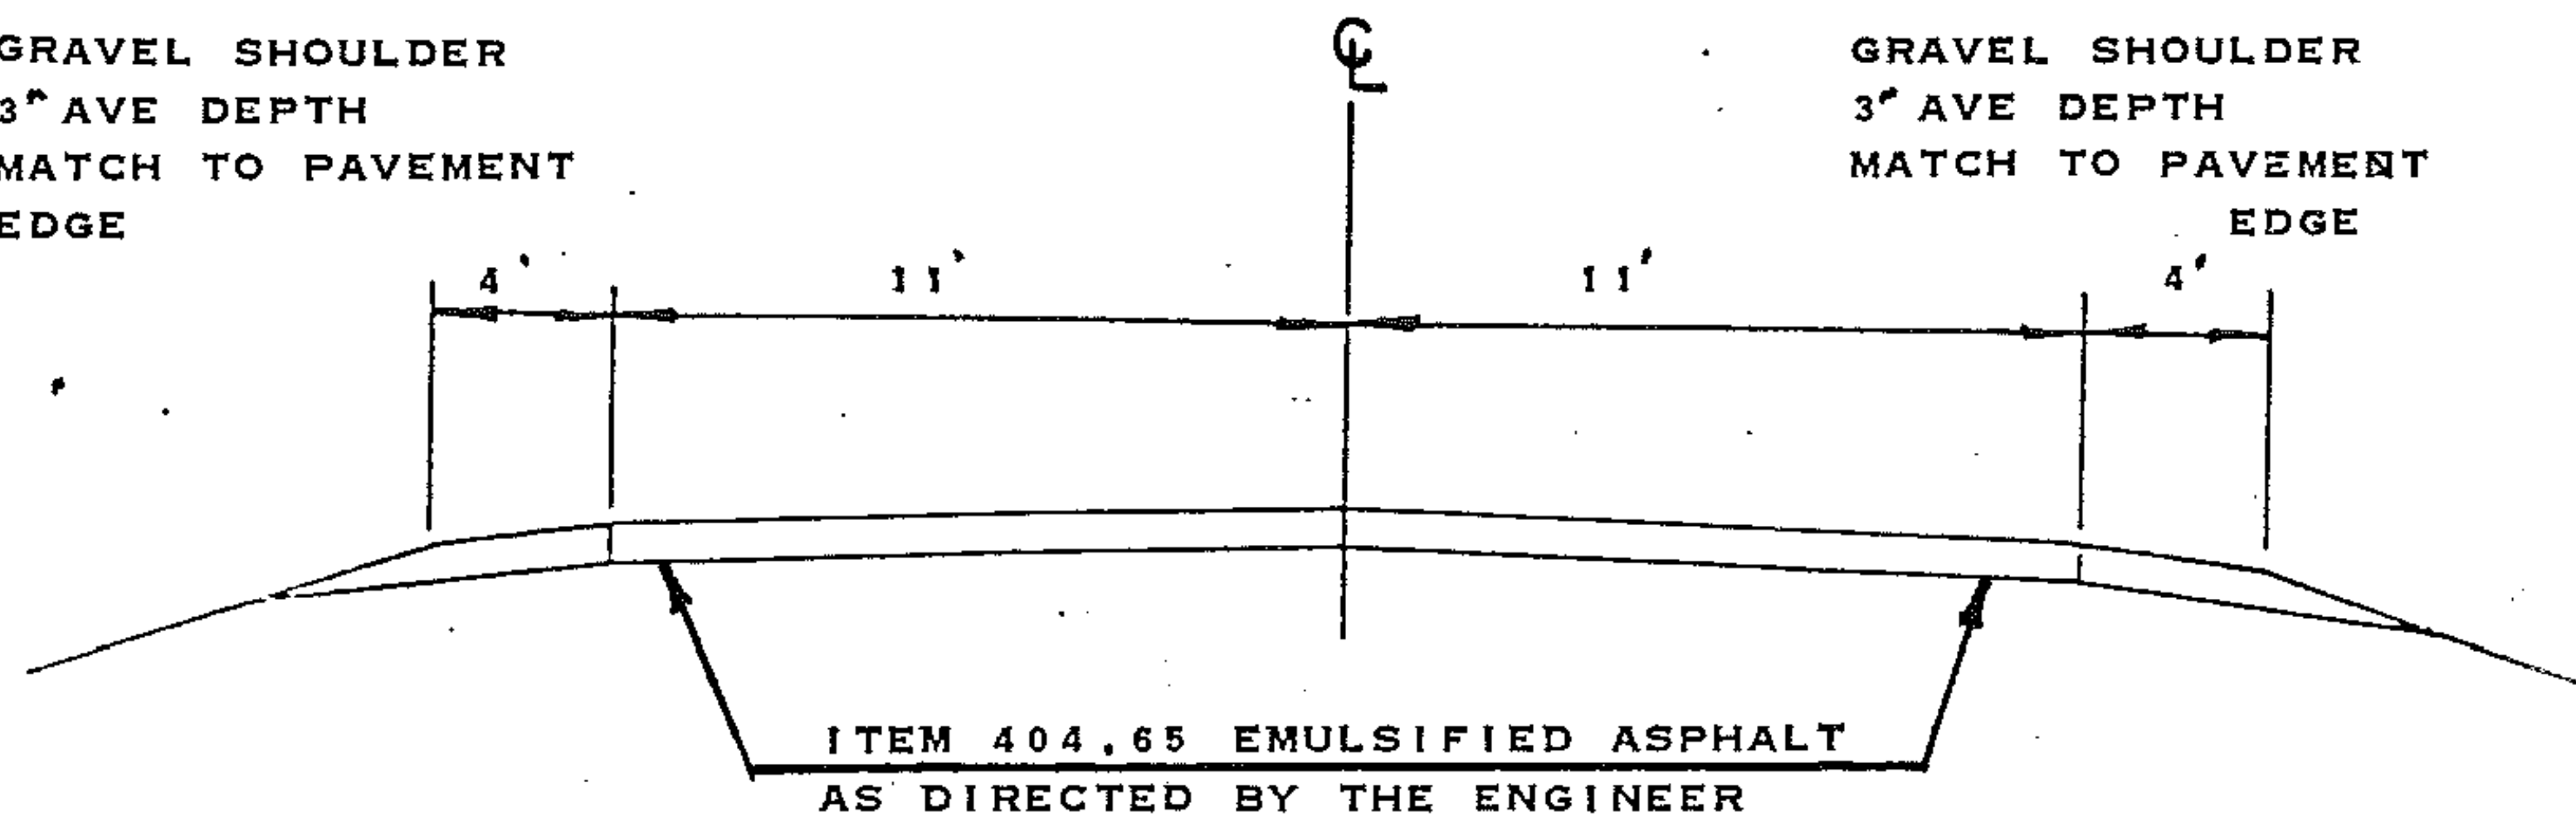

1982 ADT 630
V 50

Note: Topsoil, Item 653.10 to be applied as directed by the Engineer.
Seed, Fertilizer, Limestone and Mulch Items to be applied as required,
payment to be subsidiary to the Topsoil item.

PROJECT LOWELL

NO. RS 0308(6)

SHEET 5 OF 20 SHEETS