


PROJECT DESCRIPTION AND LOCATION

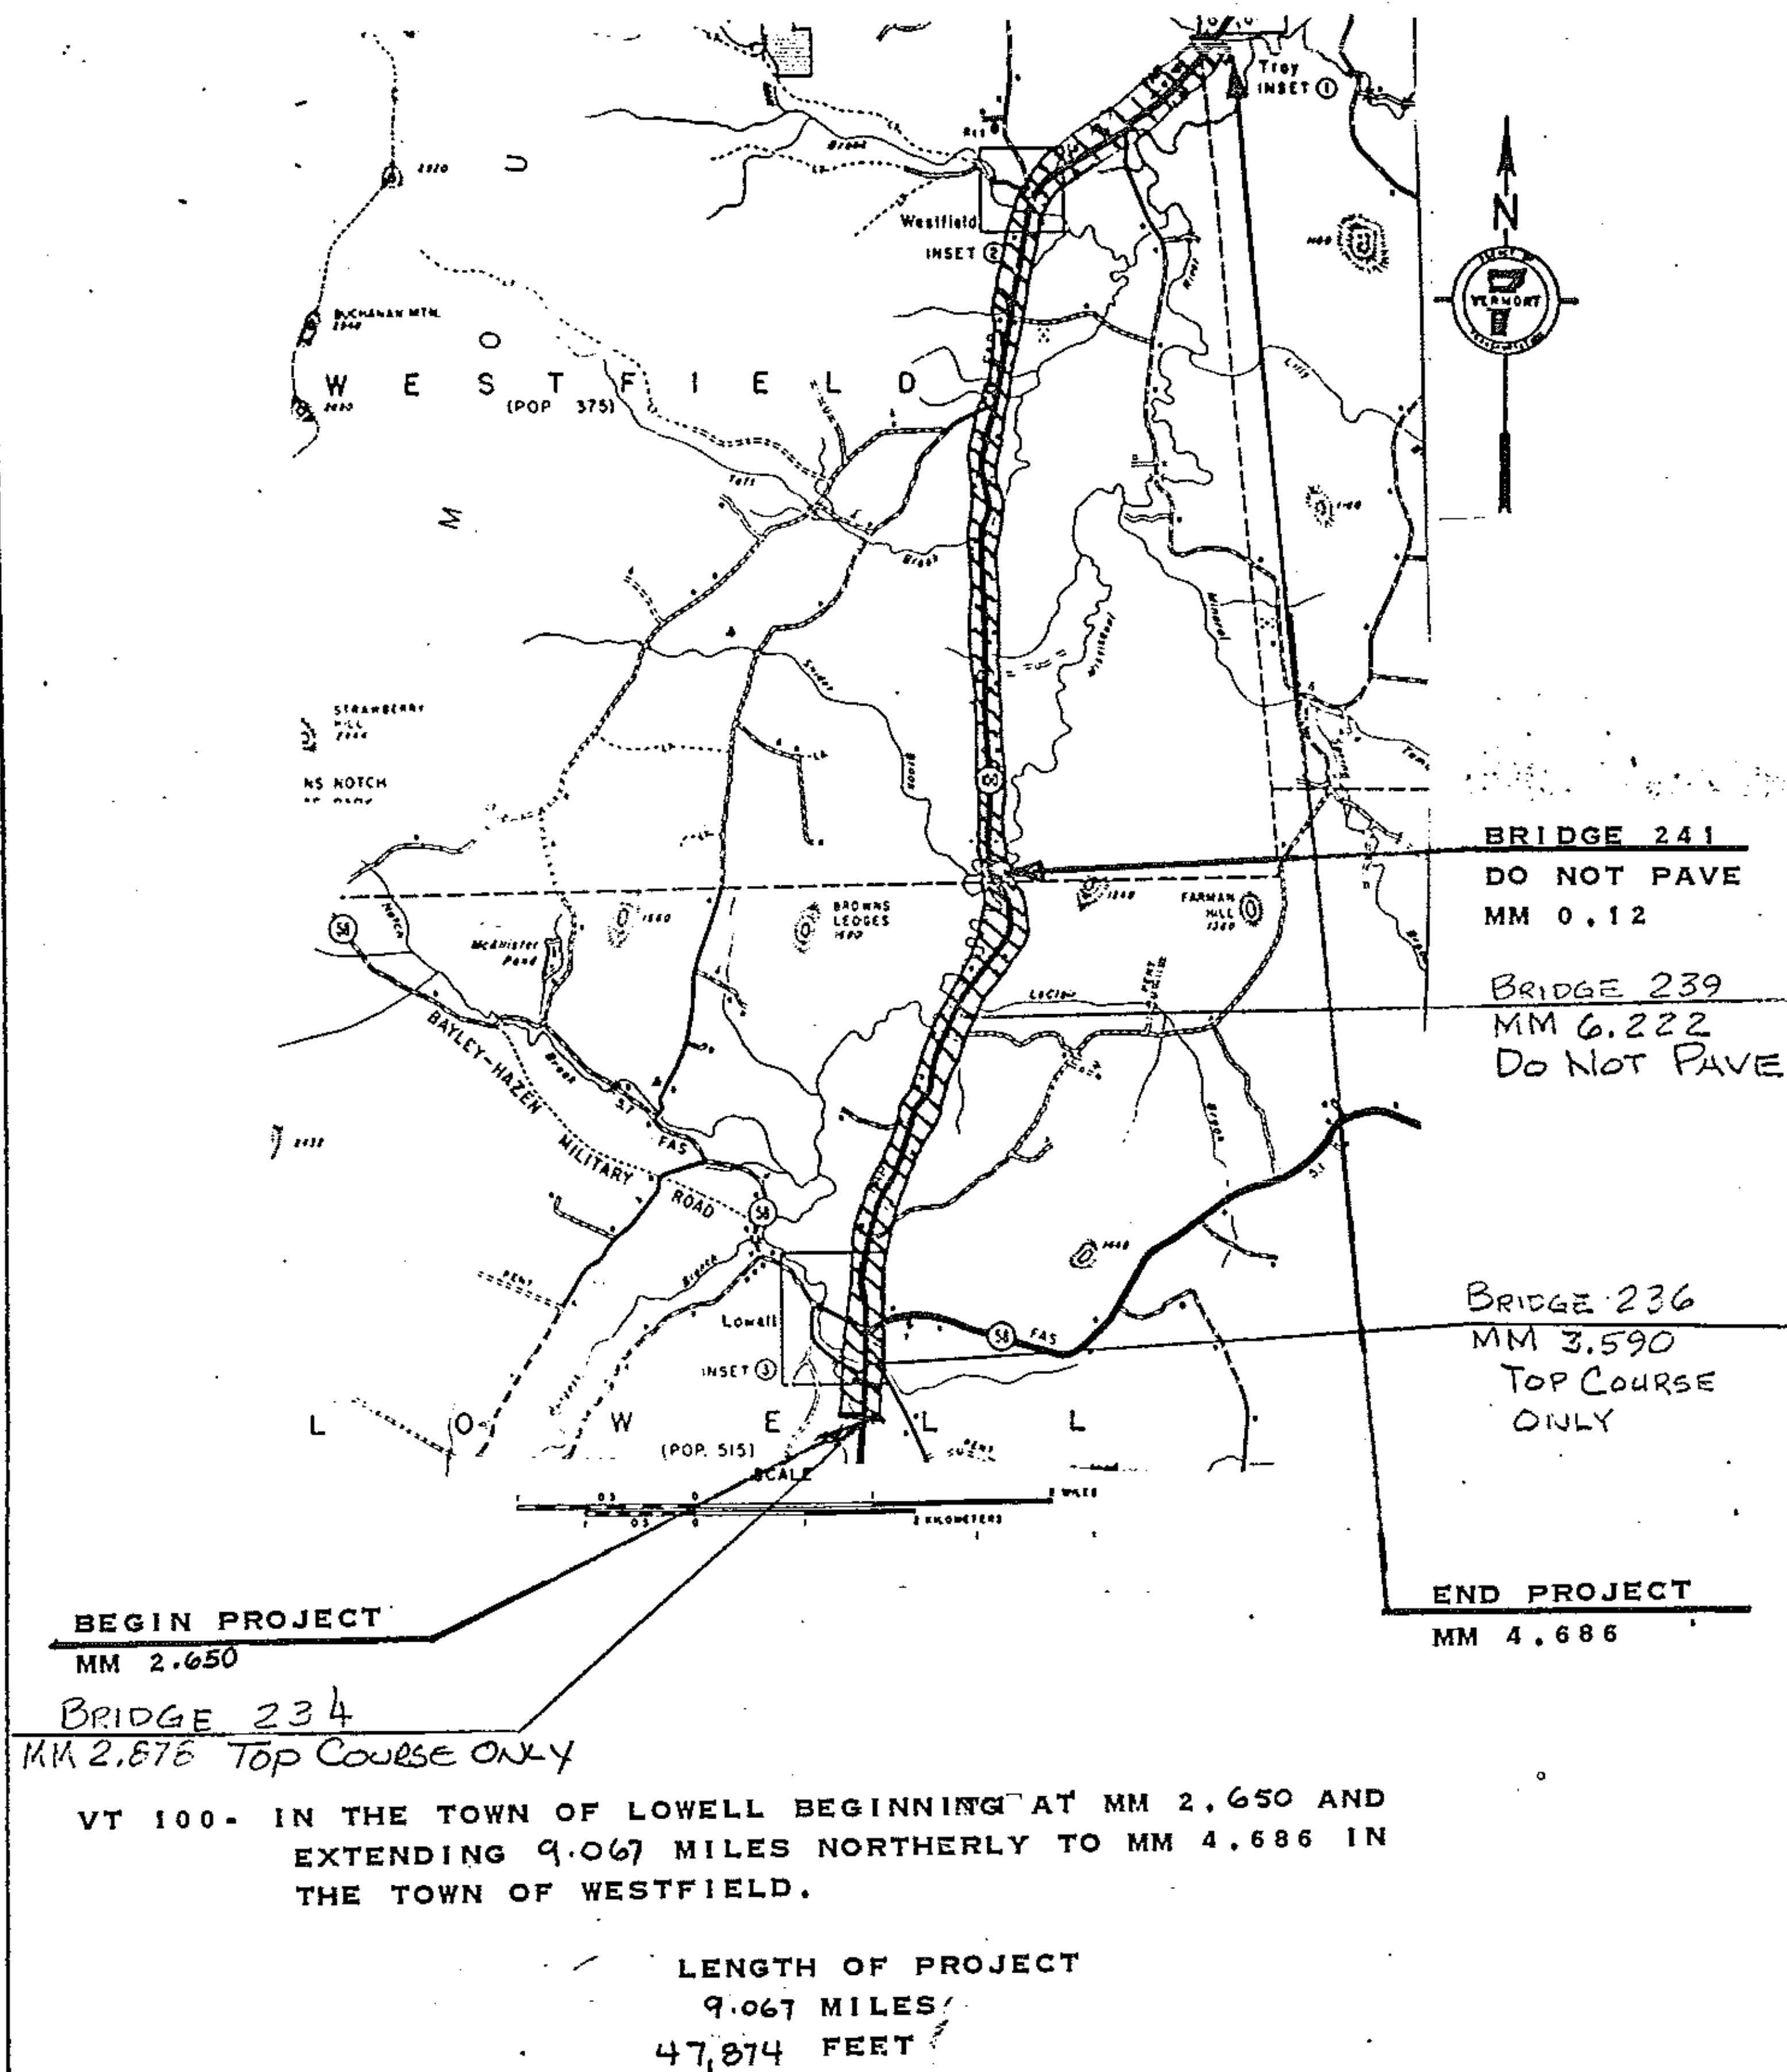

PROJECT LOWELL-WESTFIELD

NO. F 029-2(8)S

SHEET 8 OF 20 SHEETS