


# TYPICAL SECTIONS & DESIGN DATA

ITEM 406.25 BITUMINOUS CONCRETE PAVEMENT  
 LEVELING COURSE, TYPE III OR IV (SEE TABLE BELOW)  
 AS DIRECTED BY THE ENGINEER  
 1" WEARING COURSE, TYPE III

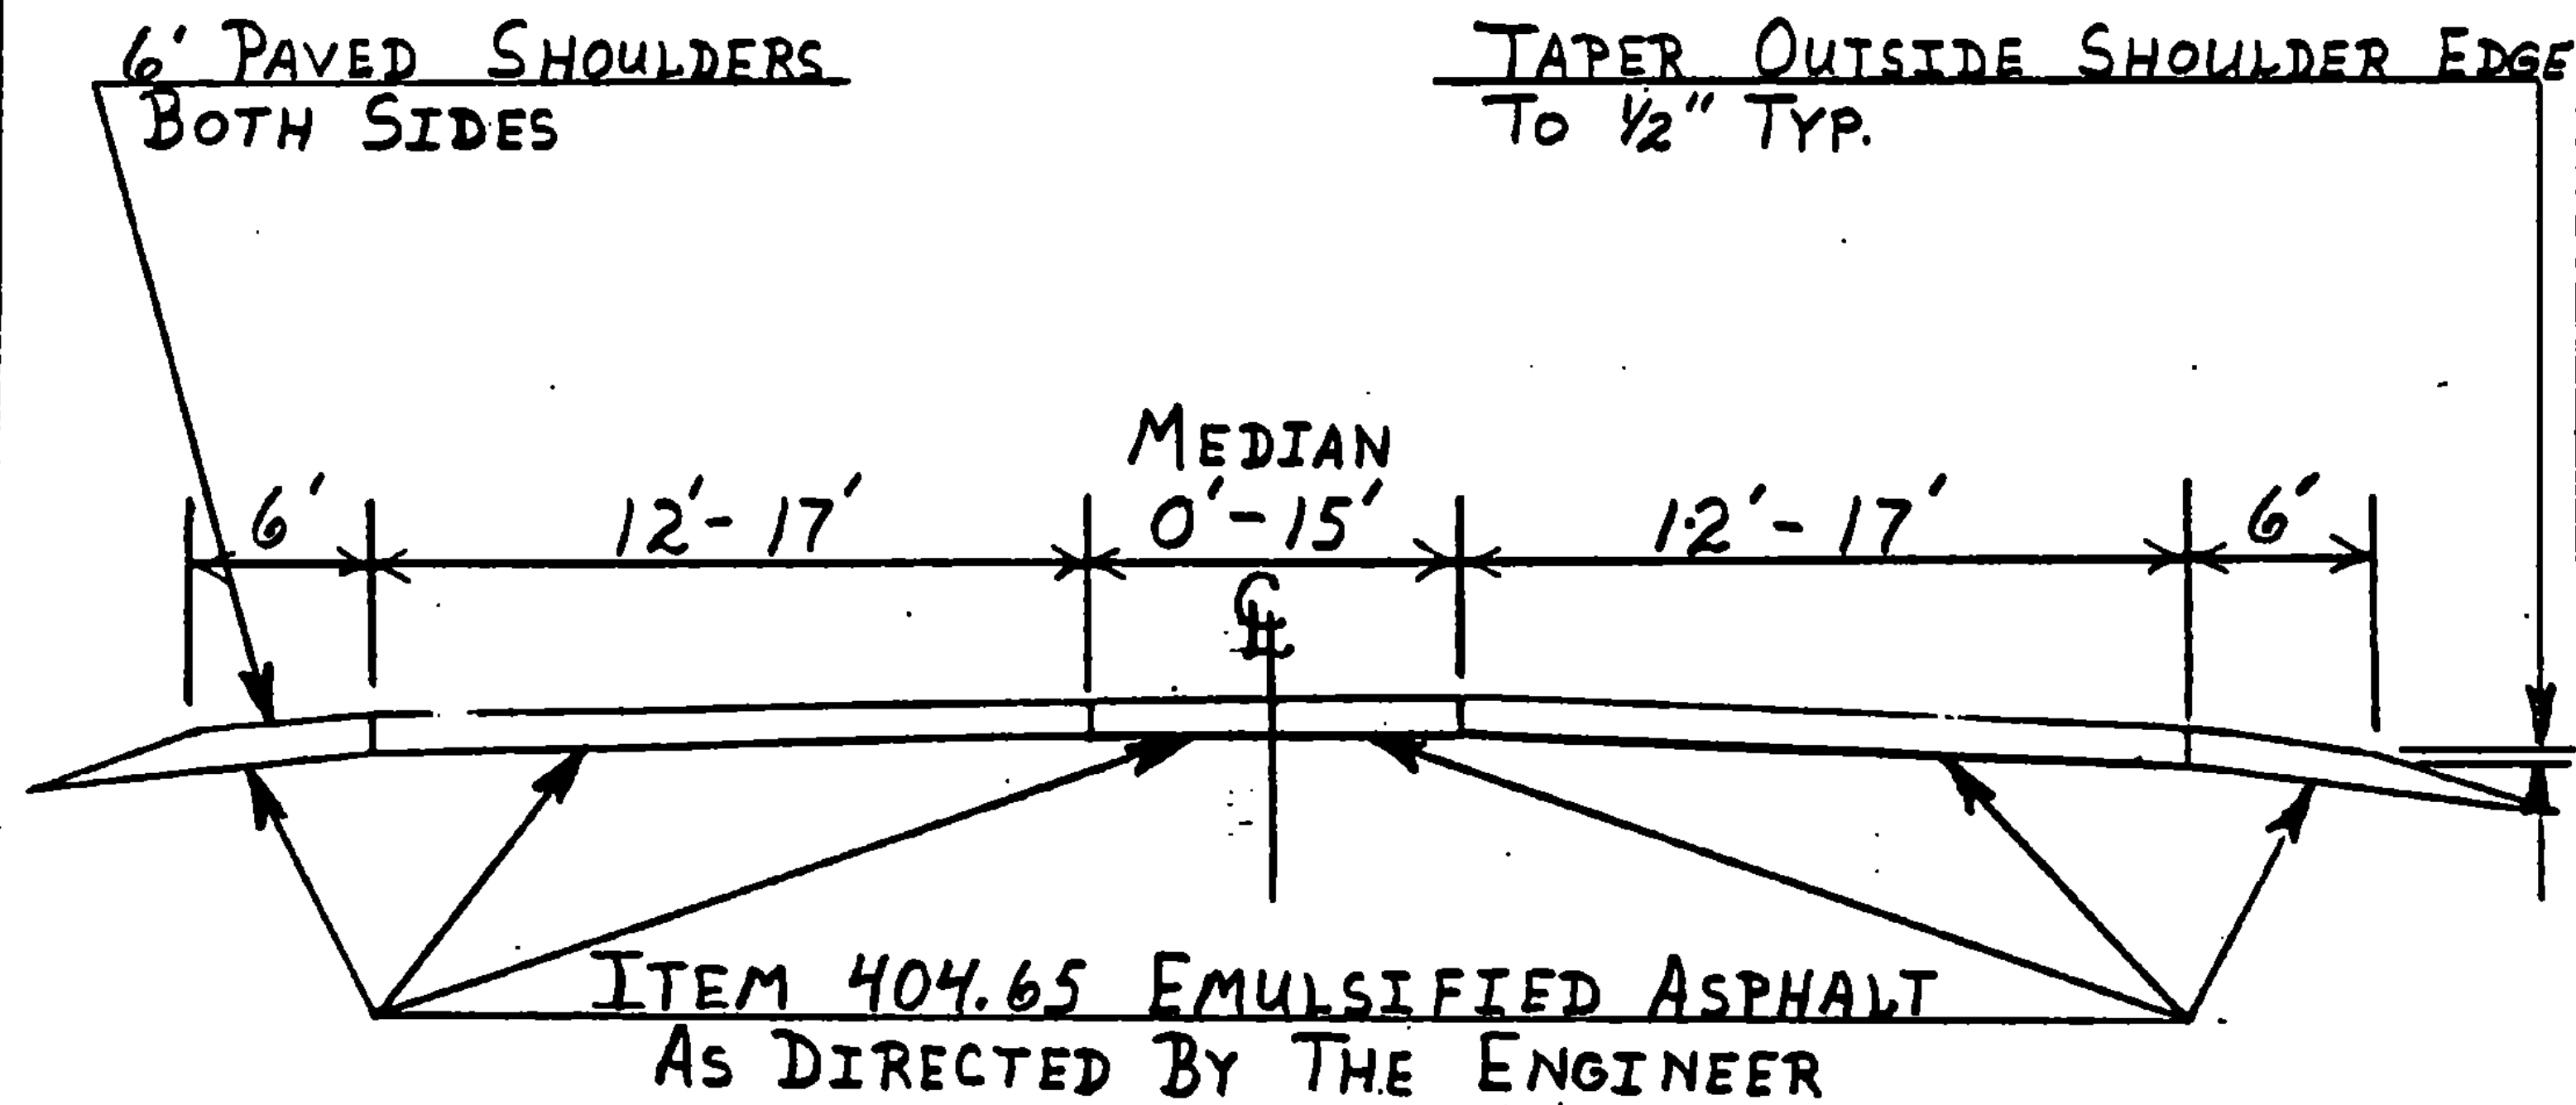

DISTANCE	WIDTH PAVED SHOULDER	WIDTH TRAVELED WAY	WIDTH PAVED MEDIAN	WIDTH PAVED SHOULDER	LEVEL TONNAGE/MILE
MM 0.97-1.06	6	34	0-15	6	472
MM 1.45-1.54	6	24	0-12	6	341
MM 1.69-1.76	6	24	0-12	6	341