


TYPICAL SECTIONS & DESIGN DATA

ITEM 406.25 BITUMINOUS CONCRETE PAVEMENT
LEVELING COURSE, TYPE III OR IV (50' WIDE @ 682 TONS) MI.)
AS DIRECTED BY THE ENGINEER
1" WEARING COURSE, TYPE III

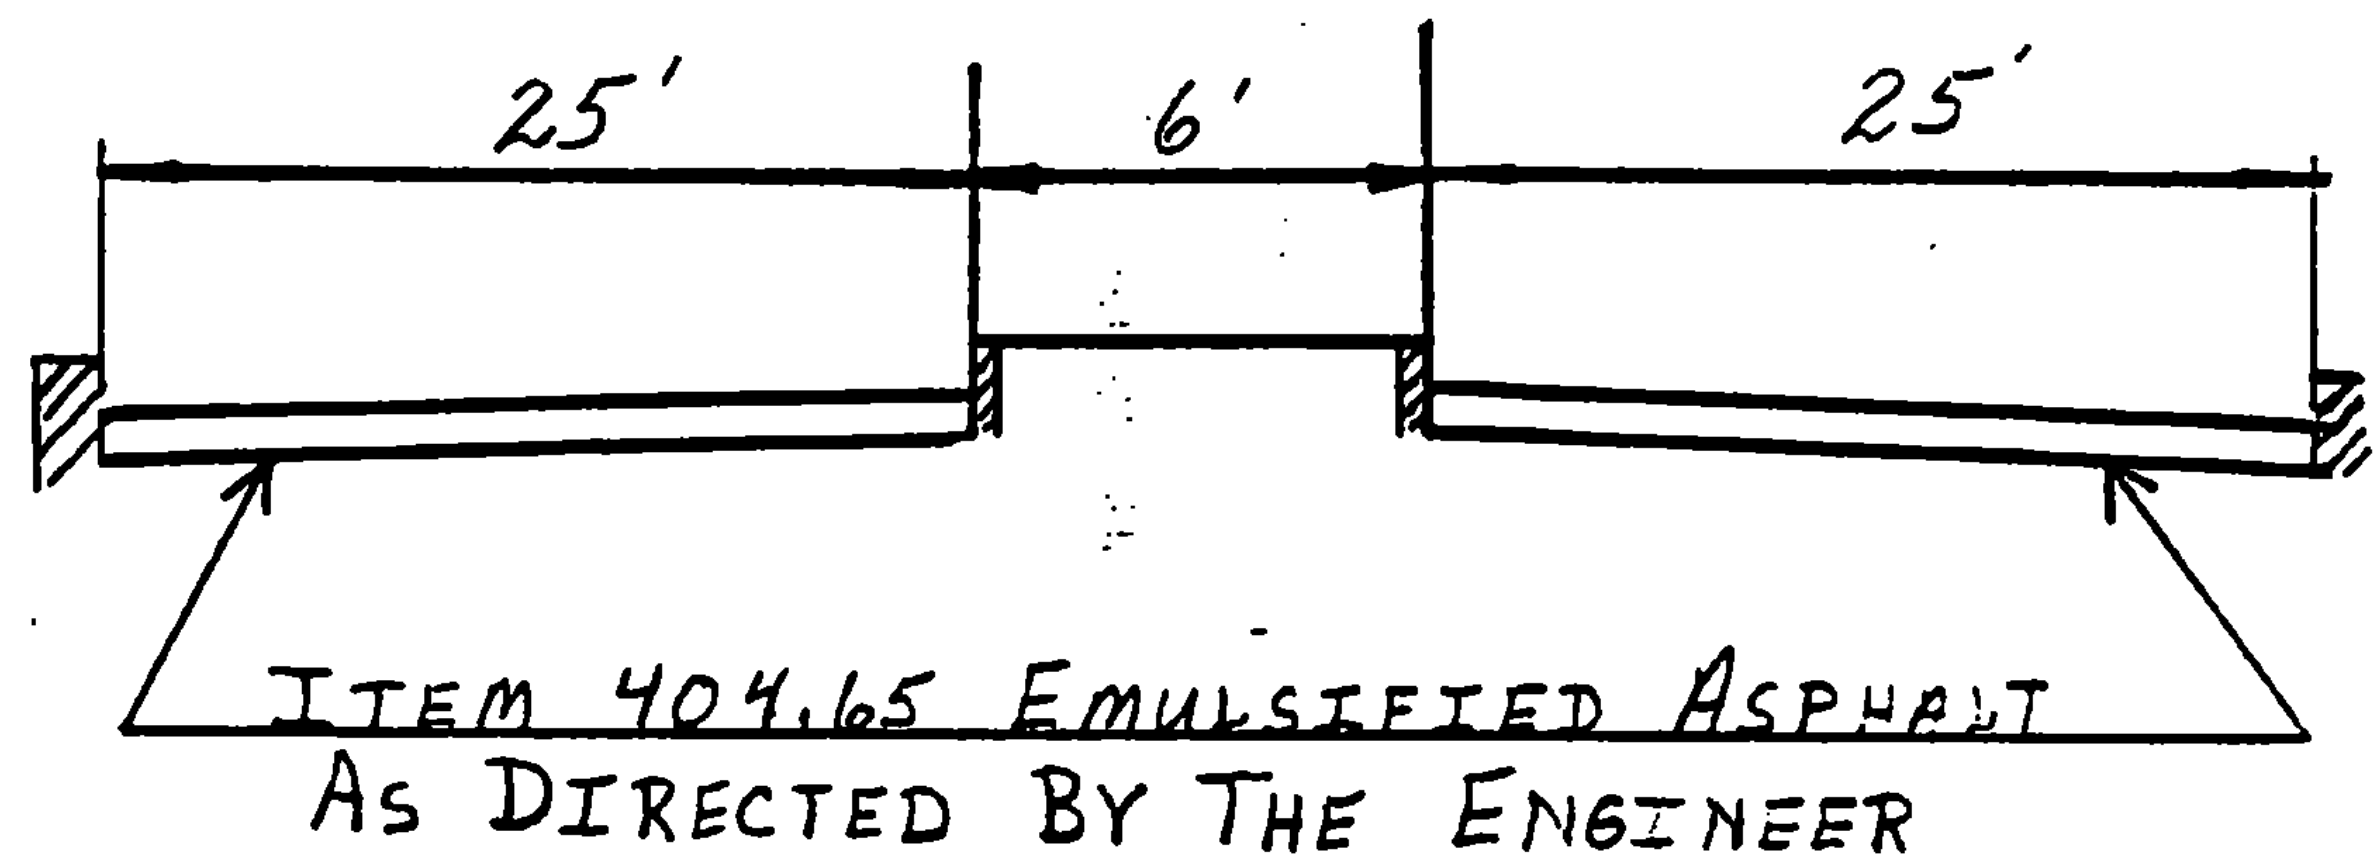

ST. ALBANS MM 0.221~0.316