


TYPICAL SECTIONS & DESIGN DATA

ITEM 406.25 BITUMINOUS CONCRETE PAVEMENT
LEVELING COURSE TYPE III OR IV (273 TONS/MILE)
AS DIRECTED BY THE ENGINEER
3/4" WEARING COURSE ($\pm 1/4$) TYPE IV

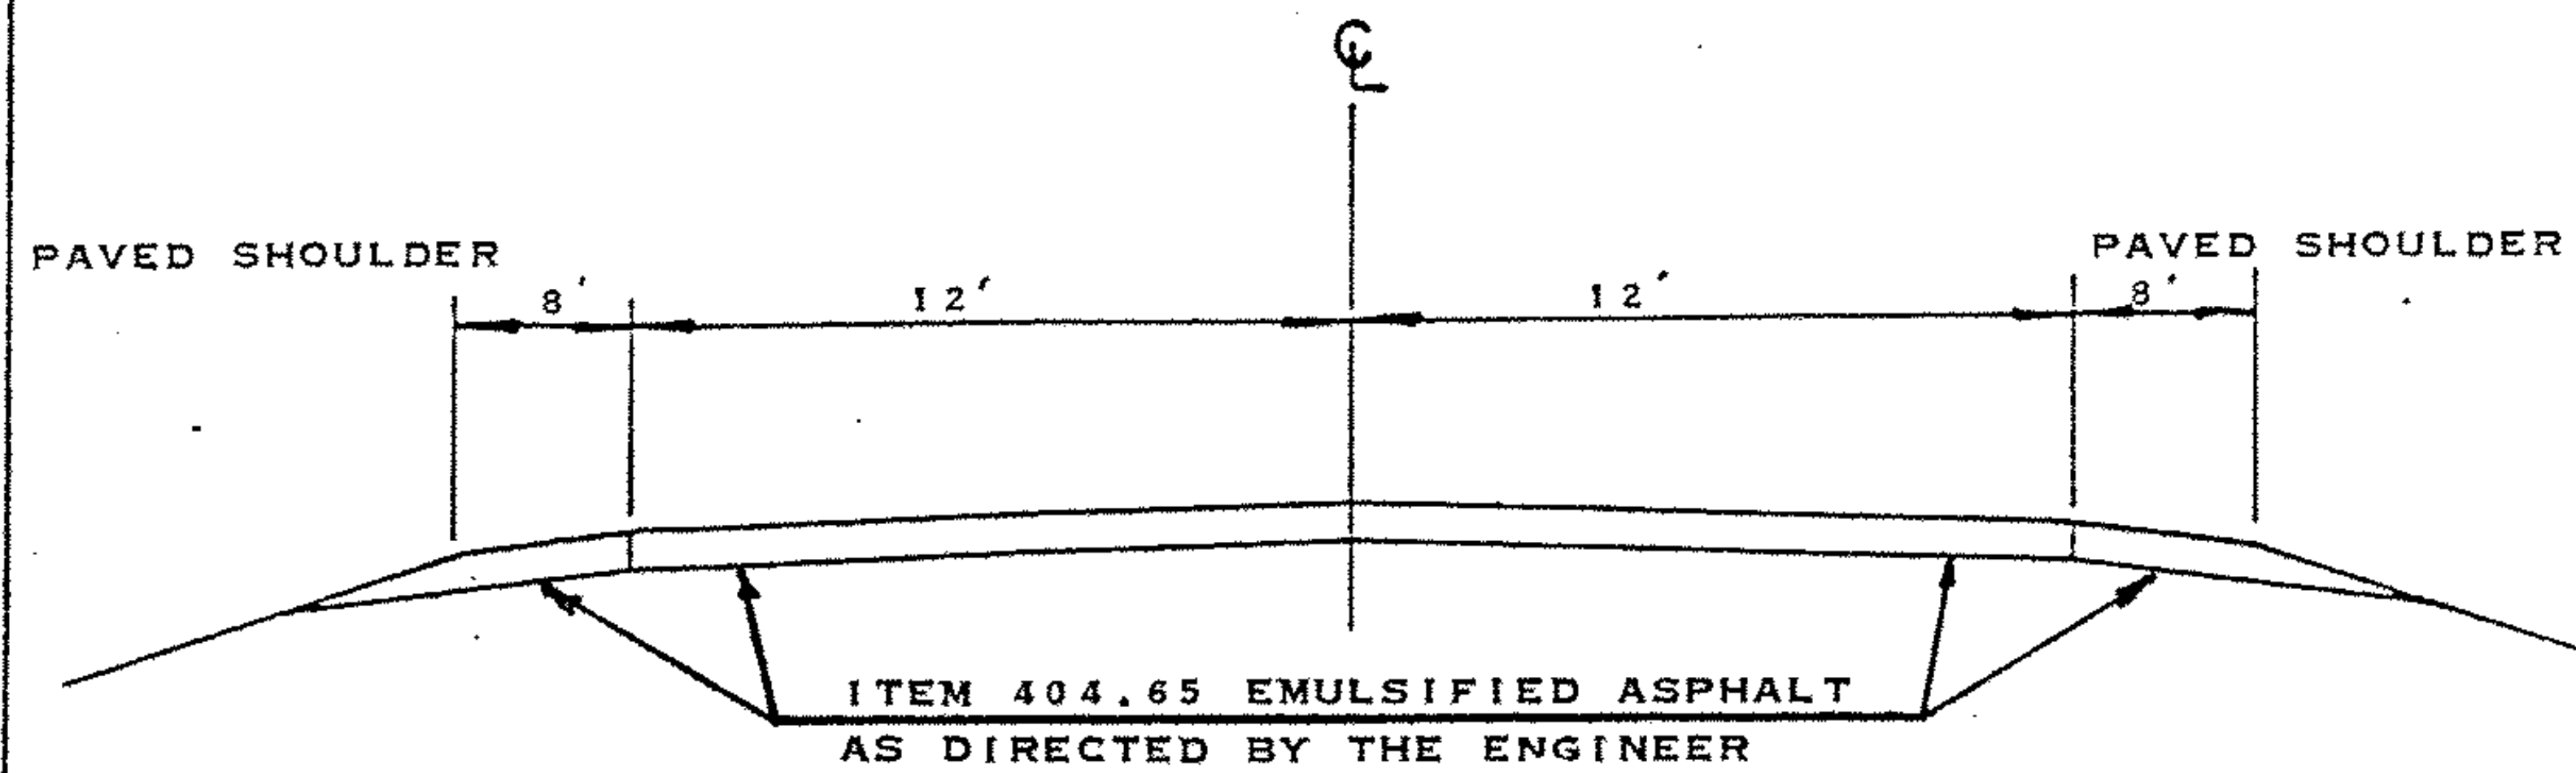

LUDLOW
MM 5.040 MM 5.191

1982 ADT 2060
V 50

Note: Topsoil, Item 653.10 to be applied as directed by the Engineer.
Seed, Fertilizer, Limestone and Mulch Items to be applied as required,
payment to be subsidiary to the Topsoil item.

PROJECT LUDLOW

NO. F 013-3(3)S

SHEET 5 OF 21 SHEETS