


PROJECT DESCRIPTION AND LOCATION

BRIDGE No. 103
 MM 0.081
 TOP COURSE ONLY
 END PROJECT
 MM 0.438
 PLYMOUTH

BEGIN PROJECT
 MM 5.191

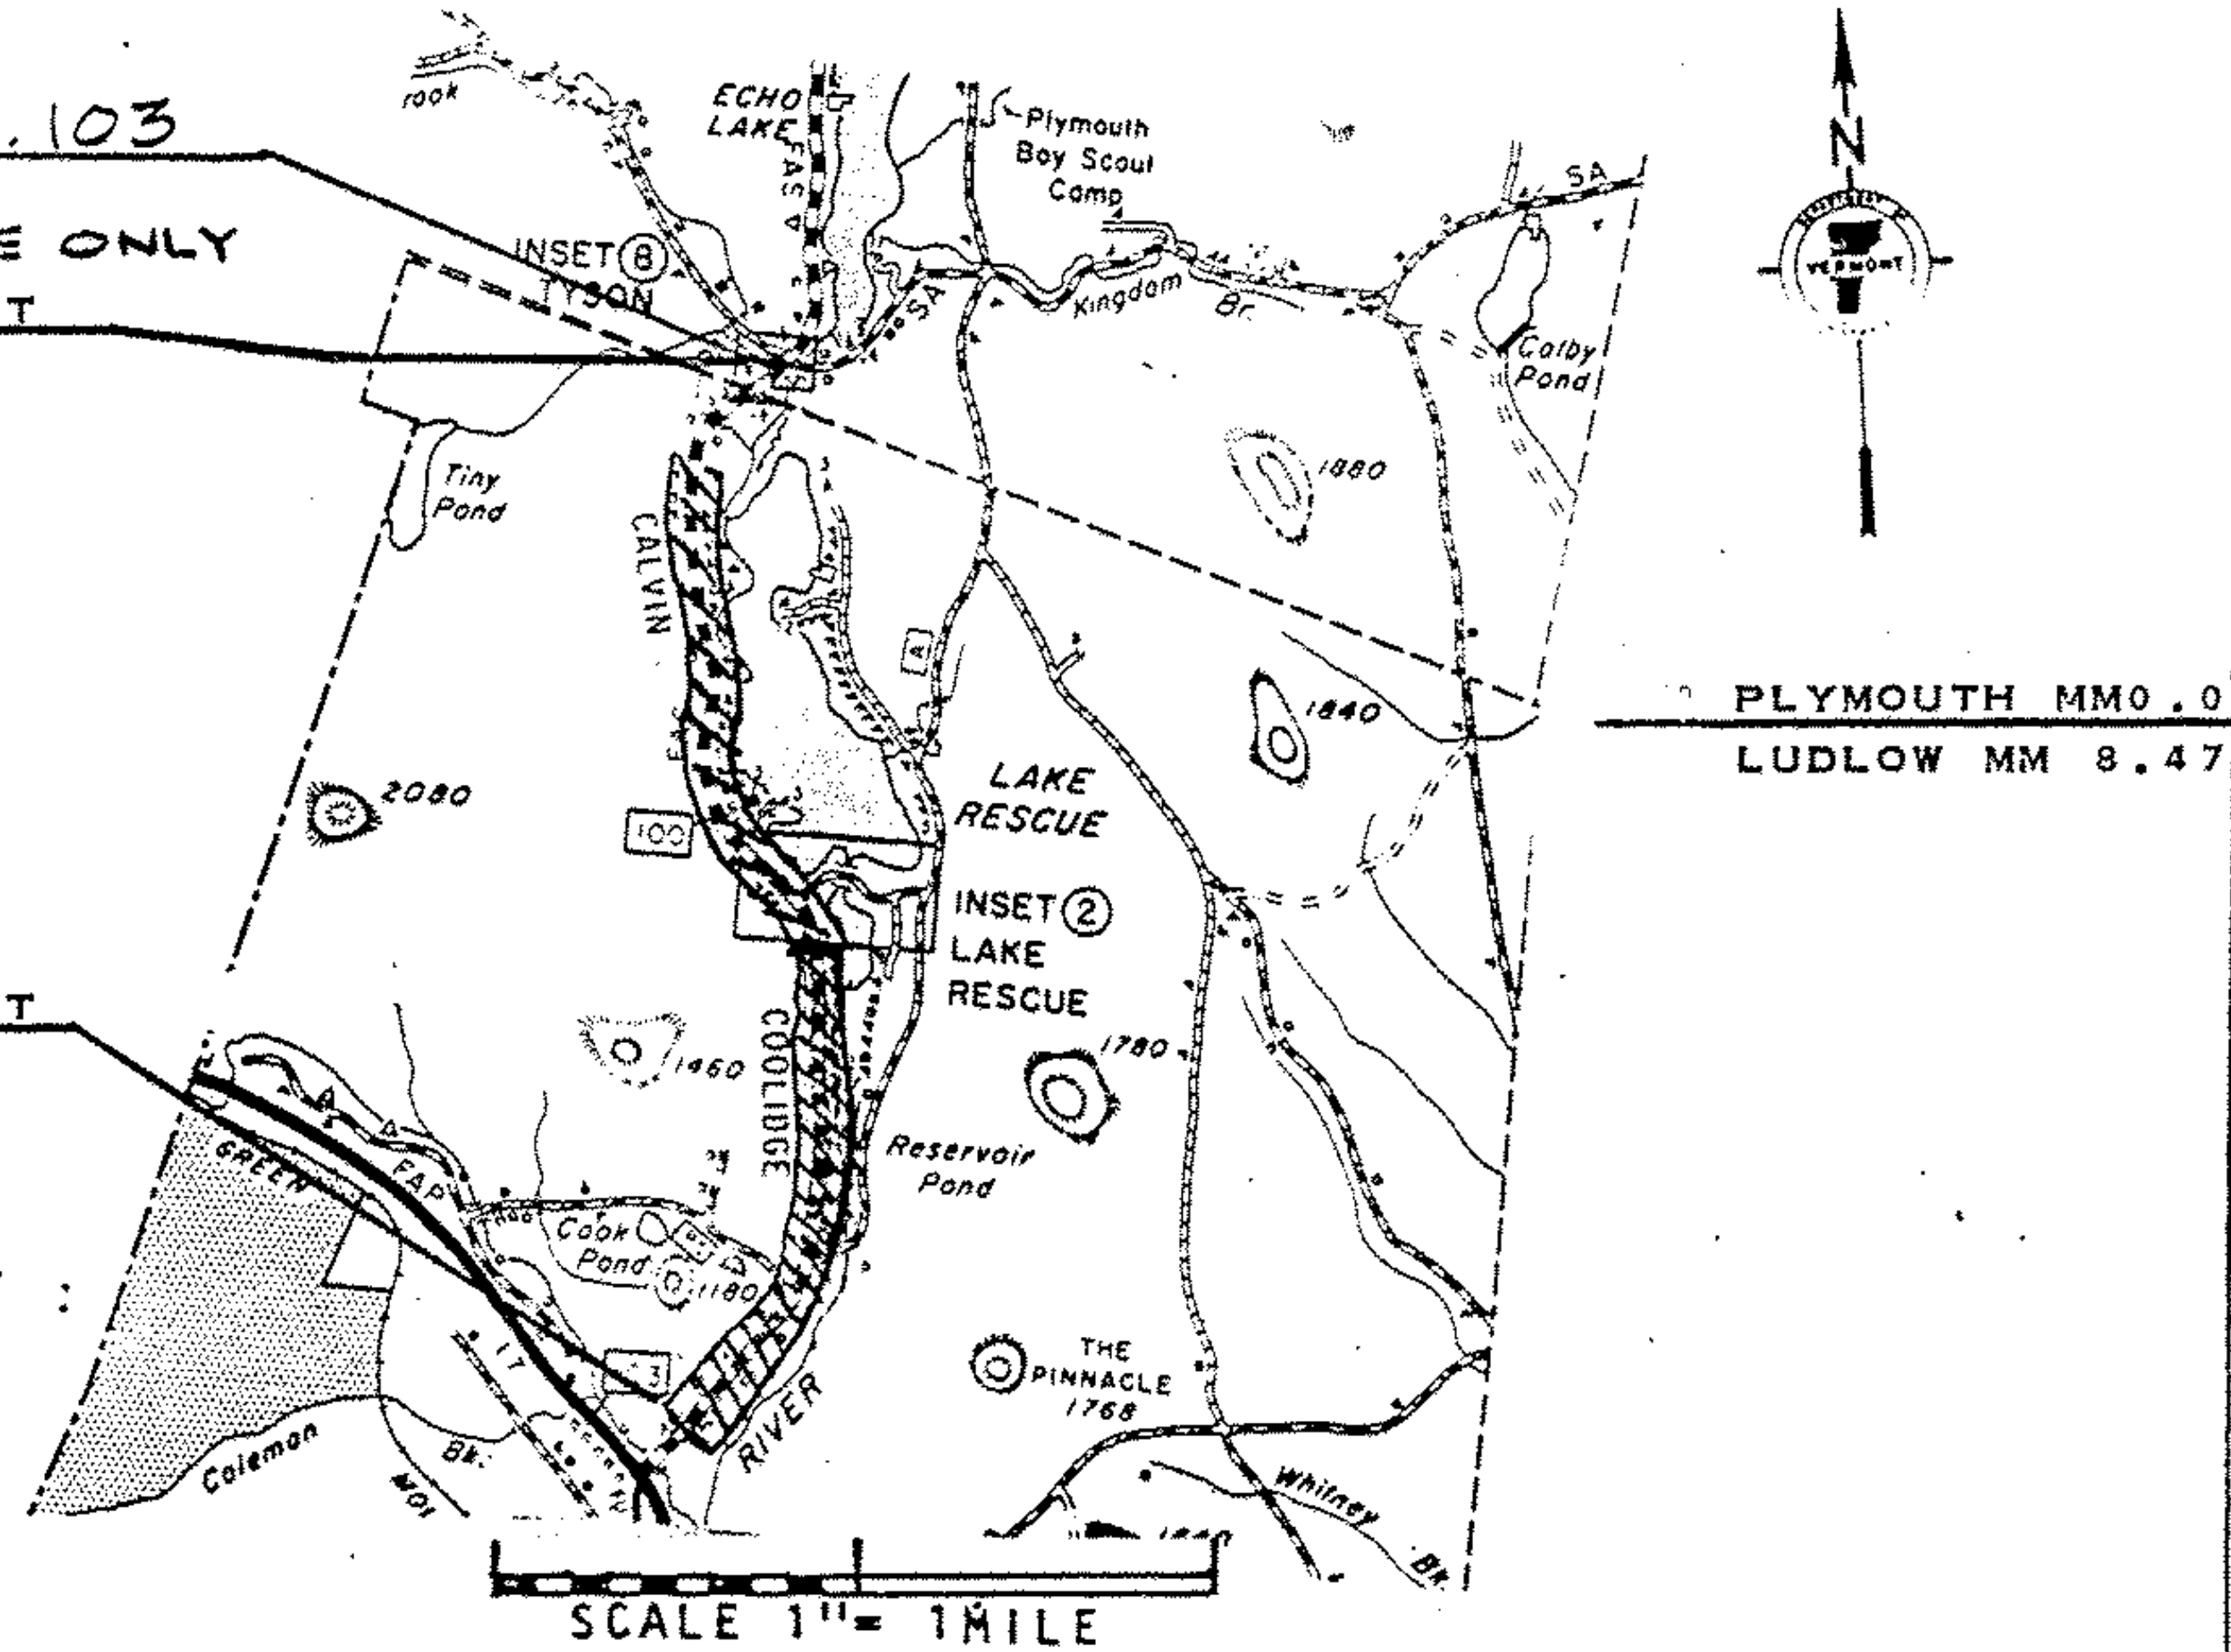

VT 100 BEGINNING IN THE TOWN OF LUDLOW AT MM 5.191 AND EXTENDING 3.418 MILES TO MM 0.138 IN THE TOWN OF PLYMOUTH

LENGTH OF PROJECT
 3.418 MILES
 18047 FEET

PROJECT LUDLOW_PLYMOUTH

NO. HMC 2631

SHEET 10 OF 21 SHEETS