


# TYPICAL SECTIONS & DESIGN DATA

ITEM 406.25 BITUMINOUS CONCRETE PAVEMENT  
LEVELING COURSE TYPE III OT IV (250 TONS/MILE)  
AS DIRECTED BY THE ENGINEER  
3/4" WEARING COURSE (1/4) TYPE IV

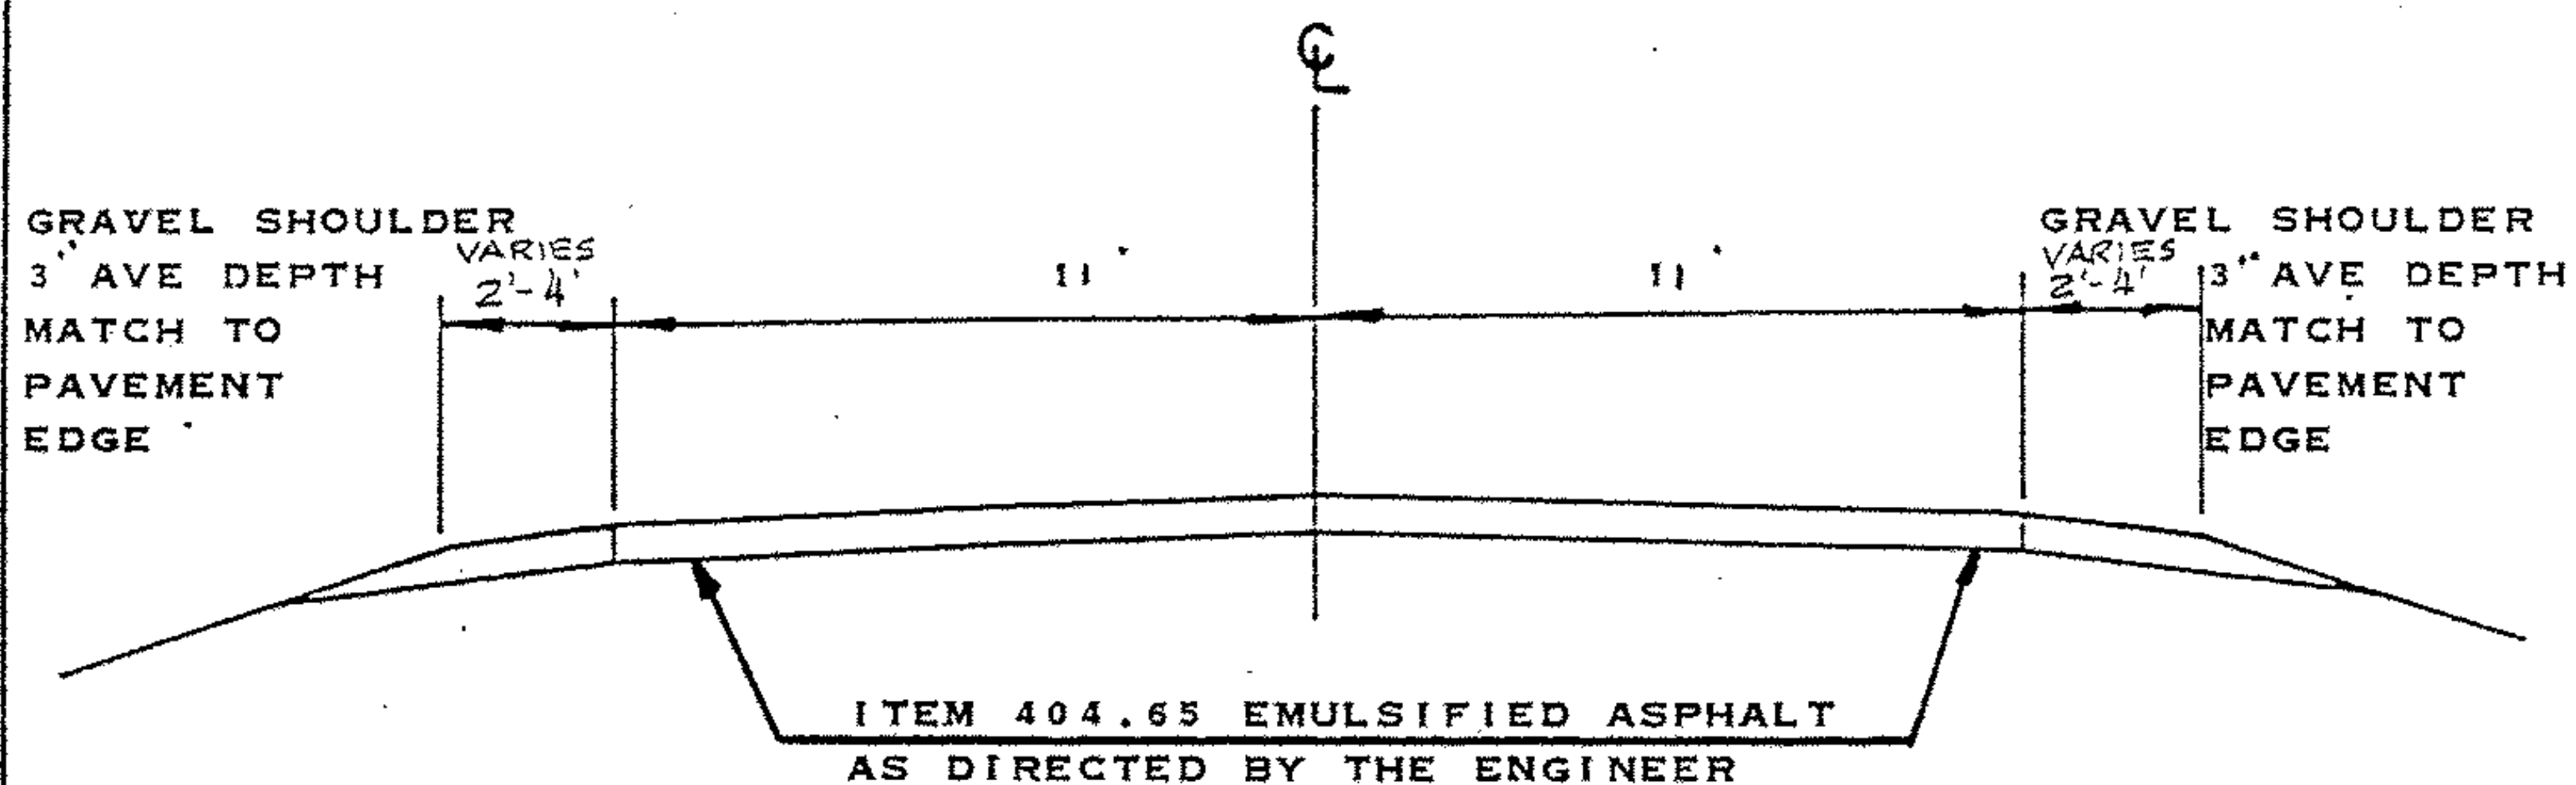

LUDLOW  
MM 6.840 MM 0.138

1982 ADT 1580  
V 50

Note: Topsoil, Item 653.10 to be applied as directed by the Engineer.  
Seed, Fertilizer, Limestone and Mulch Items to be applied as required,  
payment to be subsidiary to the Topsoil item.

PROJECT LUDLOW - PLYMOUTH

NO. HMA 2631

SHEET IIA OF 21 SHEETS