


TYPICAL SECTIONS & DESIGN DATA

ITEM 406.25 BITUMINOUS CONCRETE PAVEMENT
LEVELING COURSE TYPE III OR IV
AS DIRECTED BY THE ENGINEER
MM 2.882 ~ 3.535 (24' WIDE @ 218 TONS / MI.)
MM 4.953 ~ 5.760 + MM 5.970 ~ 9.939 (24' WIDE @ 327 TONS / MI.)
3/4" WEARING COURSE, TYPE IV

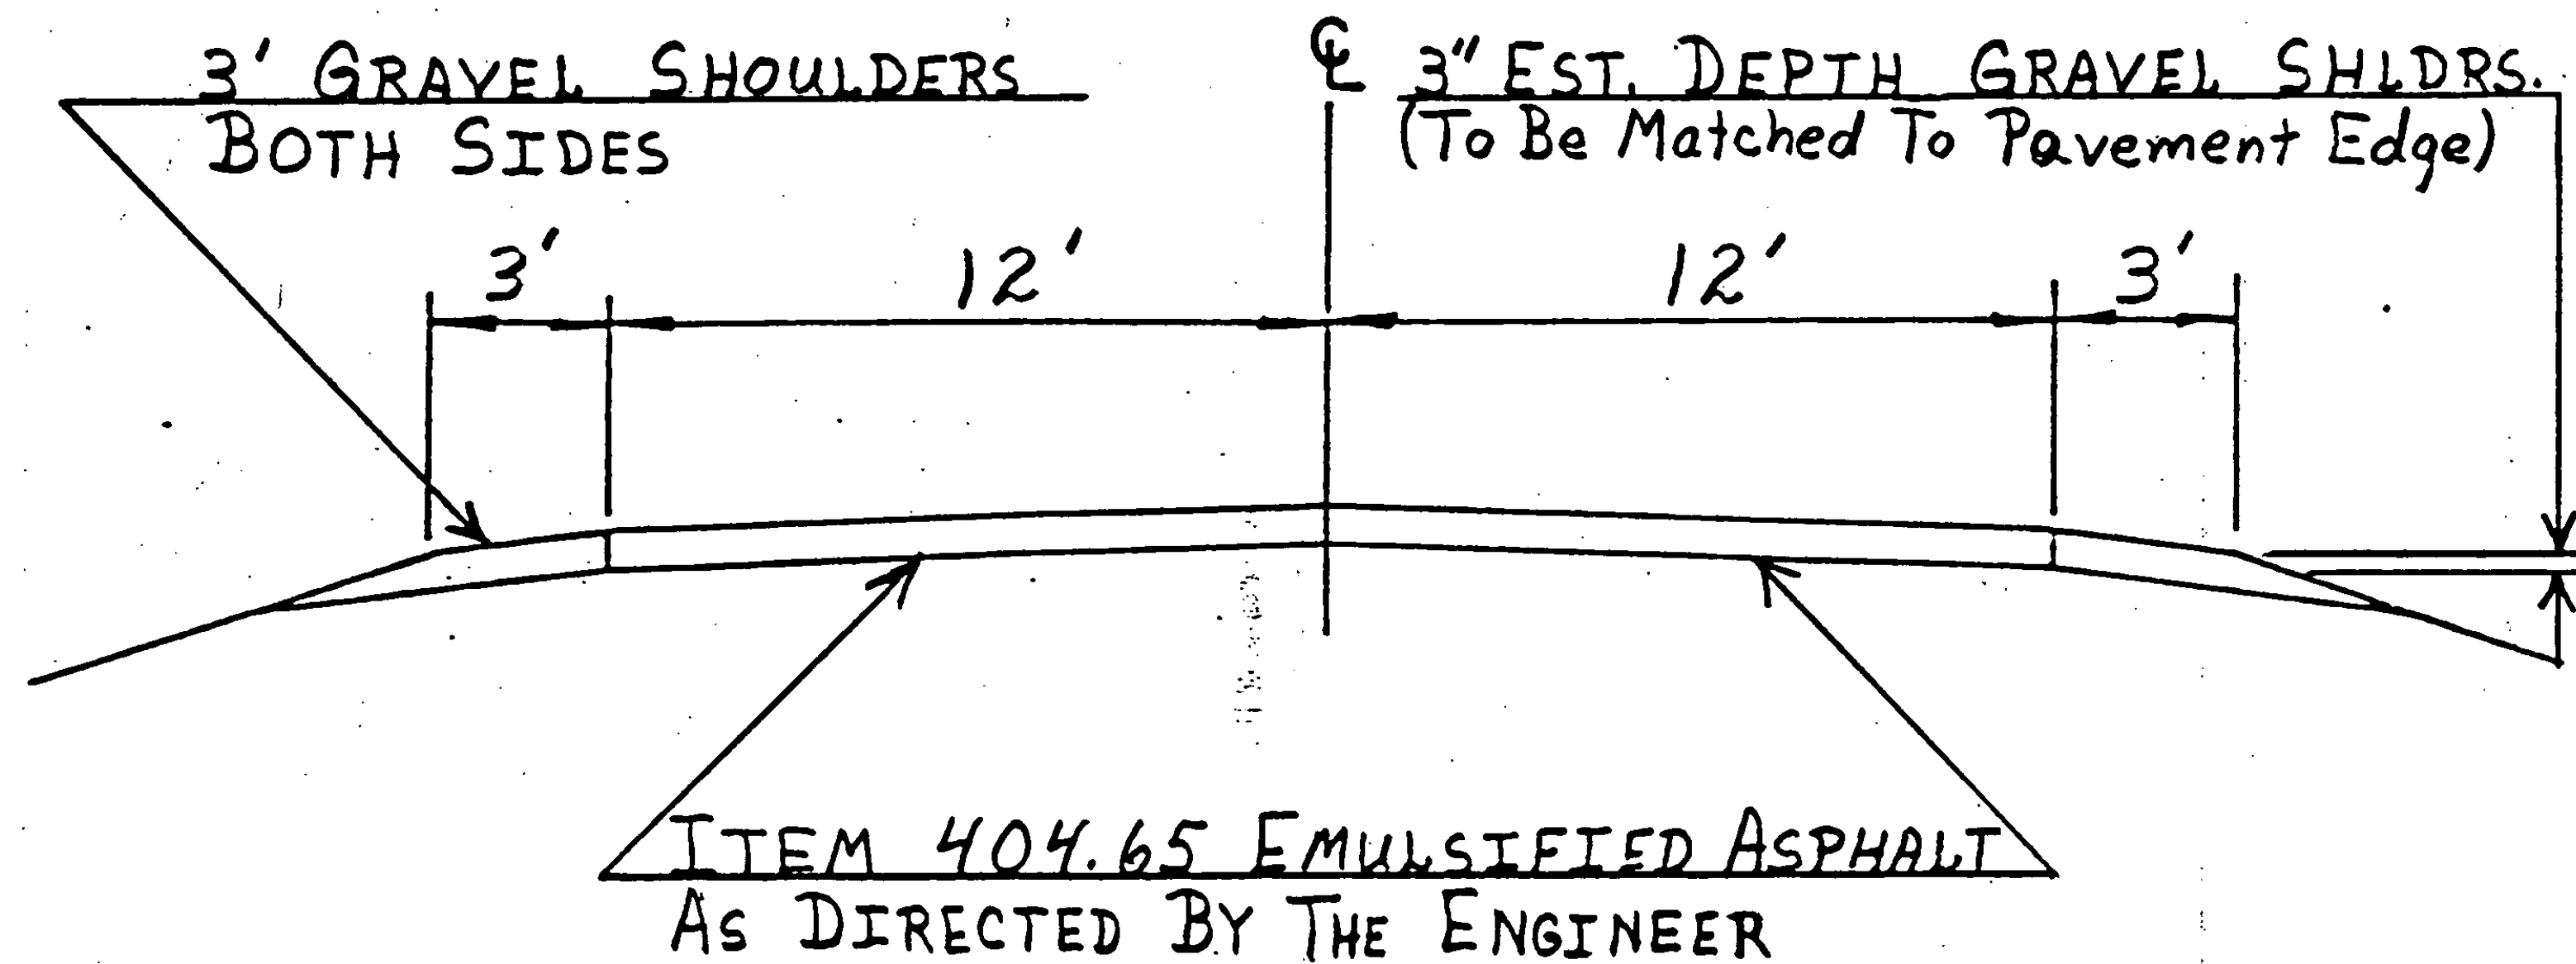

BARNET
SEGMENT 1 MM 2.882 ~ 3.535
SEGMENT 2 MM 4.953 ~ 5.760 + 5.970 ~ 9.939

TRAFFIC DATA
1982 ADT 815
V = 50 MPH