


TYPICAL SECTIONS & DESIGN DATA

ITEM 406.25 BITUMINOUS CONCRETE PAVEMENT
LEVELING COURSE, TYPE III OR IV (24' WIDE @ 32.7 TONS/IN.)
AS DIRECTED BY THE ENGINEER
3/4" WEARING COURSE, TYPE IV

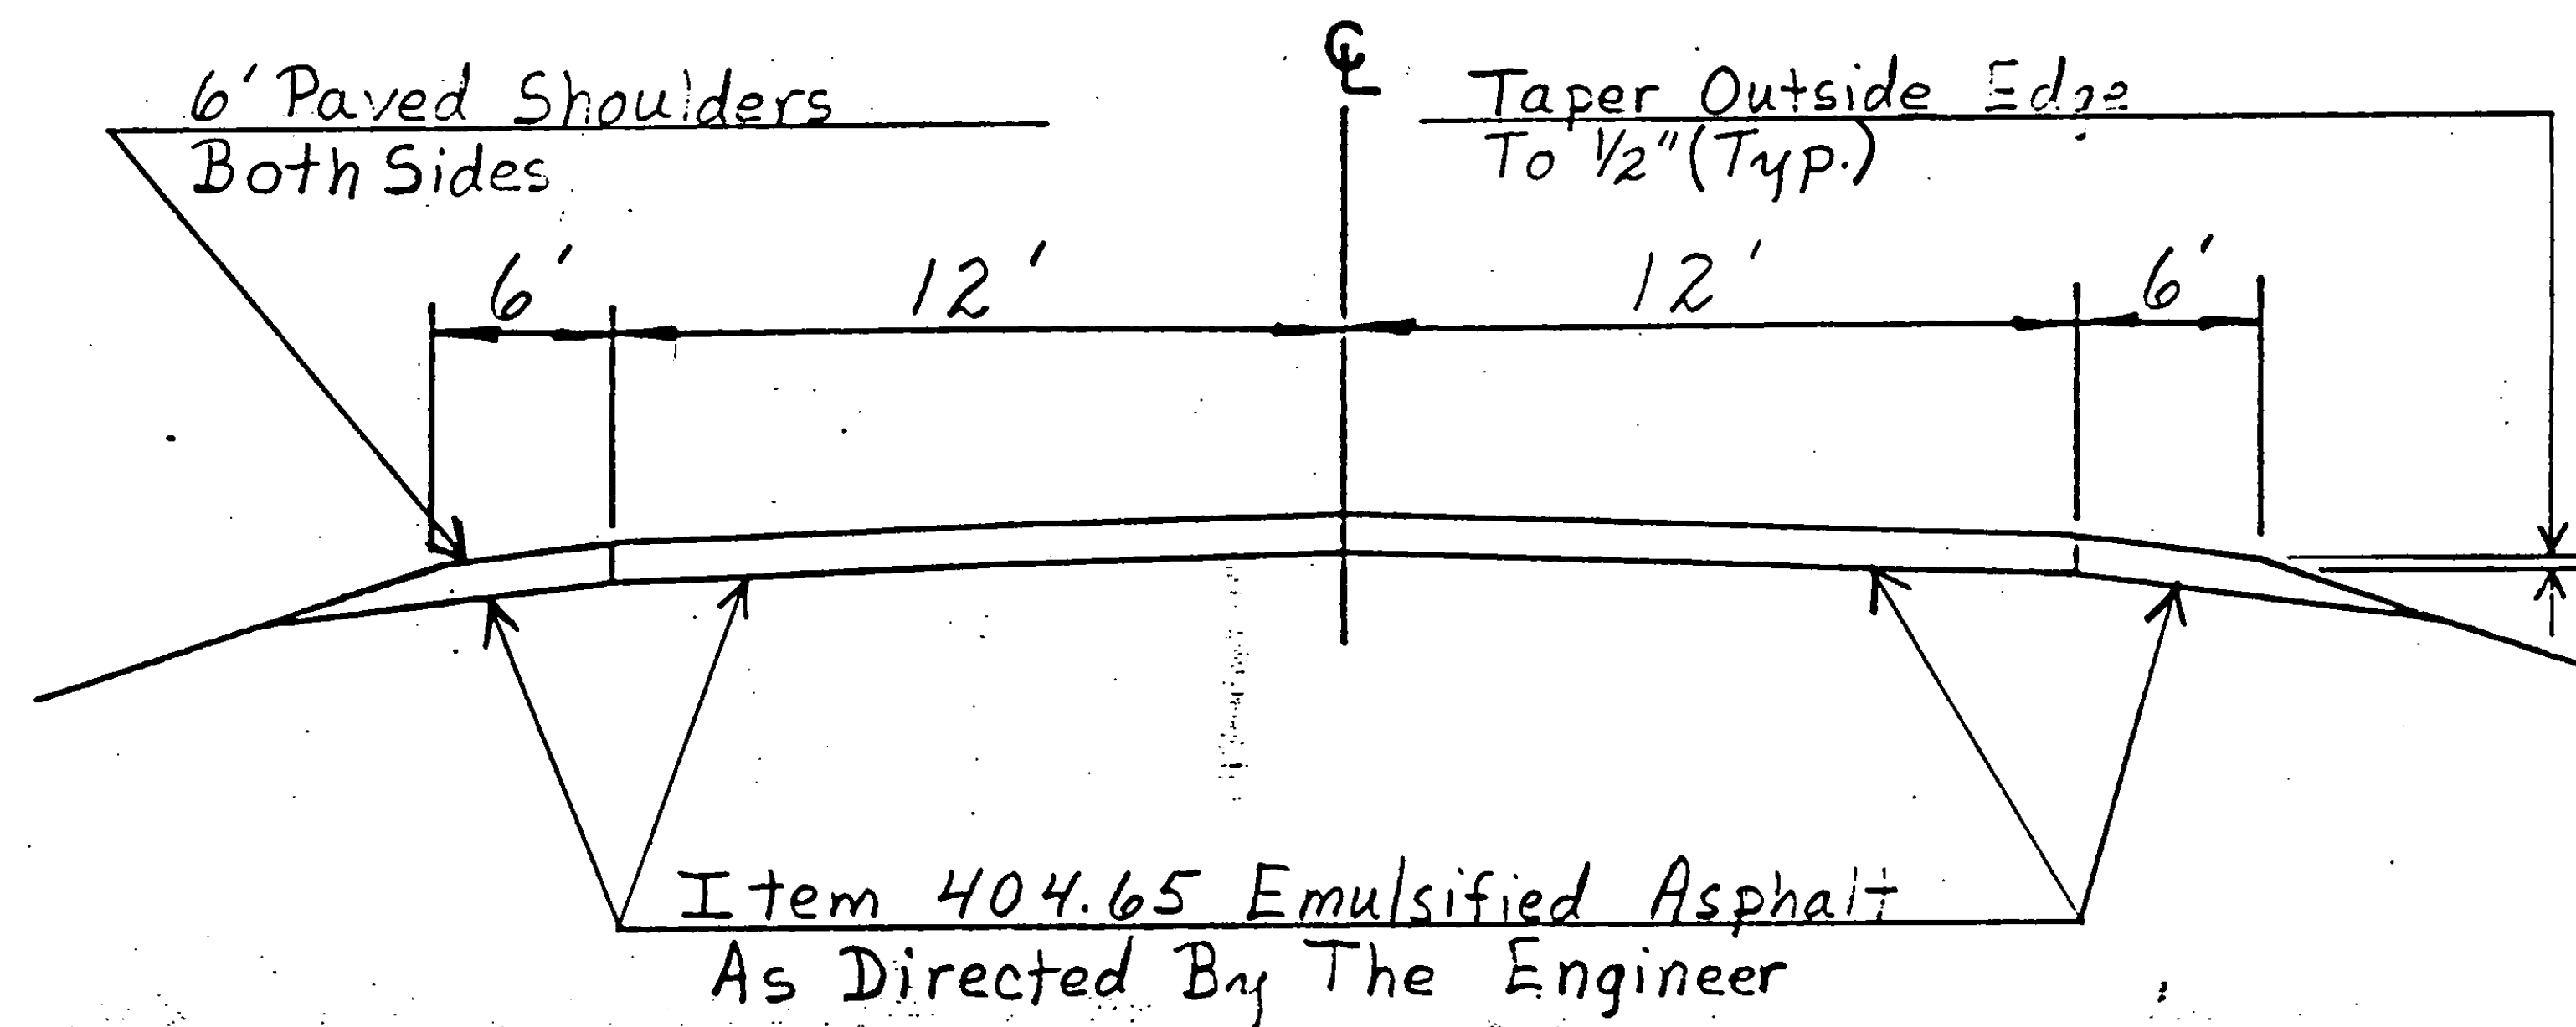

BARNET

SEGMENT 2 MM 5.760~5.970

TRAFFIC DATA

1982 ADT 650

V=50 MPH

PROJECT Barnet

NO. RS 0113(41)

SHEET 4A OF 13 SHEETS