


DETAILS

With Signal

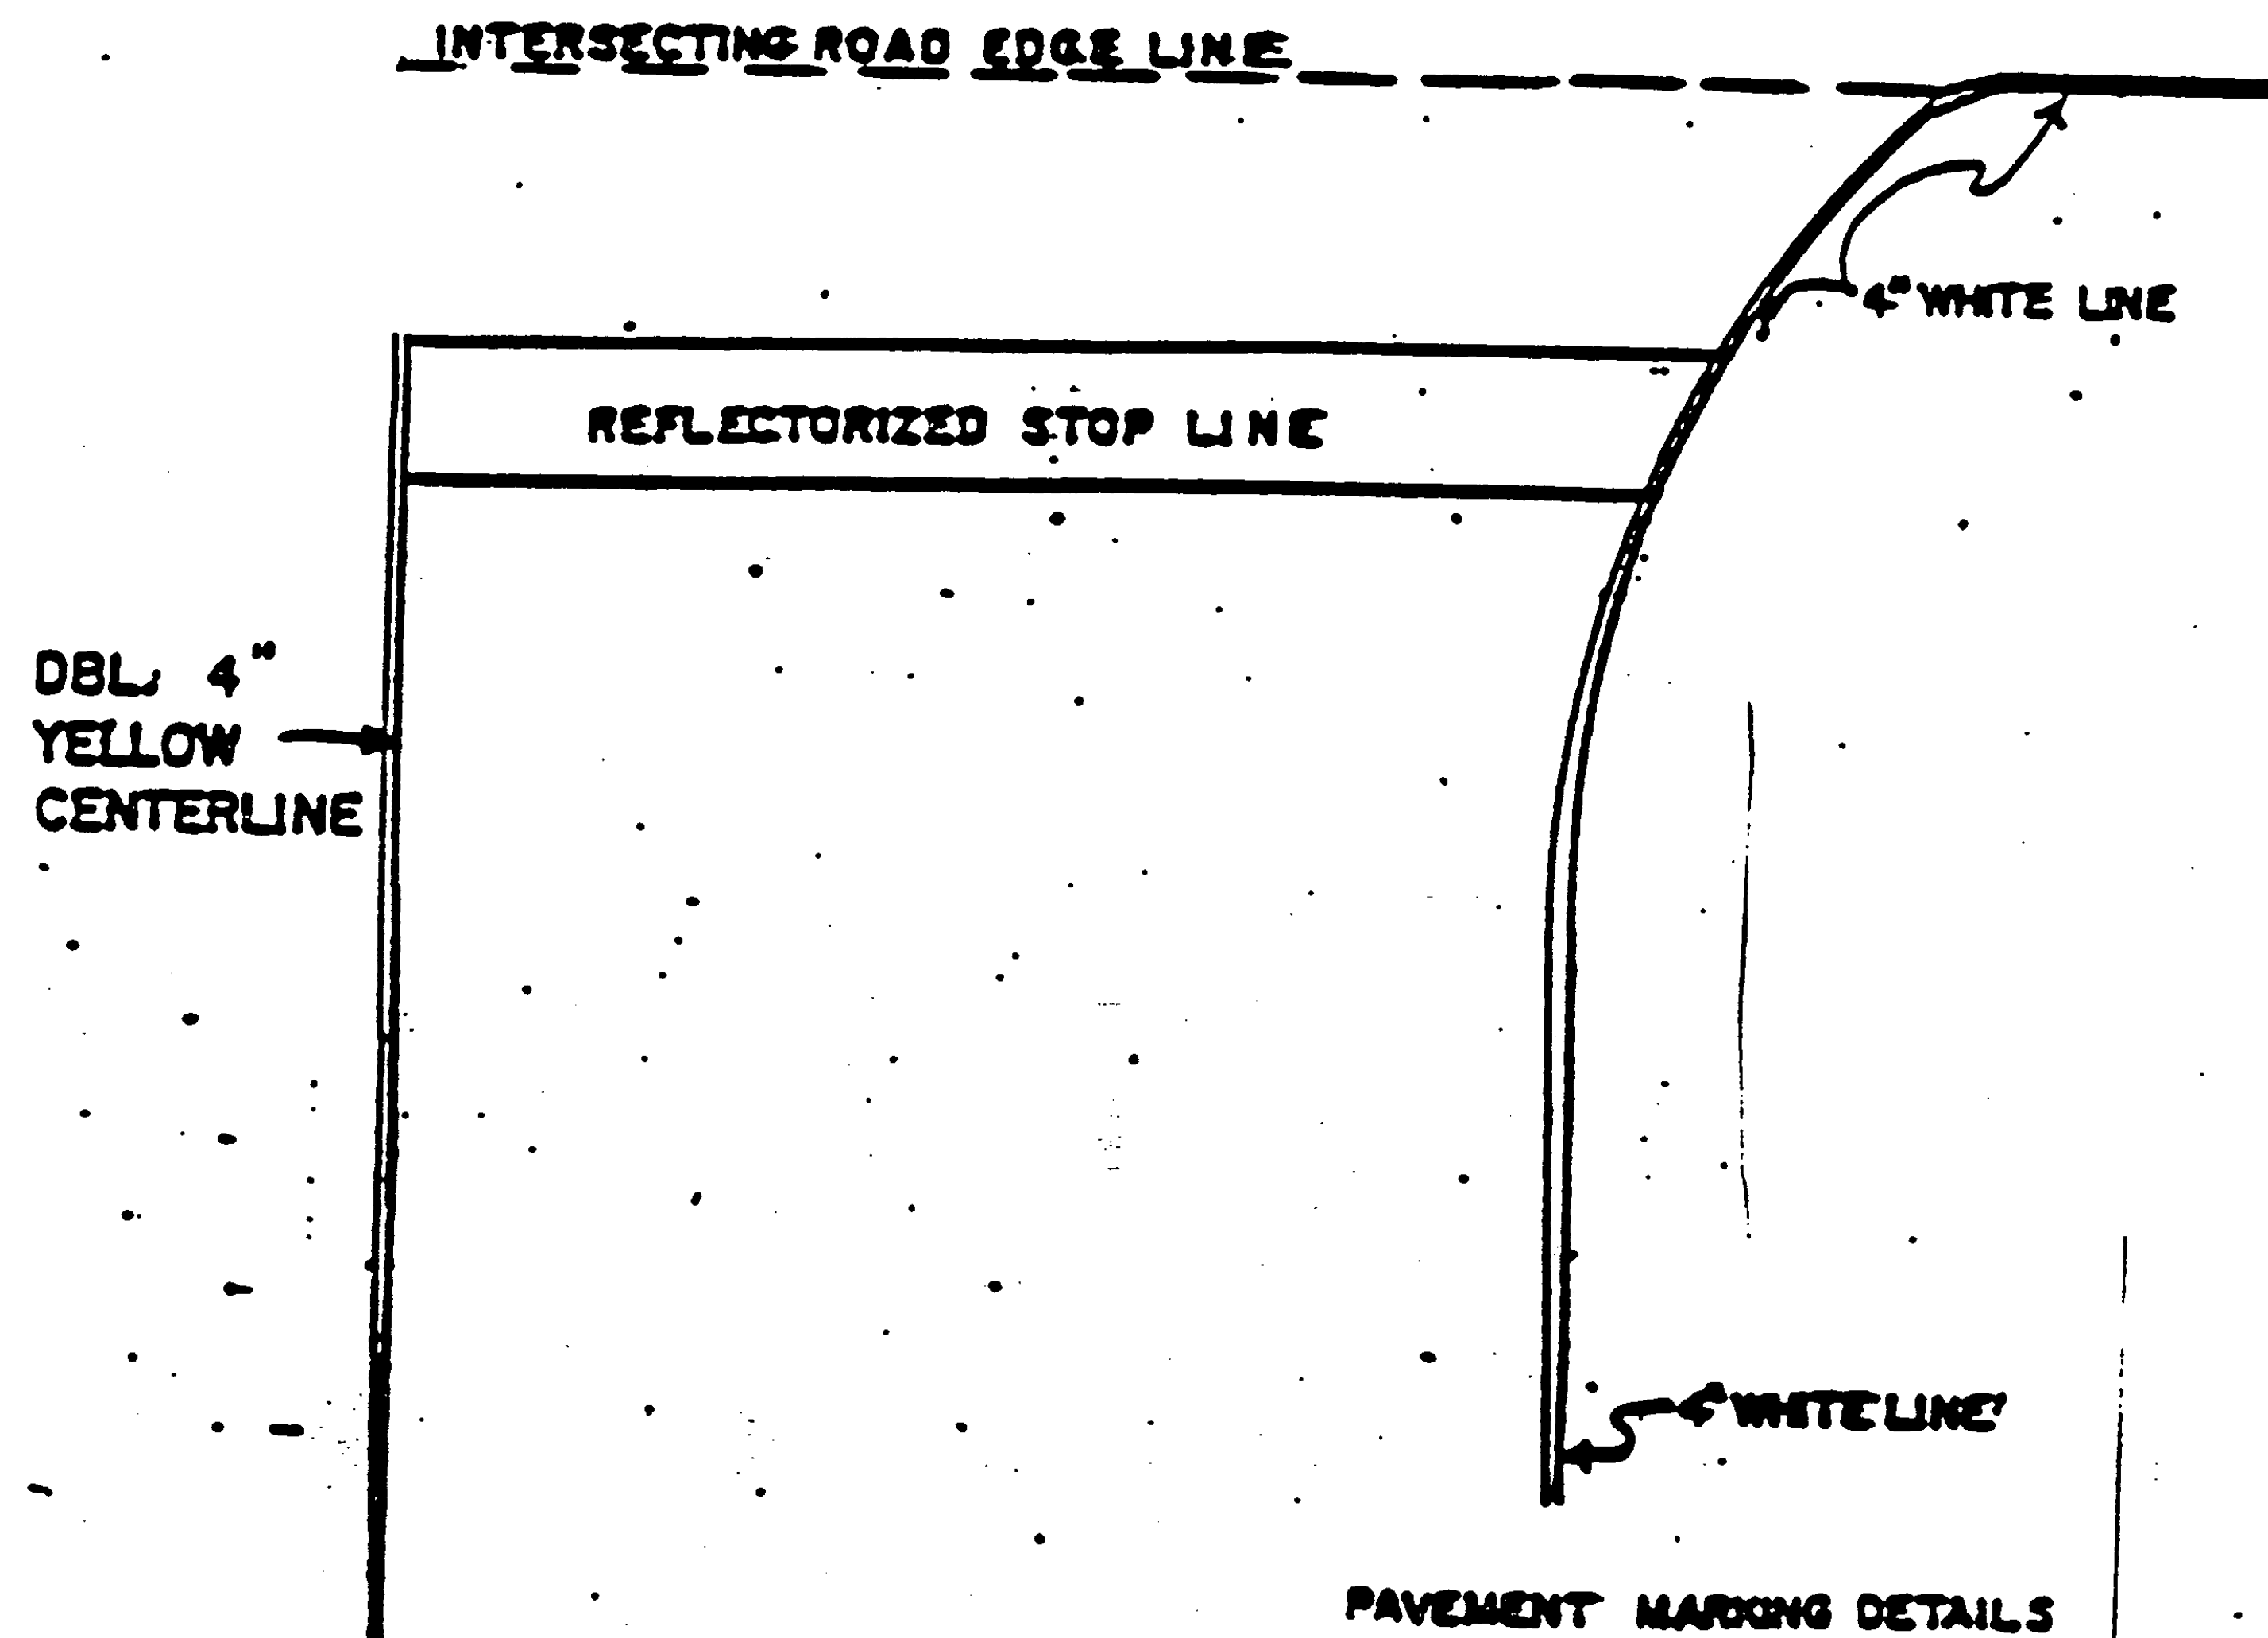

NOTE :

THE STOP BAR SHALL BE PLACED
A MINIMUM OF 40' FROM THE
NEAREST TRAFFIC SIGNAL.

PROJECT BRATTLEBORD

NQ m2000 (12) S, F010-2(1) S

SHEET 9 OF 23 SHEETS