


PROJECT DESCRIPTION AND LOCATION

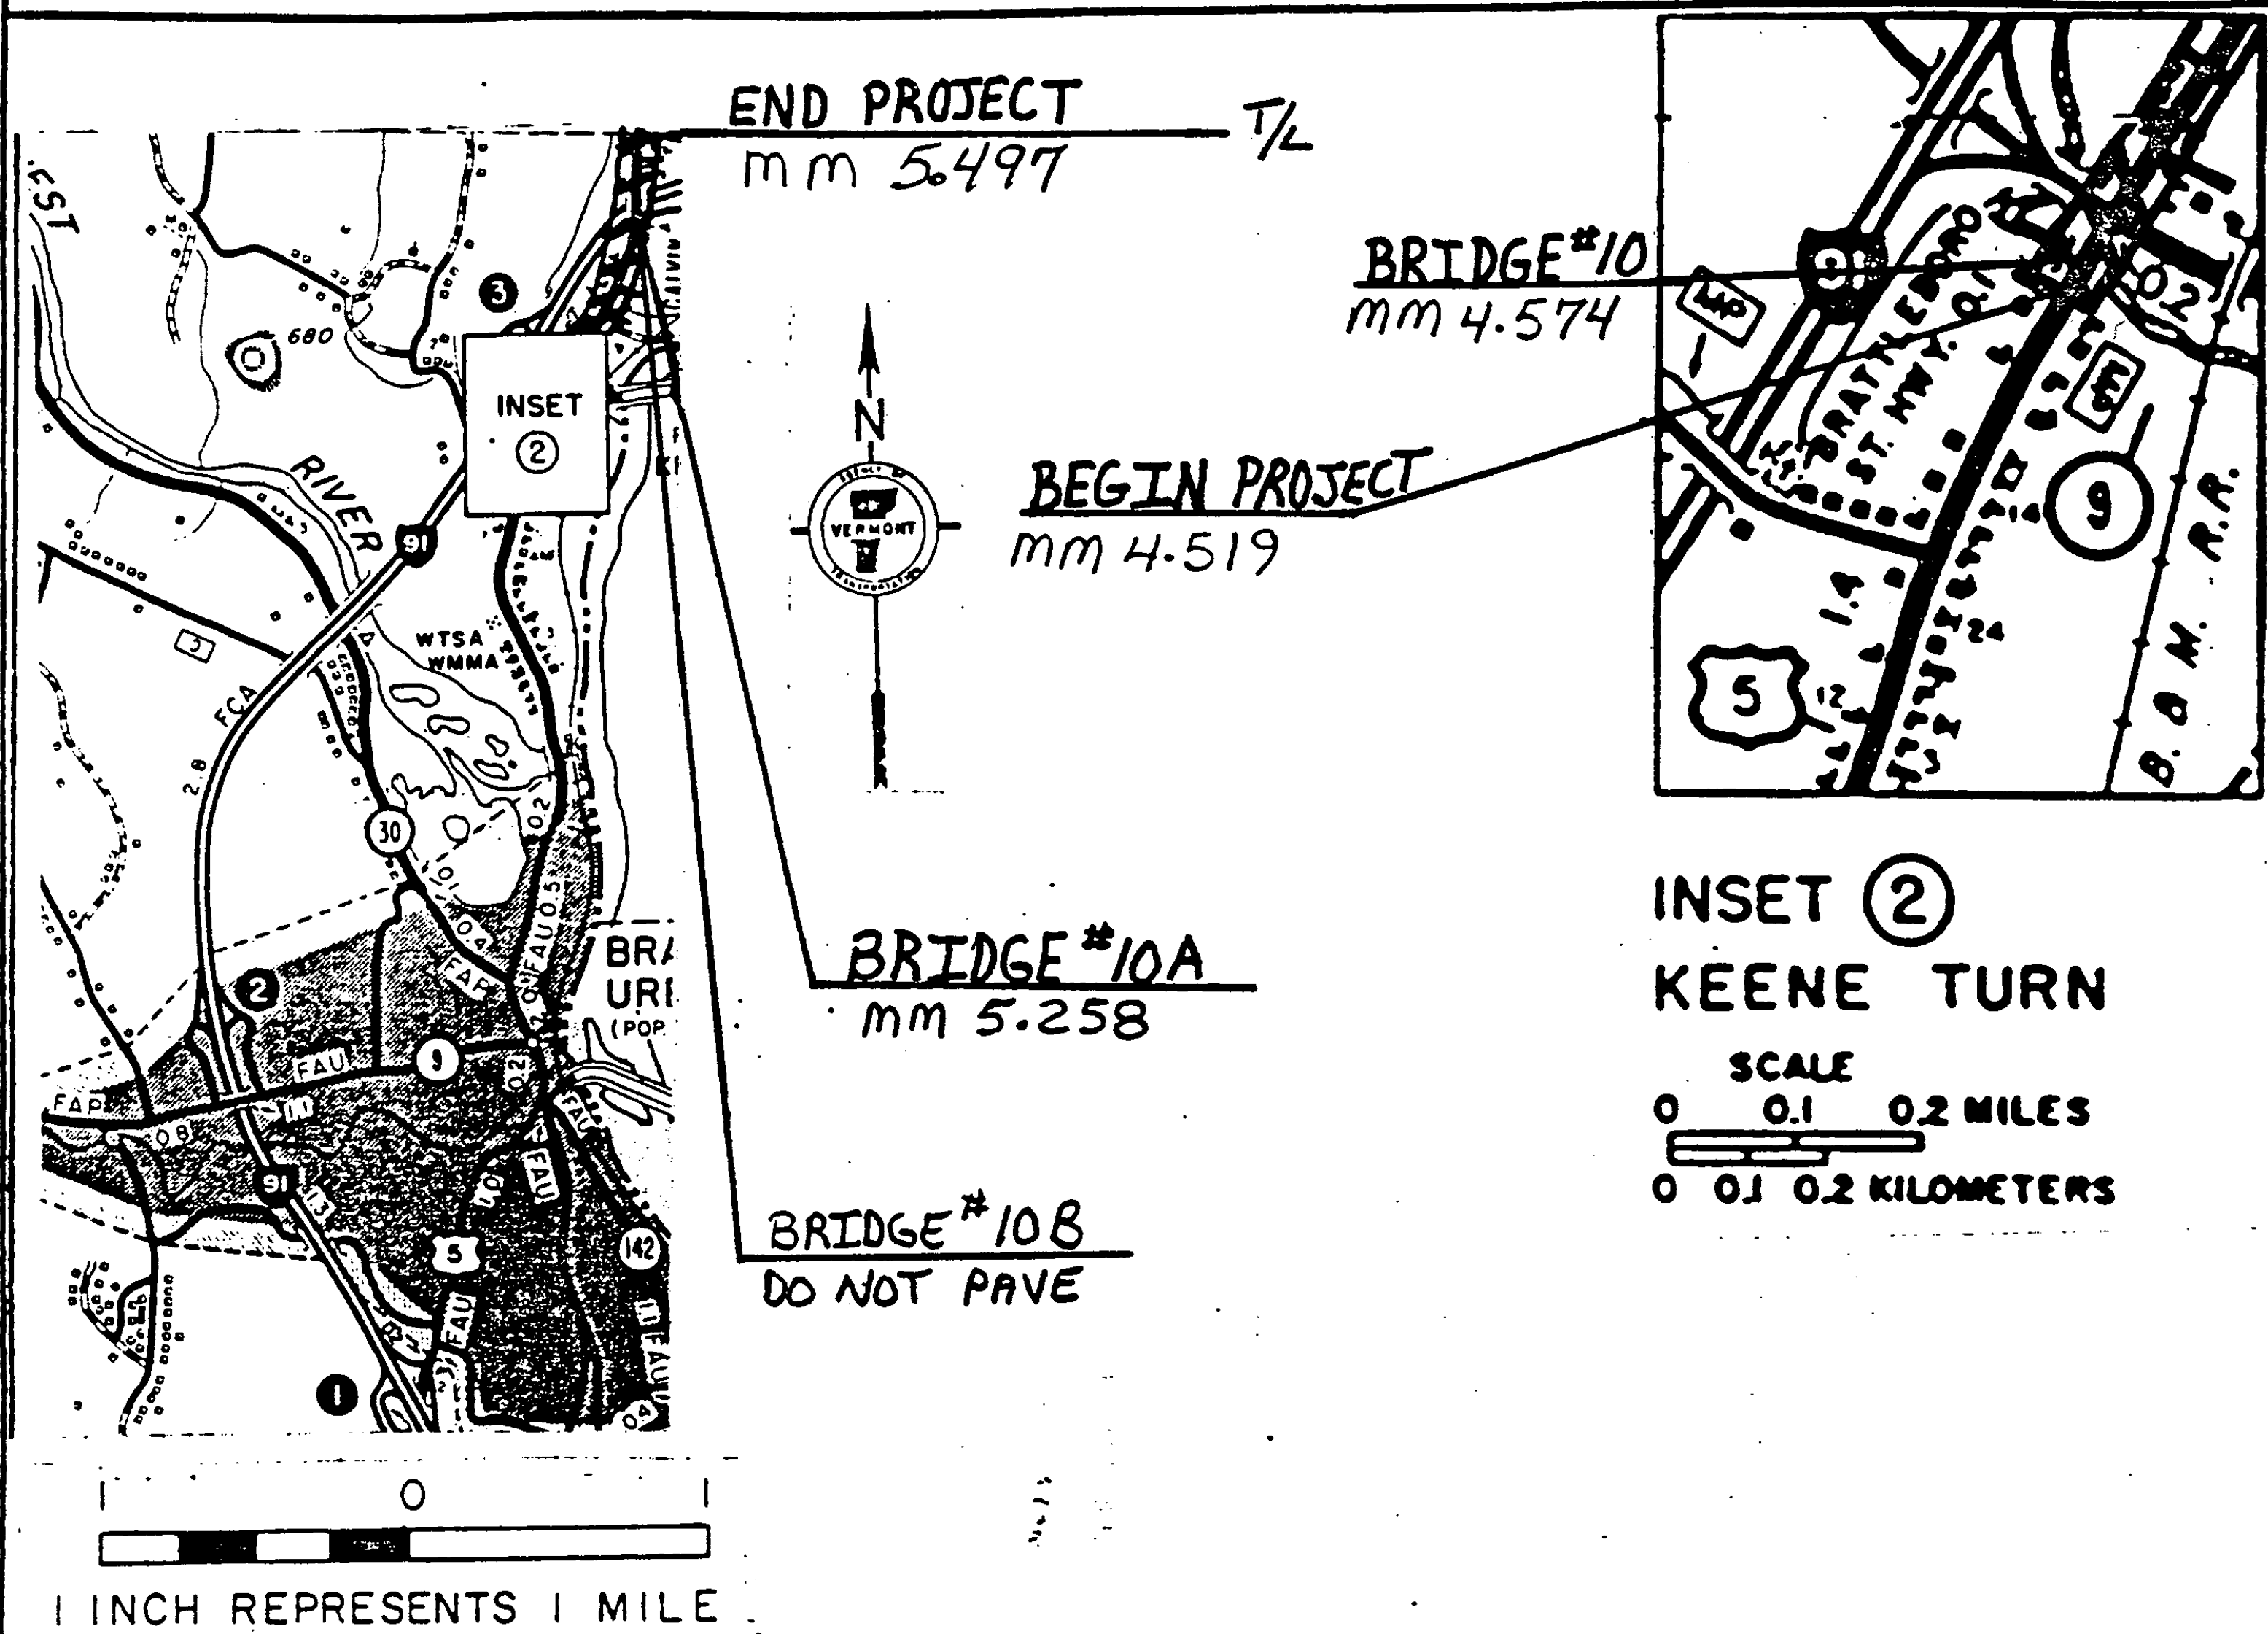

IN BRATTLEBORO, beginning at a point on US 5 approximately 300 feet south of the bridge over Sargent Brook (mm 4.519) and extending northerly 0.978 miles to the BRATTLEBORO - DUMMERSTON T/L mm 5.497.

TRAFFIC DATA
1982 ADT 10,430
V = 40 MPH

LENGTH OF PROJECT: 0.978 mi.
5164 Ft.