


TYPICAL SECTIONS & DESIGN DATA

ITEM 406.25 BITUMINOUS CONCRETE PAVEMENT
LEVELING COURSE, TYPE III OR IV (50' WIDE @ 563 TONS/mi)
AS DIRECTED BY THE ENGINEER
1 1/2" WEARING COURSE, TYPE III

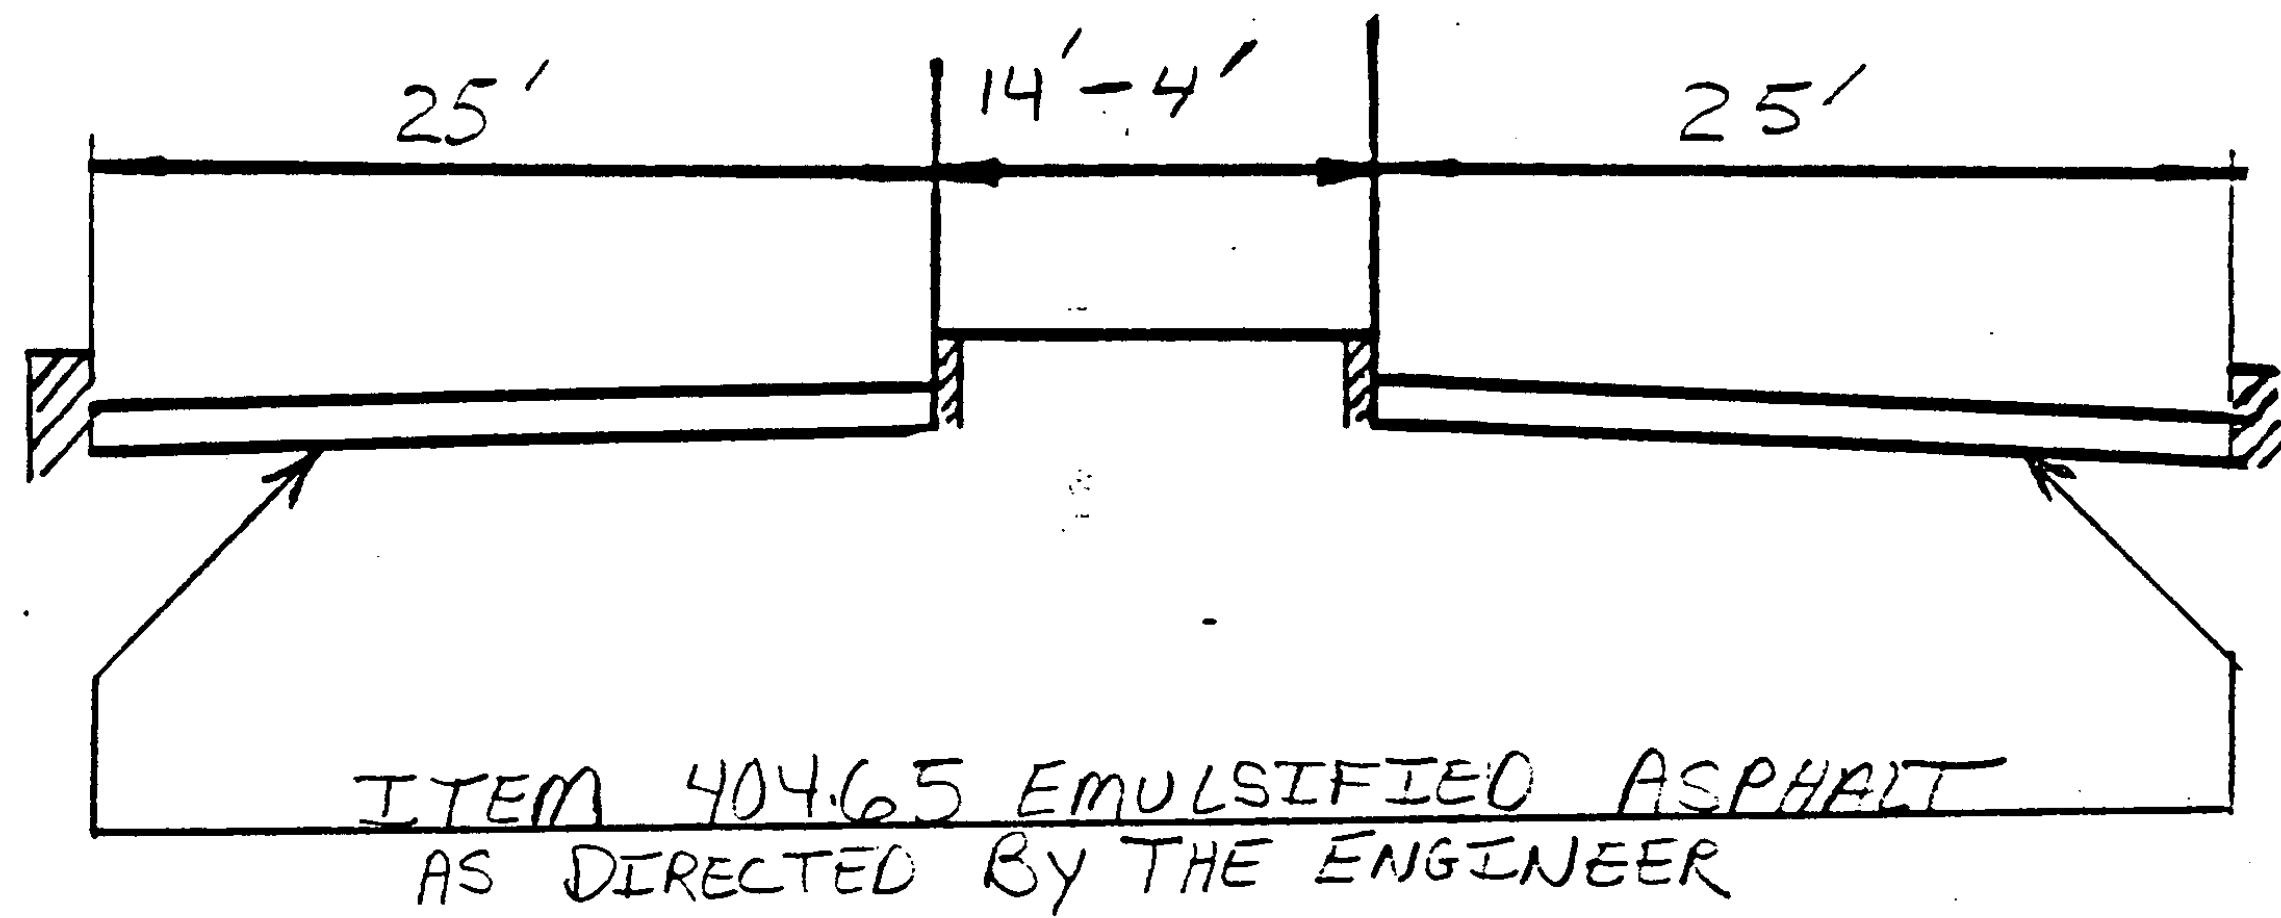

BRATTLEBORO MM. 4.519 ~ MM 4.652