


TYPICAL SECTIONS & DESIGN DATA

ITEM 406.25 BITUMINOUS CONCRETE PAVEMENT
LEVELING COURSE, TYPE III or IV (64' WIDE @ 7.27 ^{TONS}/mi)
AS DIRECTED BY THE ENGINEER
1 1/2" WEARING COURSE, TYPE III

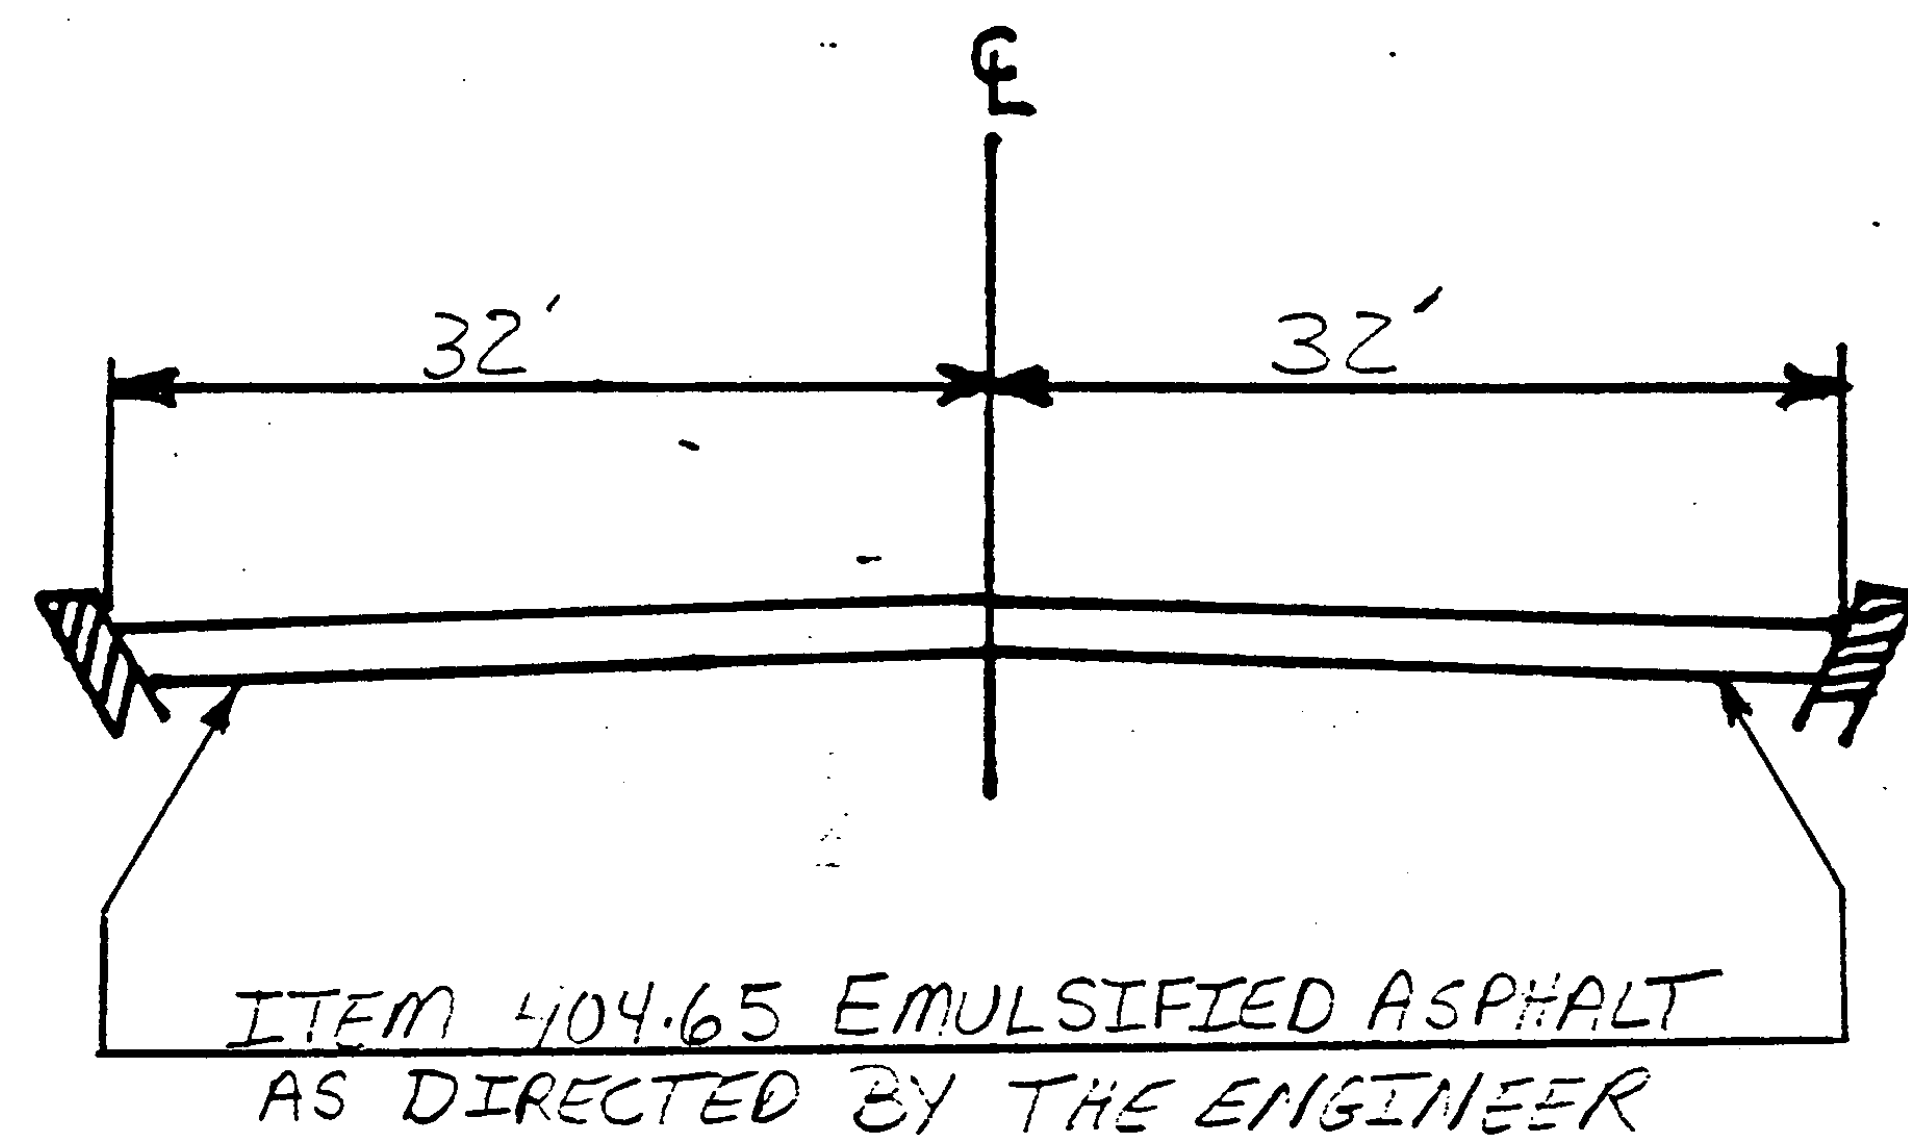

BRATTLEBORO MM 7.150 ~ MM 7.186