
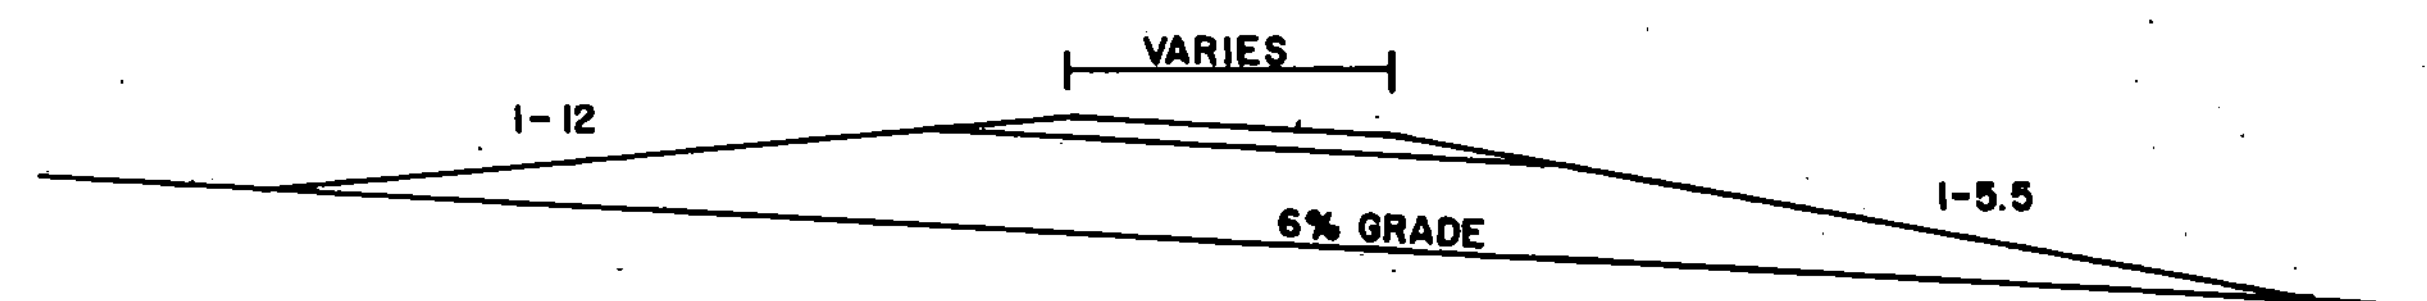
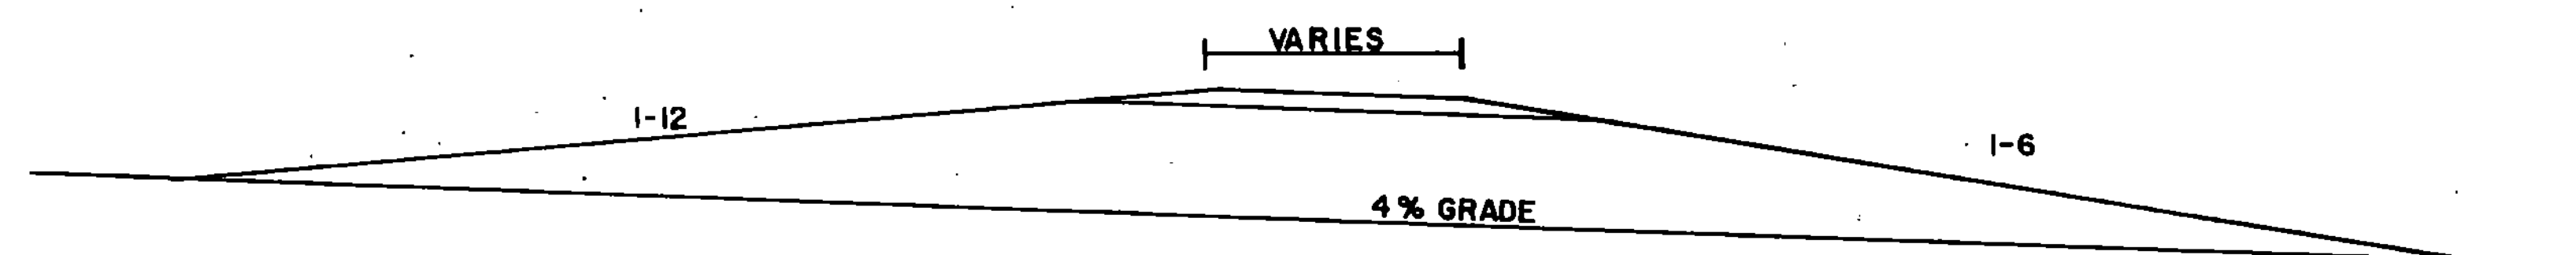
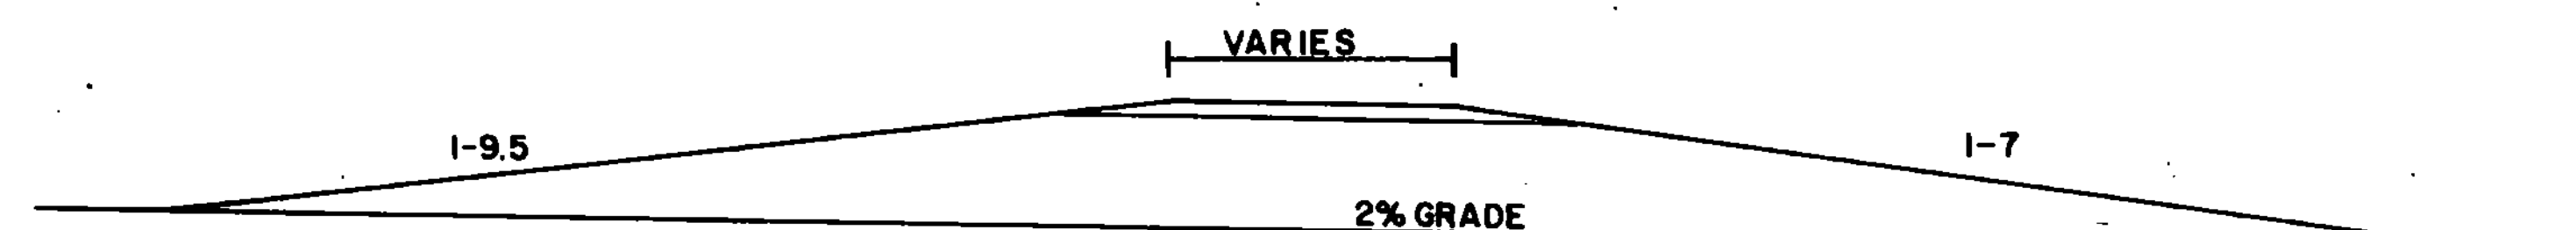


SUGGESTED DRIVEWAY TYPICALS

NOTE: SIDESLOPES TO BE CONSTRUCTED AT A 1-8 (12.5%) SLOPE RELATIVE TO MAIN HIGHWAY GRADELINE. HOWEVER, IN NO CASE WILL THE SIDESLOPE DRAIN AT A RATE OF LESS THAN 1-12 (8.3%). TYPICALS ON THIS SHEET ARE FOR REFERENCE ONLY.

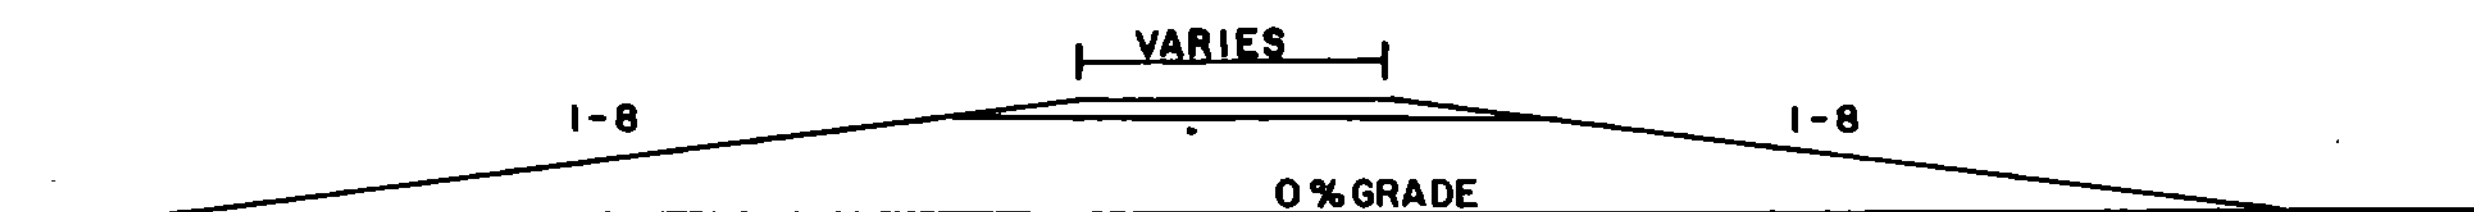

NOTE: IF THE SURFACE OF A DRIVE IS DISRUPTED DURING CONSTRUCTION IT SHALL BE REPAIRED. ROUNDINGS OF ITEM 402.12 AGGREGATE SHOULDERS AND ITEM 406.25, BITUMINOUS CONCRETE PAVEMENT HAVE BEEN ADDED TO PROJECT QUANTITIES FOR THIS USE. TYPE OF GRANULAR MATERIAL USED SHALL BE DETERMINED BY THE RESIDENT ENGINEER AND PAID AS ITEM 402.12 AGGREGATE SHOULDERS.