



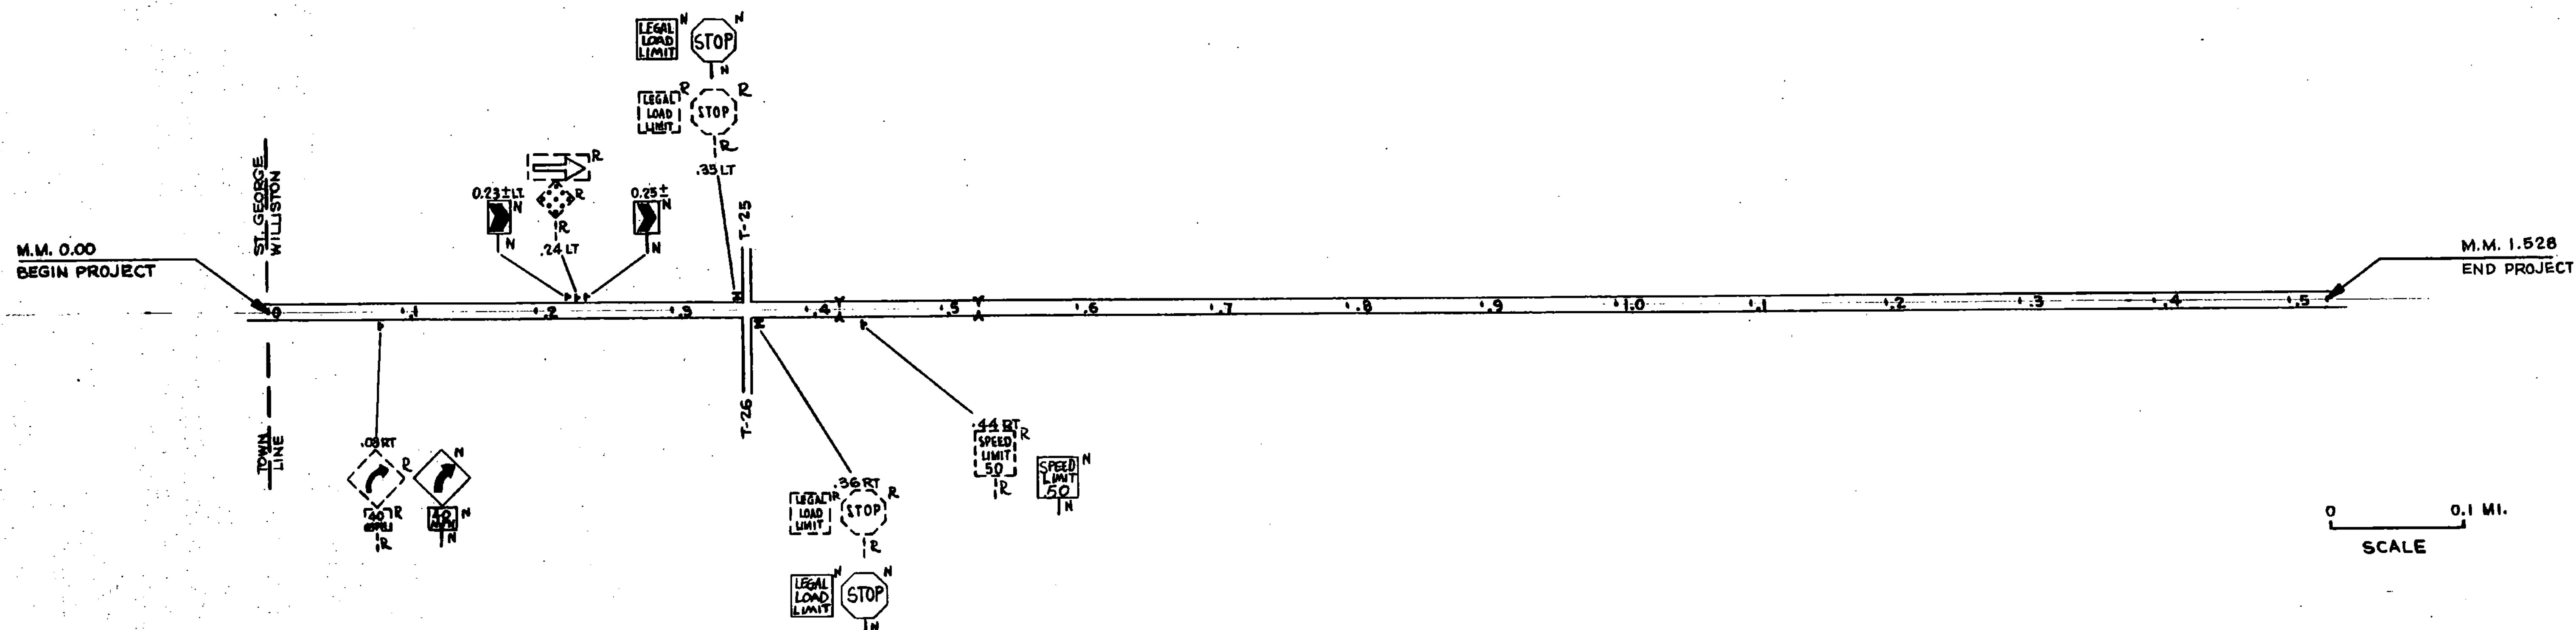

WILLISTON
VT. RTE. 2A
M 5500(5)S

- LEGEND**
R - REMOVE
N - NEW
R & S - REMOVE AND SALVAGE
S - SALVAGED
RET - RETAINED

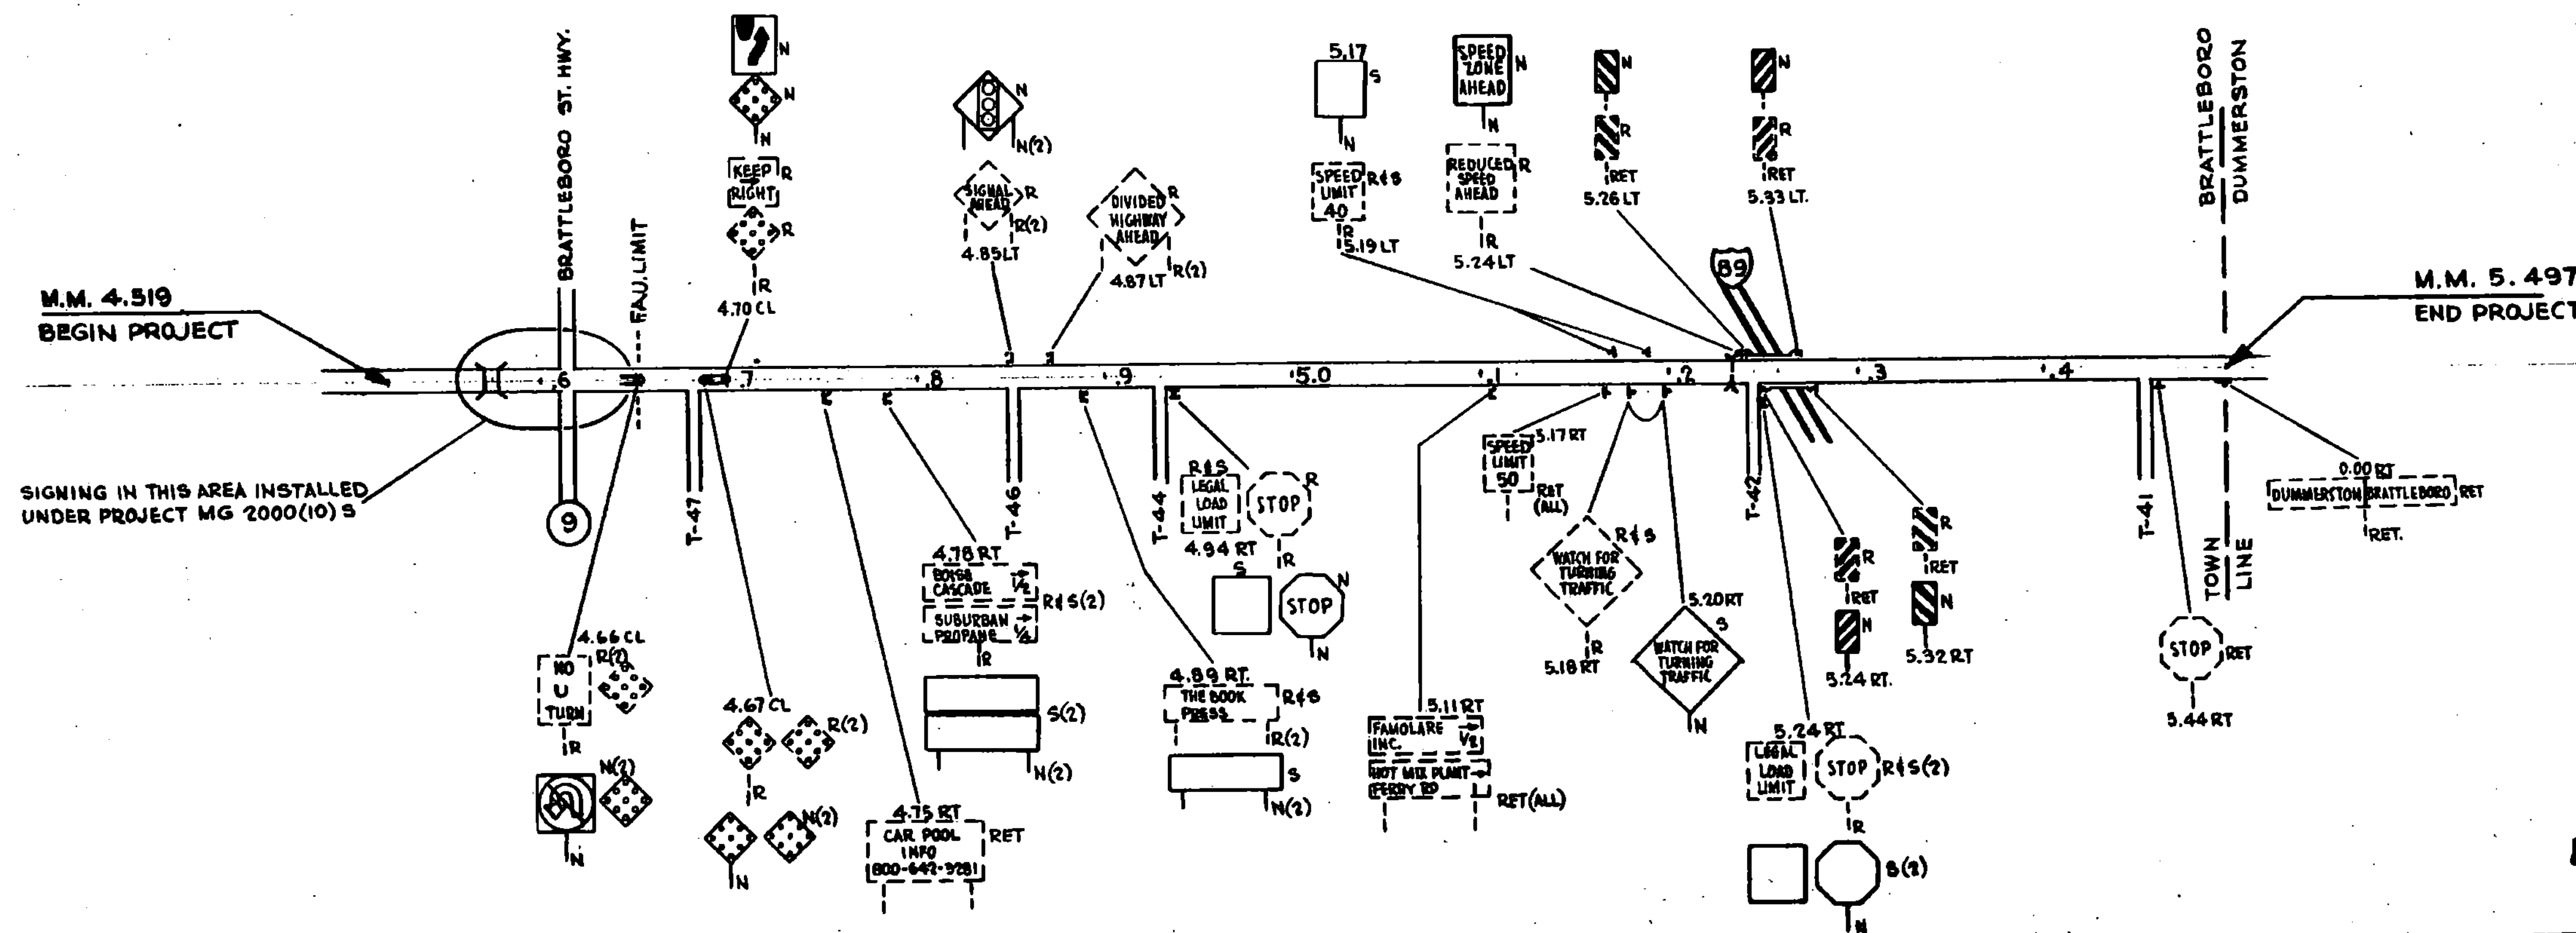

BRATTLEBORO
U.S. RTE. 5
M 2000(12)S

PROJECT SHEET 001501 SHEET 1

SURVEYED BY	DATE
DRAWN BY	DATE 9/10/88
TRACED BY	DATE
WILLISTON	
PROJ. M NO 5500(5)S	
SHEET 21 OF 200	

DATUM
VERTICAL
HORIZONTAL