


[illegible]

SEE SHEET TD 504 FOR PROJECT SUMMARY OF QUANTITIES AND
REVISION NOTE FOR LEGAL LOAD LIMIT SIGNING.

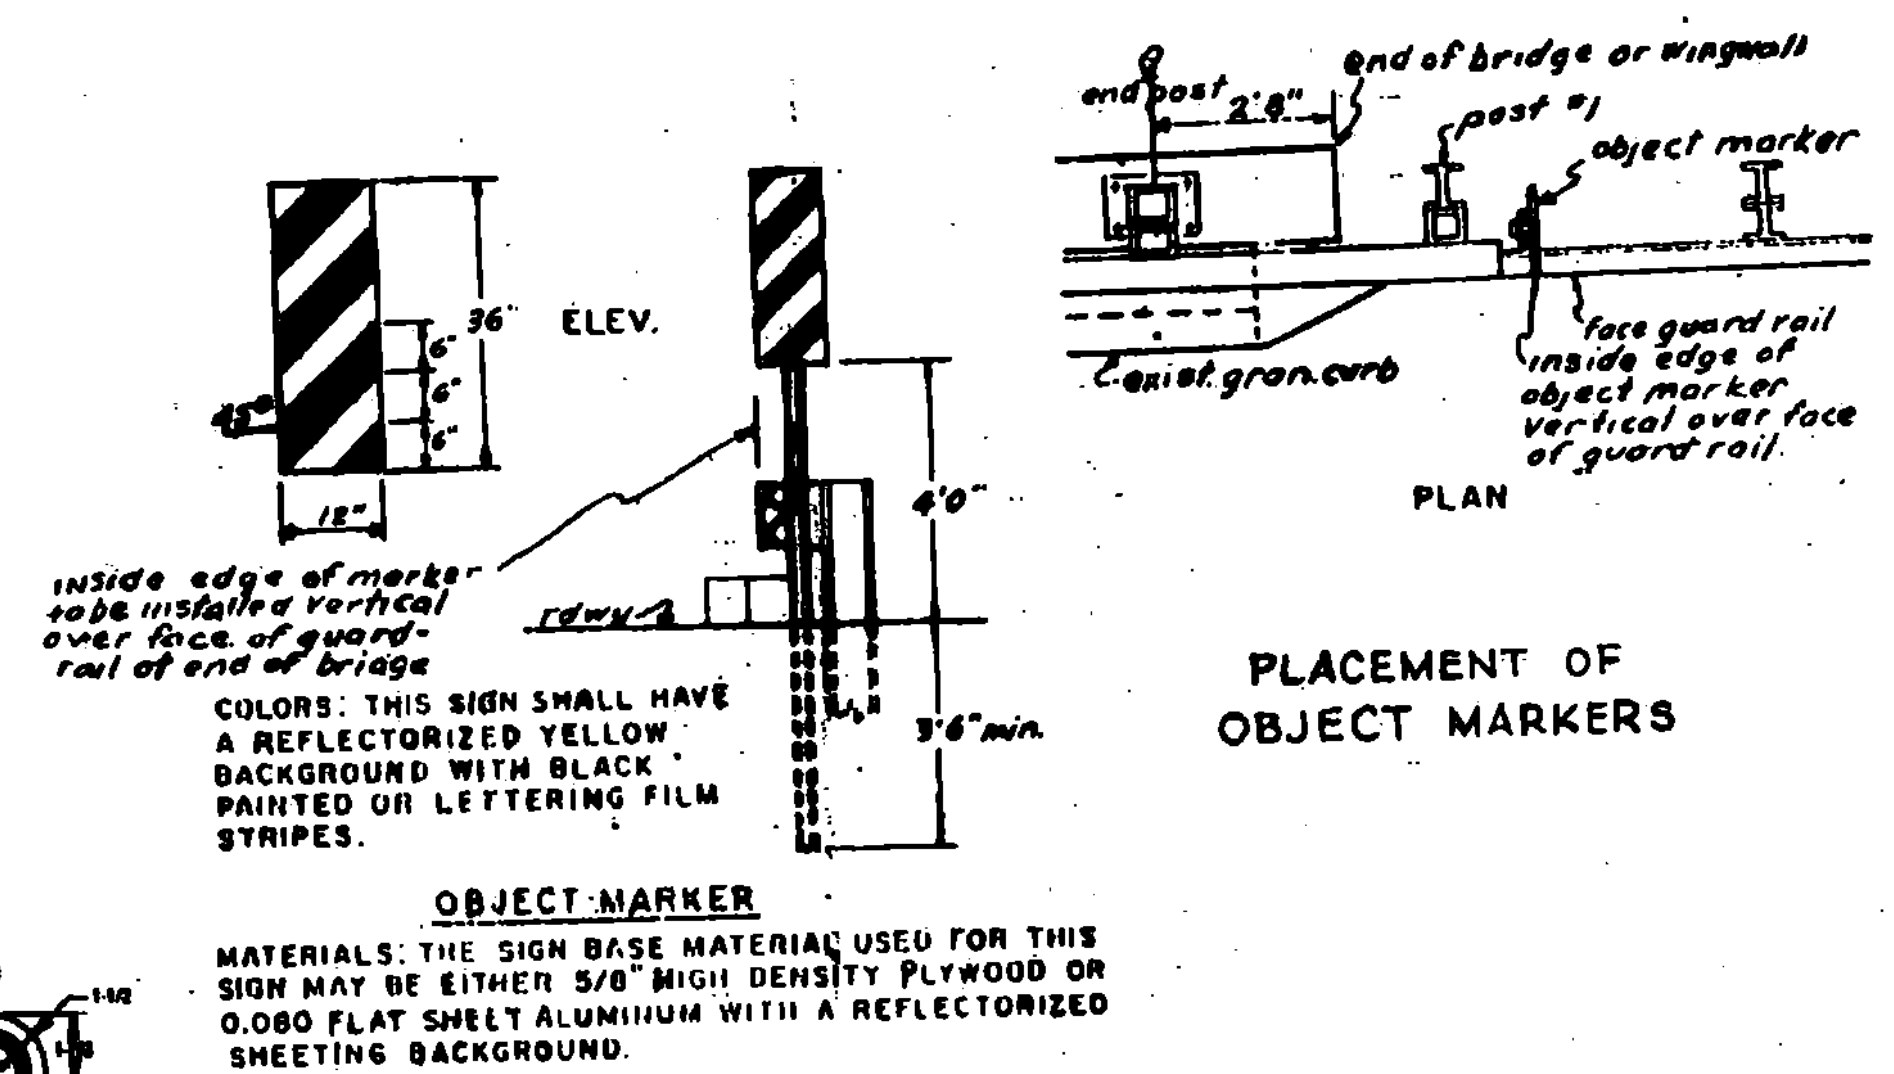

OBJECT-MARKER

MATERIALS: THE SIGN BASE MATERIAL USED FOR THIS SIGN MAY BE EITHER 5/8" HIGH DENSITY PLYWOOD OR 0.080 FLAT SHEET ALUMINUM WITH A REFLECTORIZED SHEETING BACKGROUND.

TRAFFIC SHEET NO. 70517 SHEET 1 OF 2

DRAWN BY _____ DATE _____
CHECKED BY _____ DATE _____
ALBURG, ENOSBURG,
JOHNSON, LUDLOW
FROM _____ NO. _____
STATEWIDE _____ F-SFTY (BS) S
SHEET 56 OF 200