
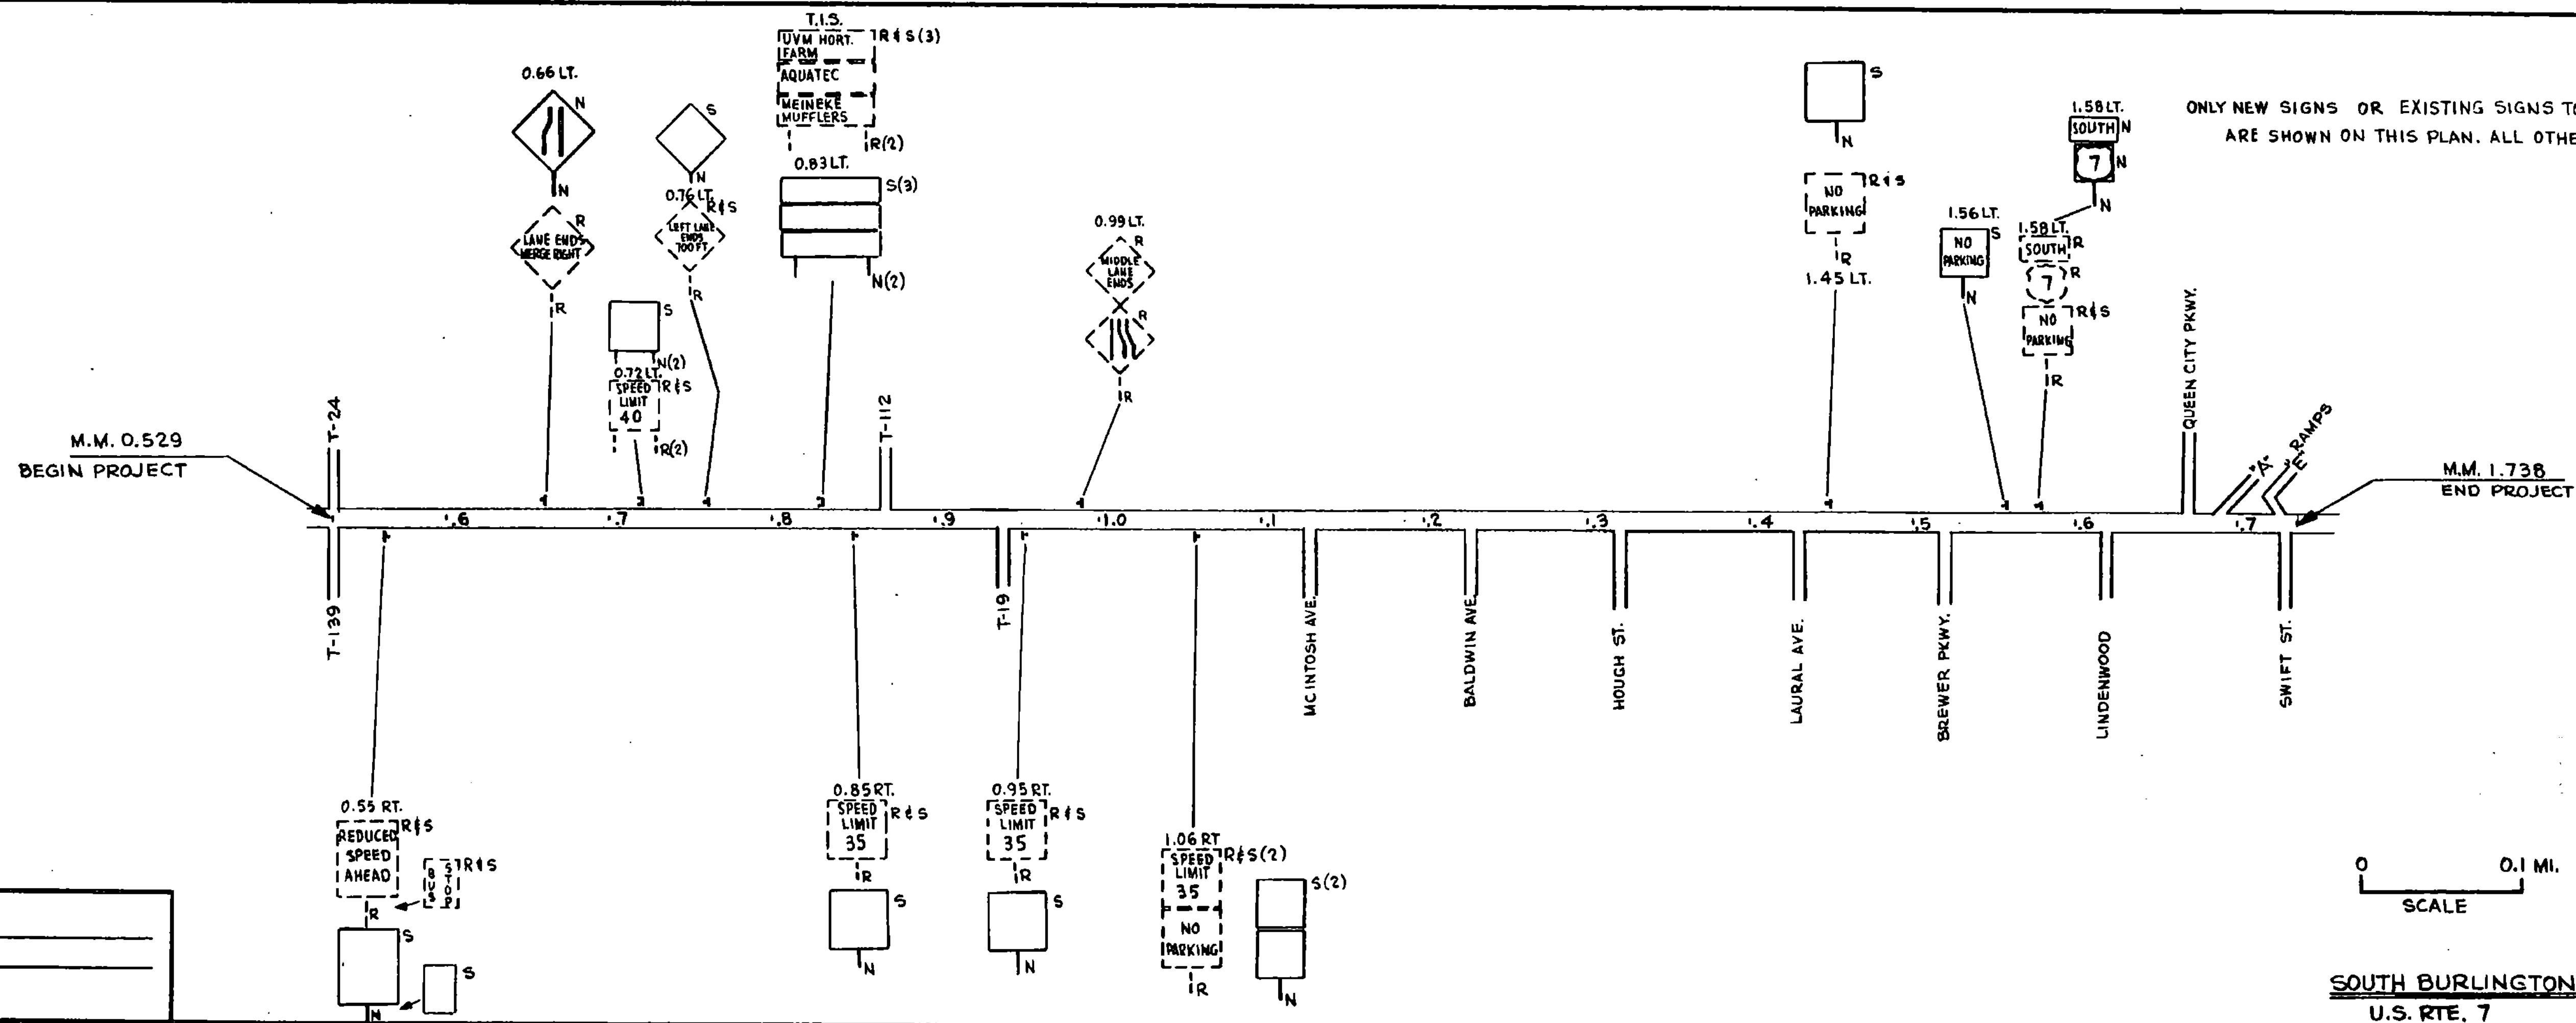


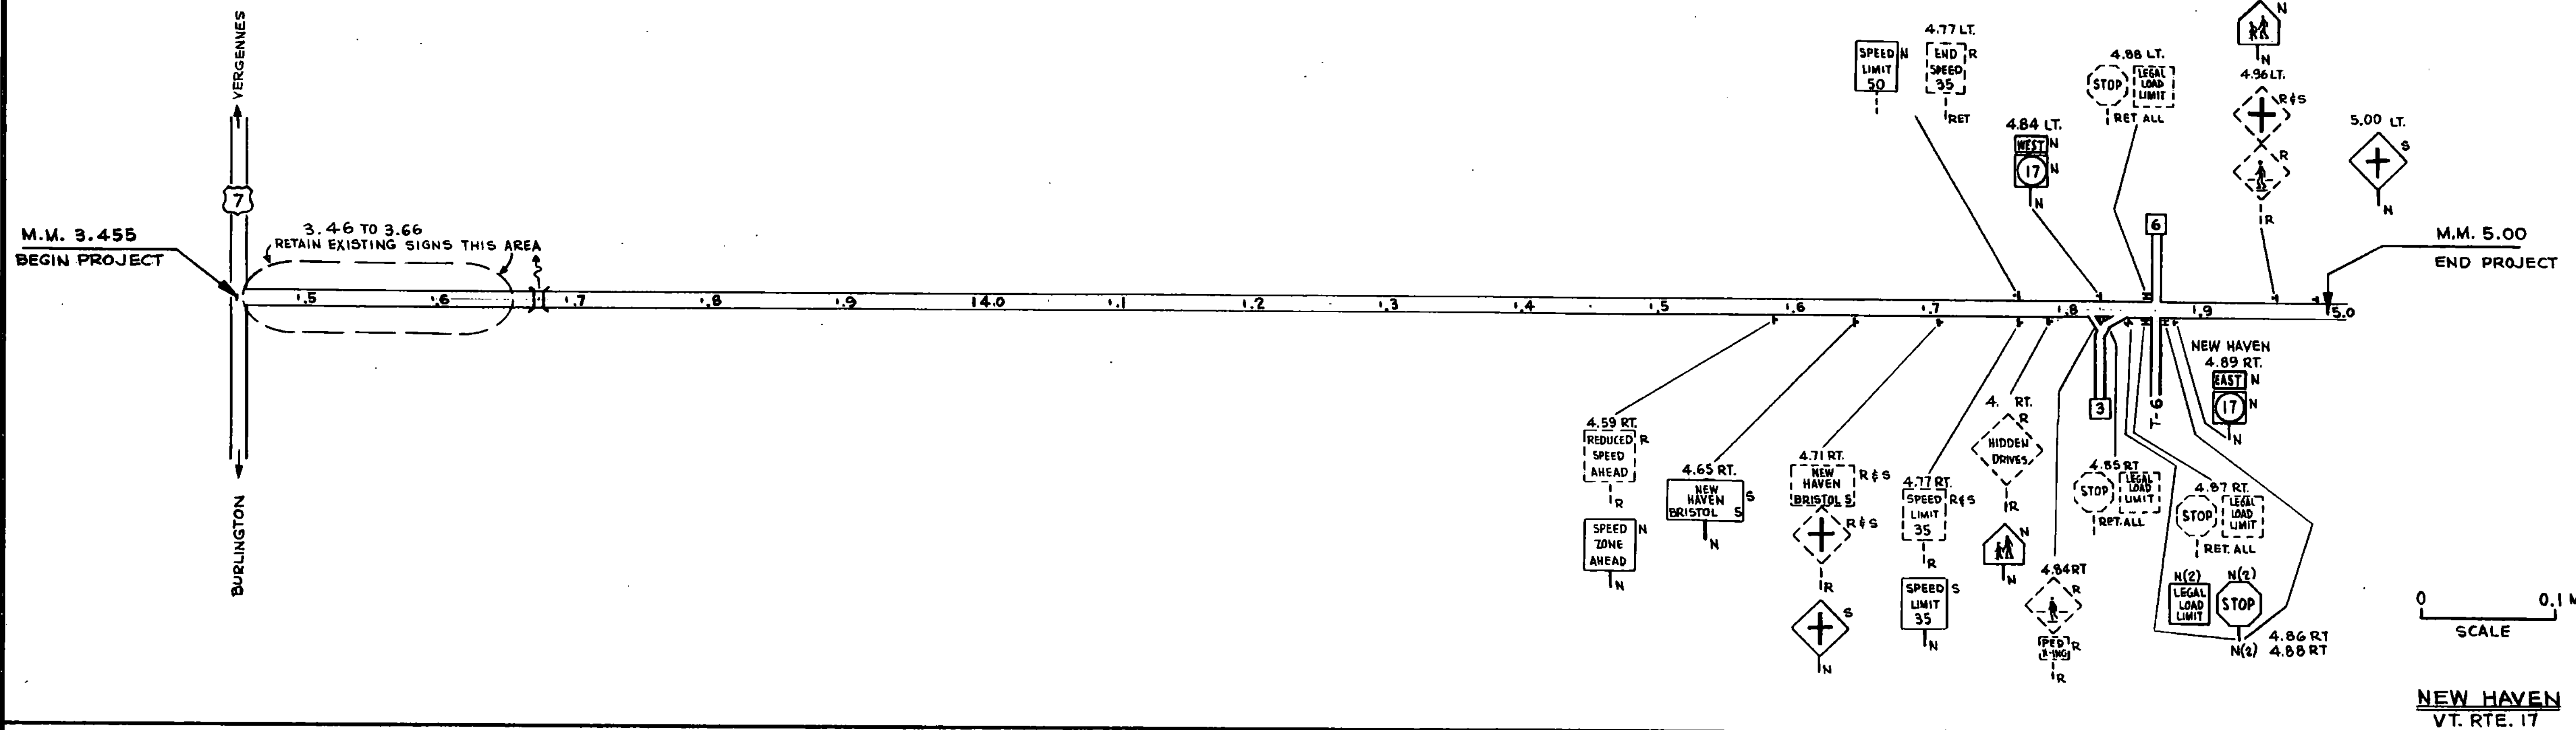

LEGEND

RET - RETAIN
R - REMOVE
S - SALVAGE
R+S - REMOVE AND SALVAGE
N - NEW

TRAFFIC SHEET NO. 10530 SHEET 7 OF 7

SURVEYED BY _____ DATE _____
DRAWN BY S.H.M. DATE 9/9/85
TRACED BY _____ DATE _____

**NEW HAVEN,
SOUTH BURLINGTON**
STATEWIDE F-SFTY (85) S
SHEET 76 OF 200