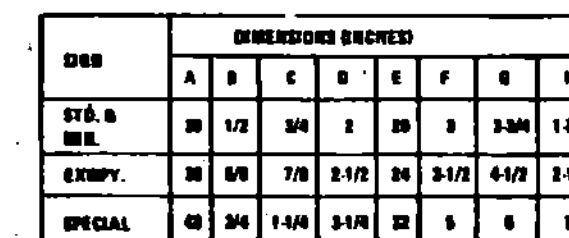


[illegible]NOTES AND DETAILS

81

D&B	DIMENSIONAL INCHES							
	A	B	C	D	E	F	G	H
STD. & MIL.	20	1/2	3/4	2	20	3	3-3/4	1 1/2
EXHYP.	20	5/8	7/8	2 1/2	24	3 1/2	4 1/2	2 1/2
SPECIAL	20	3/4	1 1/4	3 1/4	22	5	5	3 1/2

6019

DRAWN BY _____ DATE _____
 CHKD BY _____ DATE _____
 NEW HAVEN,
 SOUTH BURLINGTON
 PROJ. NO.
 STATEWIDE F-SFTY (85) S
 SHEET 78 OF 200