



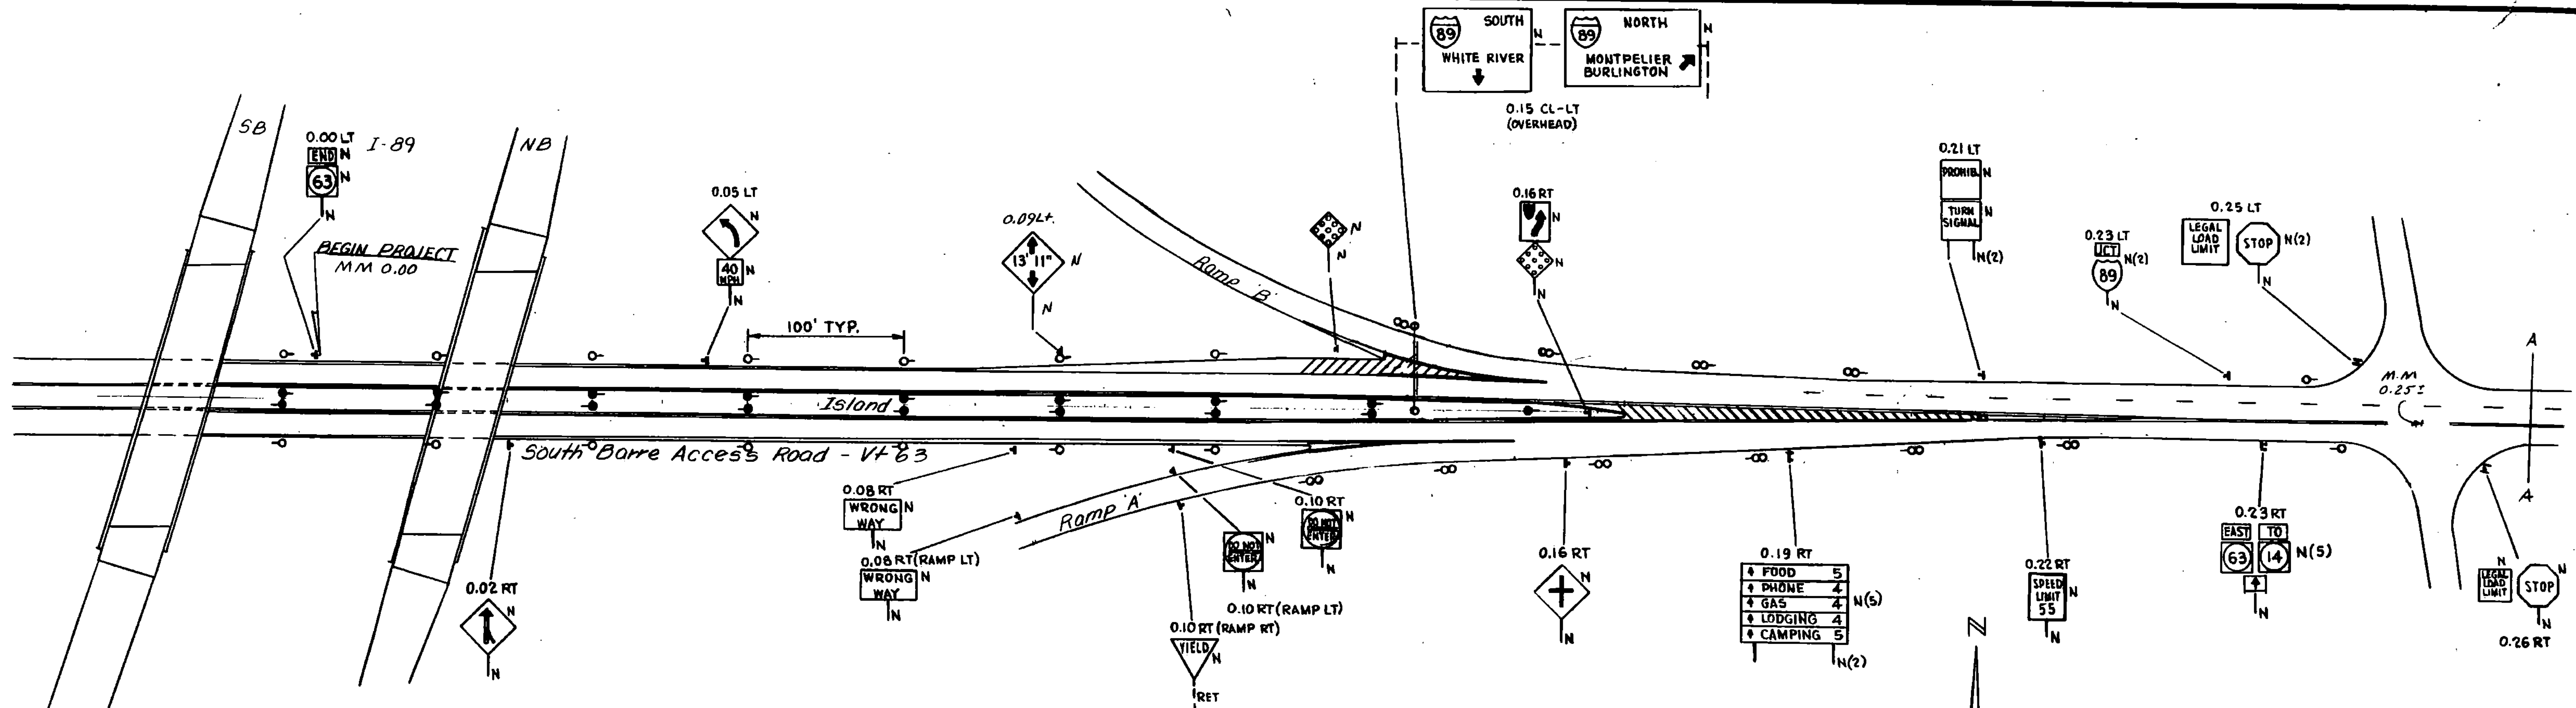

DELINEATORS

ITEM	QUANTITY	TYPE
EB @ T.H.	1	TYPE I
WB @ T.H.	1	"
EB TAPER	6	"
WB TAPER	4	"
E.B. APPR. RT.	7	TYPE I (WHITE)
E.B. APPR. MED.	8	" (AMBER)
W.B. APPR. MED.	9	"
W.B. APPR. RT.	7	" (WHITE)
TOTAL	76	17

WITH FLEXIBLE POST (ITEM 676.20)

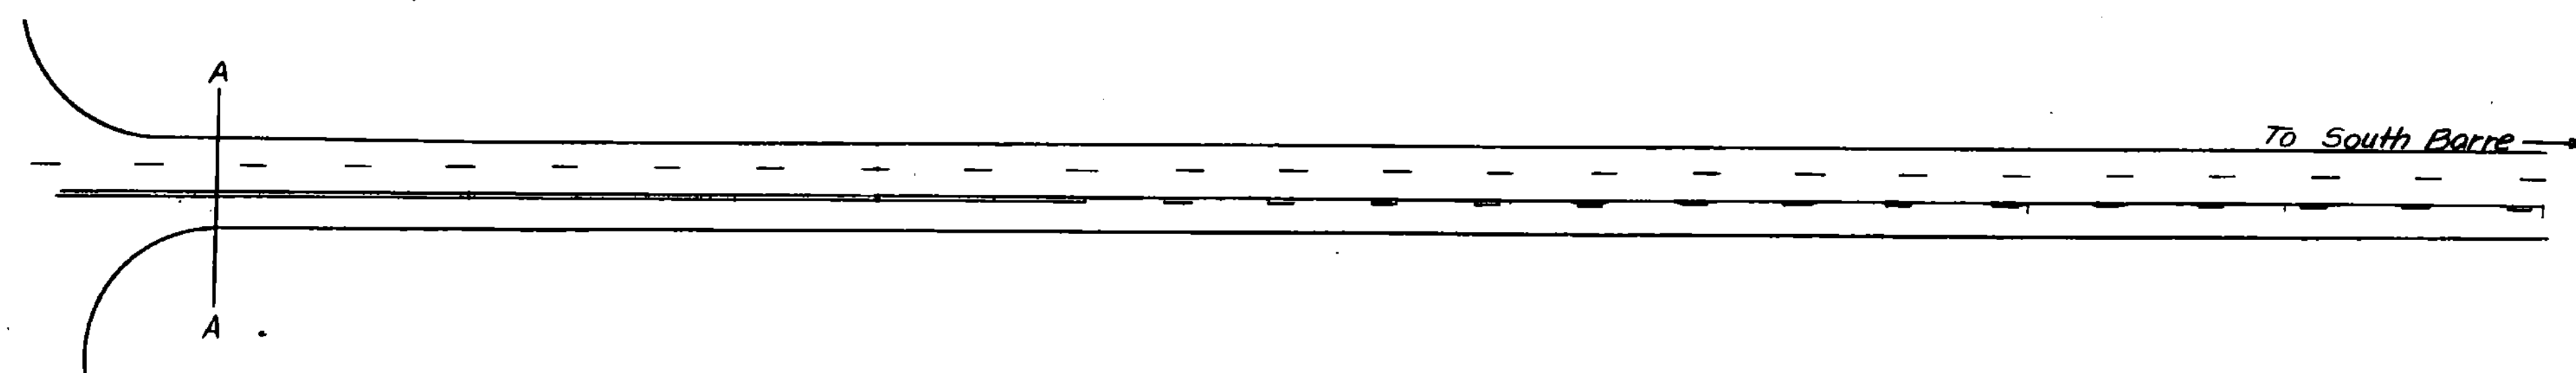

REMOVE AND REPLACE REFLECTOR UNITS (GUARDRAIL)
W.B. LANE TO RAMP "B" - RT. 7

LEGEND

- TYPE I (WHITE)
- ⊗ TYPE II
- TYPE I (AMBER)
- N - NEW
- RET - RETAIN

NEW AND SALVAGED
SIGNS
0.0 THRU 0.26

SURVEYED BY _____ DATE _____
 DRAWN BY JB DATE 2-85
 TRACED BY JB DATE 2-85
 BERLIN ~ BARRE
 STATEWIDE NO. F-SFTY (85) S
 SHEET 88 OF 200

DATUM
 VERTICAL _____
 HORIZONTAL _____

NOT TO SCALE