


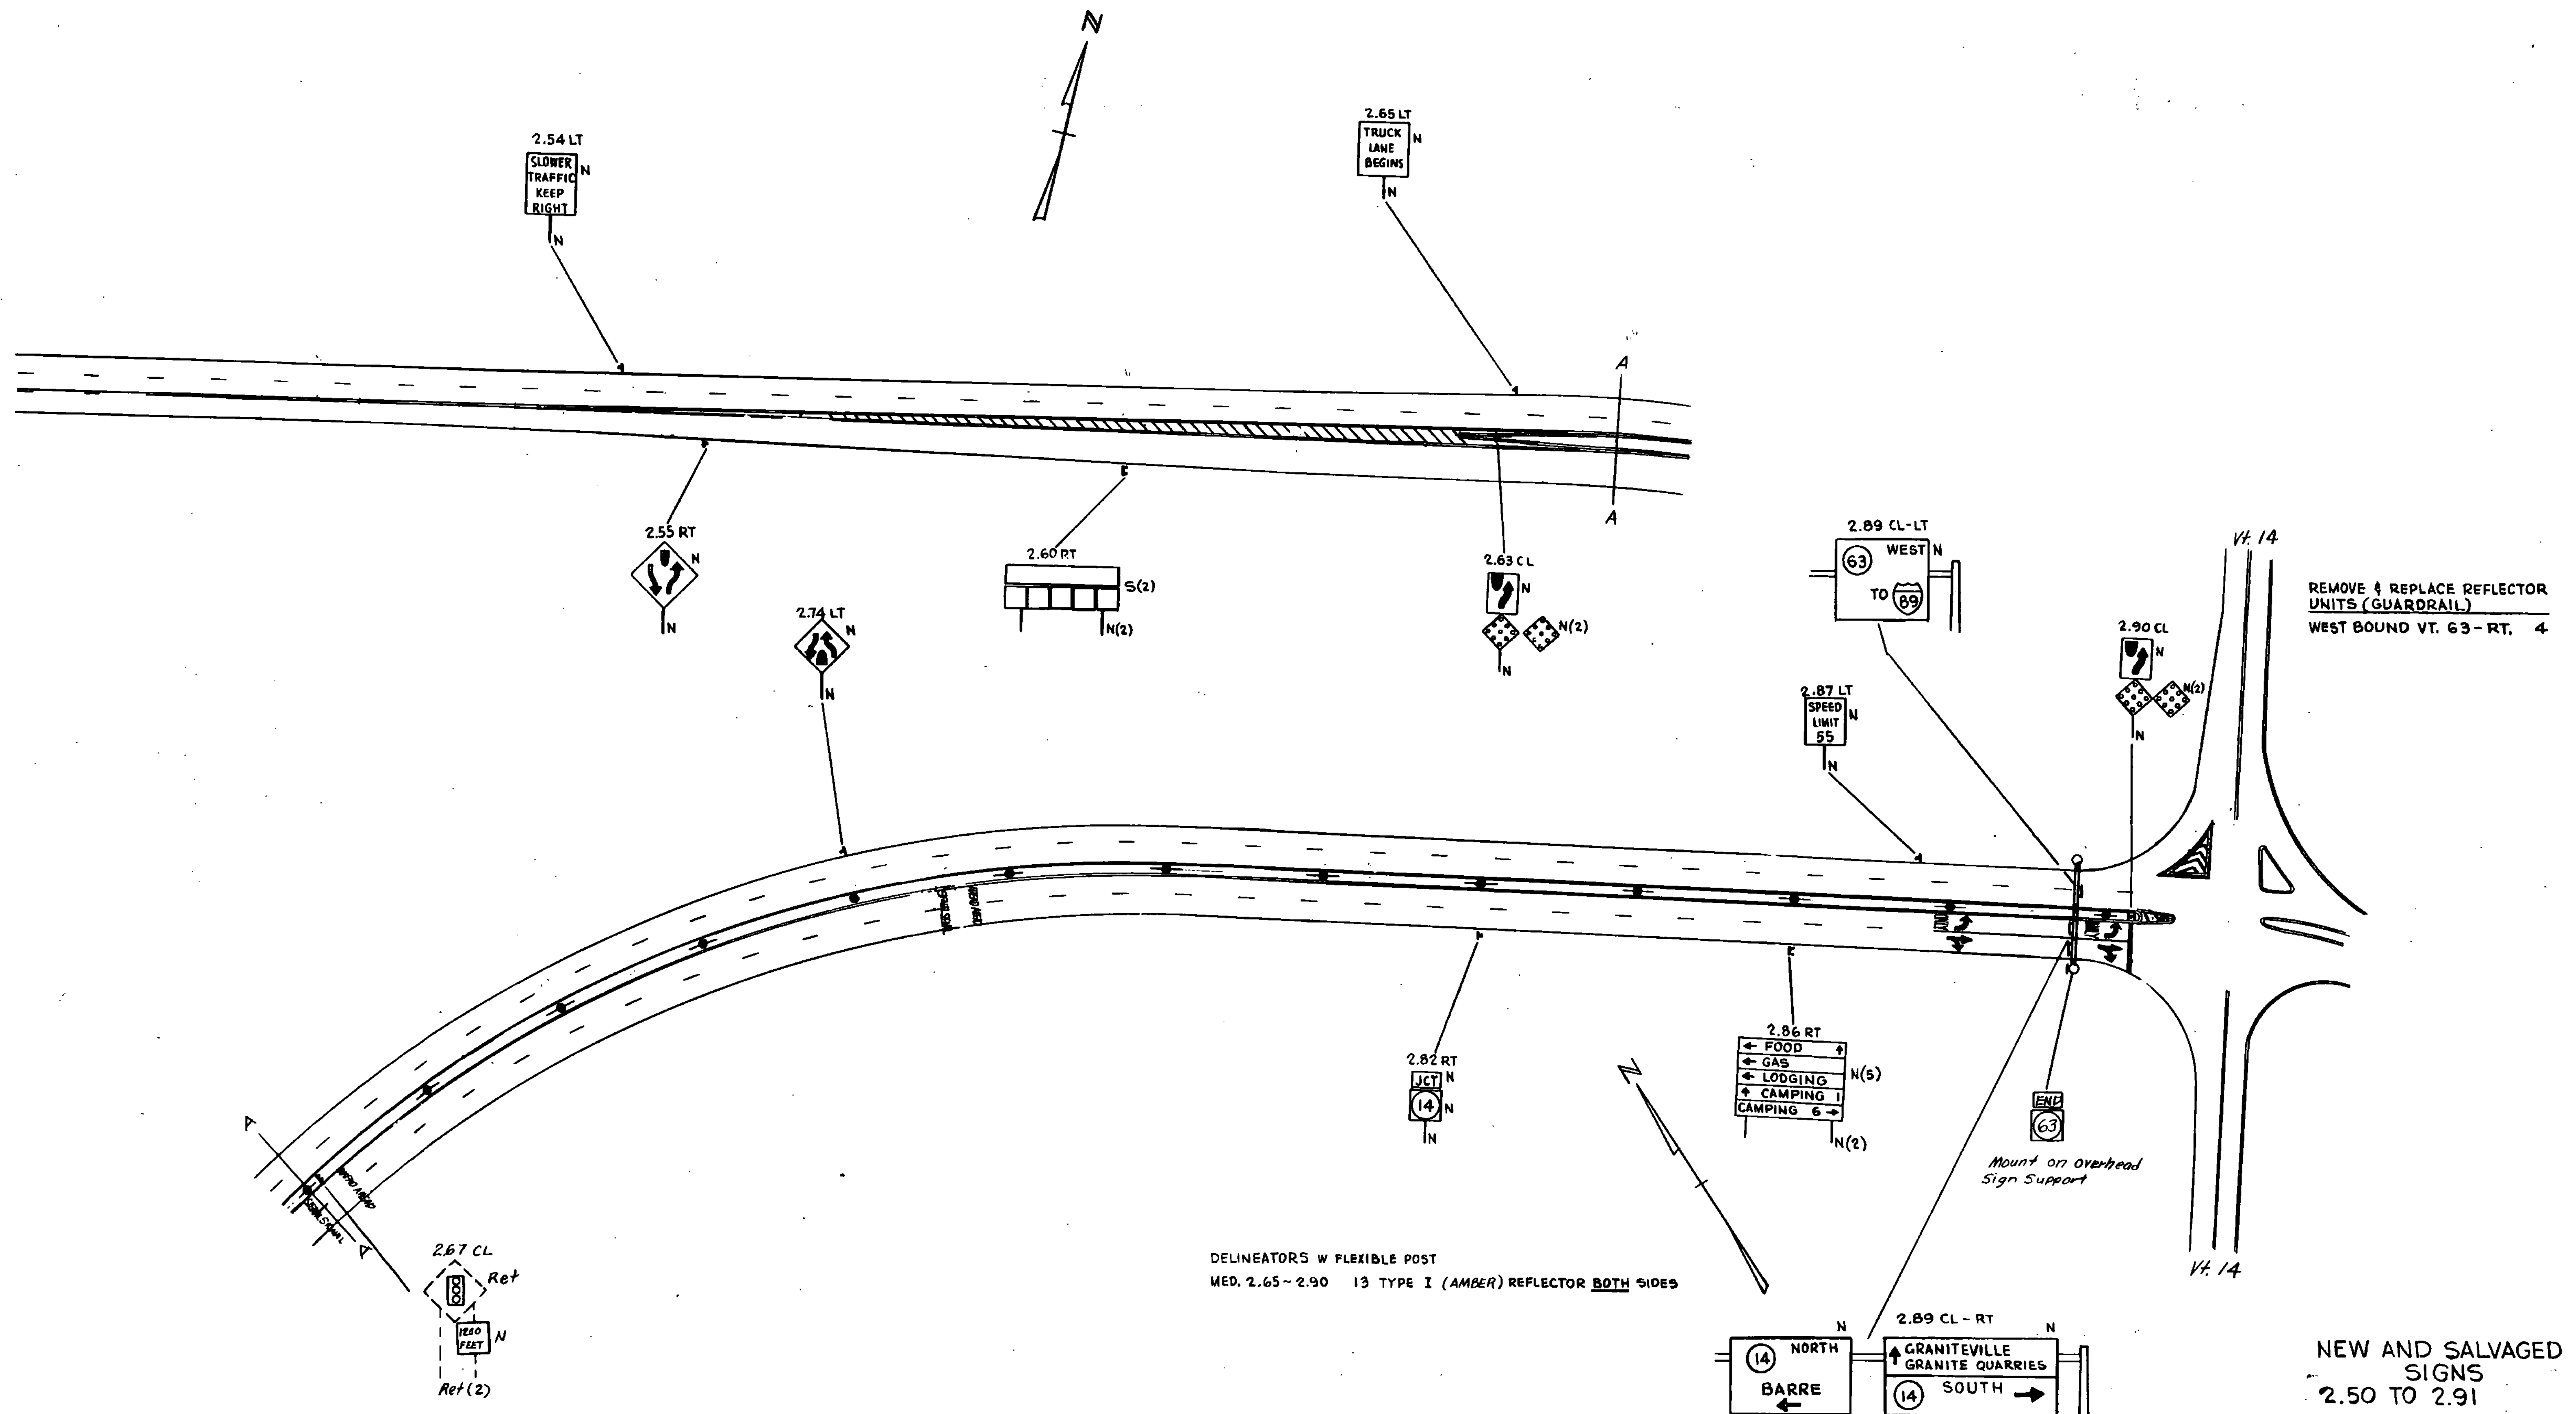

DATUM
VERTICAL _____
HORIZONTAL _____

SURVEYED BY _____ DATE _____
DRAWN BY JB DATE 2-85
TRACED BY JB DATE 2-85
BERLIN ~ BARRE
STATEWIDE F-SFTY (85) S
SHEET 90 OF 200