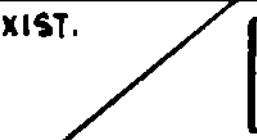
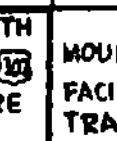
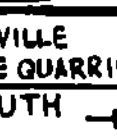
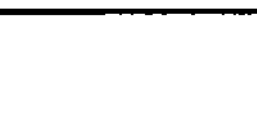


TRAFFIC SIGN SUMMARY SHEET

MILEMARKER, STATION, OR SIGN NUMBER	SIGN LEGEND	SIGN DIMENSIONS	EXISTING SIGNS		NEW AND SALVAGED SIGNS				EXISTING POSTS				NEW SIGN POSTS											REMARKS	FOR SIGN DETAIL SHEET	
			TO BE REMOVED (EA.)	TO BE RETAINED (X)	NEW "A" (S.F.)	NEW "B" (S.F.)	SALV. SIGN (EA.)	SALV. T.I.S.(S.F.)	RET.	DRILL	REM.	SALV.	NUMBER OF POSTS	FLANGED CHANNEL			TUBULAR ALUMINUM			W SHAPED STEEL				PLAN SHEET NUMBER	STD. SHEET NUMBER	
														2.0 LB./FT.	2.5 LB./FT.	3.0 LB./FT.	3.0" Ø	3.0" □	4.0" Ø	4.0" Ø MOD.	POST SIZE	WEIGHT	FTG. SIZE 24" 30"			
2.65 LT.	 	3' x 4'	X		12						X		1				X								E-15A	
2.74 LT.			X								X															
" "		3' x 3'			9								1			X									E-19A	
2.66 CL				X					X																E-19B	
2.77 RT			X								X															
2.82 RT		21" x 15"			2.2																				E-13	
2.82 CL		2' x 2'			4																				E-13	
			X								X															
			X																							
			X																							
2.86 RT			X								X(2)													RETAIN FOOTINGS		
		54" x 7 1/2"	X		2.8								2	X										TD 543		
		54" x 7 1/2"	X		2.8																			TD 543		
		54" x 7 1/2"	X		2.8																			TD 543		
		54" x 7 1/2"	X		2.8																			TD 543		
		54" x 7 1/2"	X		2.8																			TD 543		
2.87 LT	 	3' x 4'	X		12								1				X								E-15B	
2.90 CL		3' x 4'	X		12						X		1			X									E-15B	
		18" x 18"	X		2.3																				E-19B	
		18" x 18"	X		2.3																				E-19B	
2.89 O.W.D.		5' x 7'	X																							
		FACES E.B. TRAFF. 10' x 8.5	X																							
		FACES E.B. TRAFF. 14' x 9'	X																							
		MOUNT FACING WEST BOUND TRAFF.				41.3																		MOUNT NEW SIGN ON EXISTING OVERHEAD SIGN SUPPORT	TD 543	
		MOUNT OVER LEFT LANE FACING EAST BOUND TRAFF.				81																			TD 543	
		MOUNT ON RT FACING EAST BOUND TRAFF.				120																			TD 543	
TOTALS			21	X	69.8	242.3			X	X	X															

FINAL LENGTHS ARE TO BE DETERMINED IN THE FIELD, POST SIZES ARE
COMPUTED BASED ON INFORMATION FURNISHED ON THE STANDARD SHEETS AND
THE DESIGN DIVISION'S "SIGN POST DESIGN MANUAL".

PREPARED BY _____ DATE _____
CHECKED BY _____ DATE _____
PROJ. STATEWIDE NO. F-SFTY (85)
TRAFFIC SHEET NO. 541 SHEET 95 OF 200