
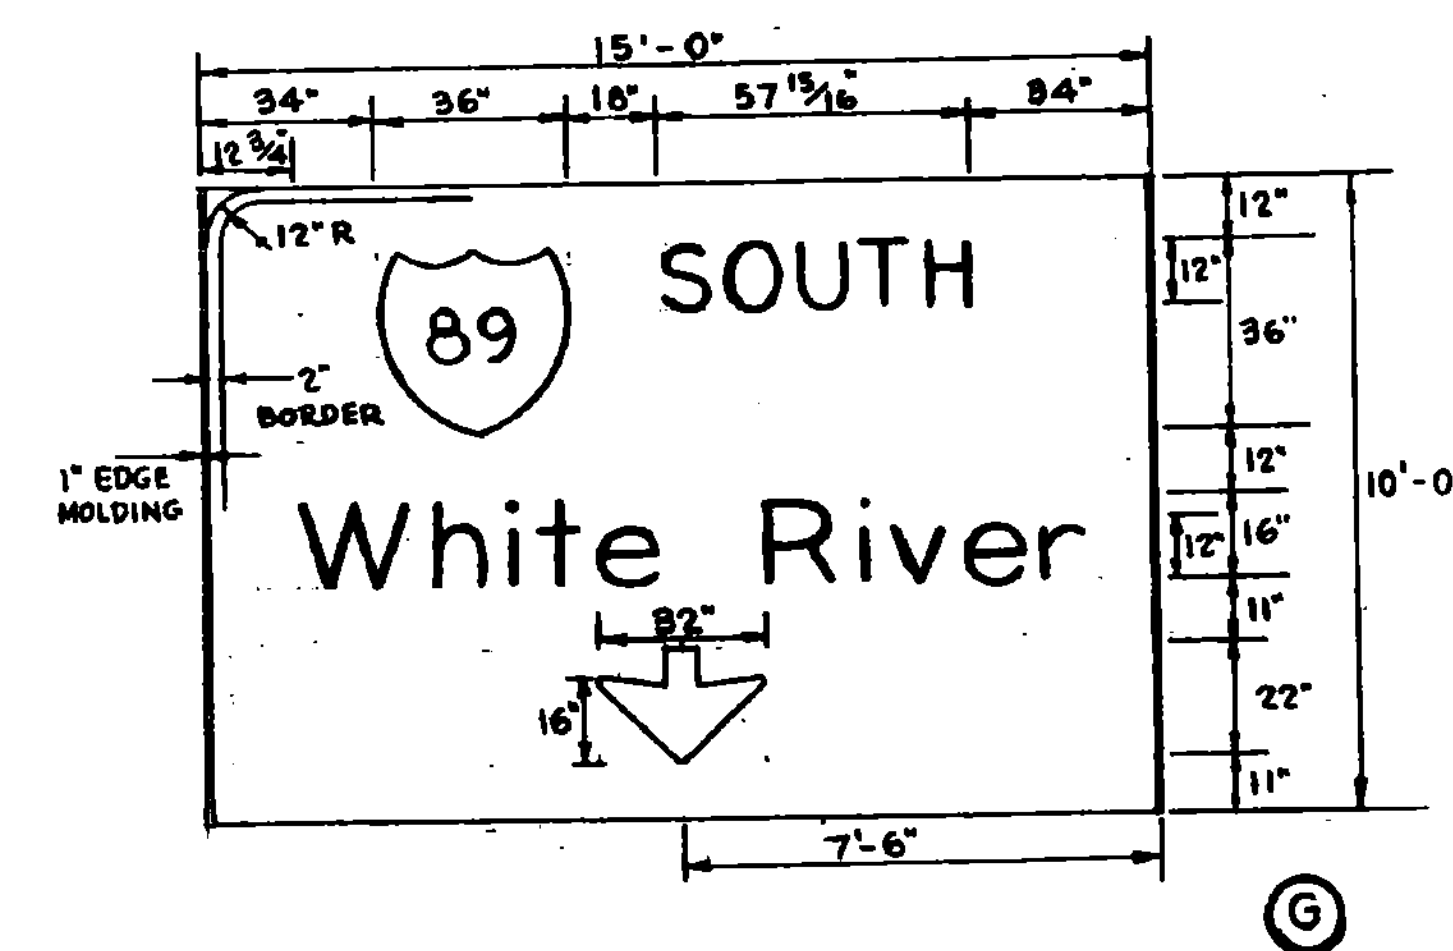
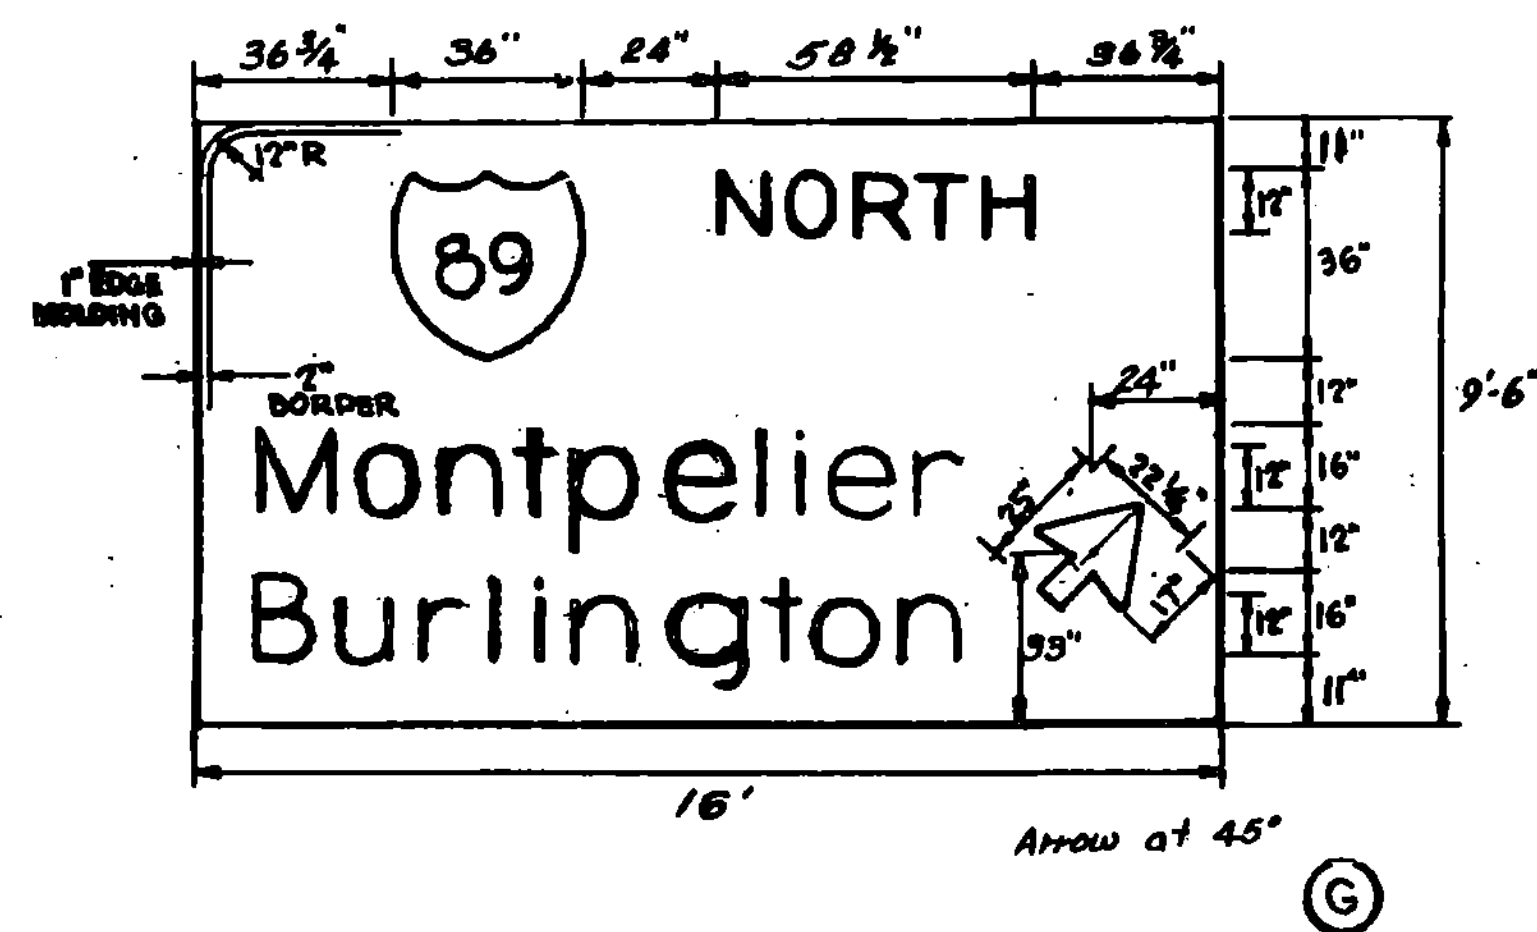
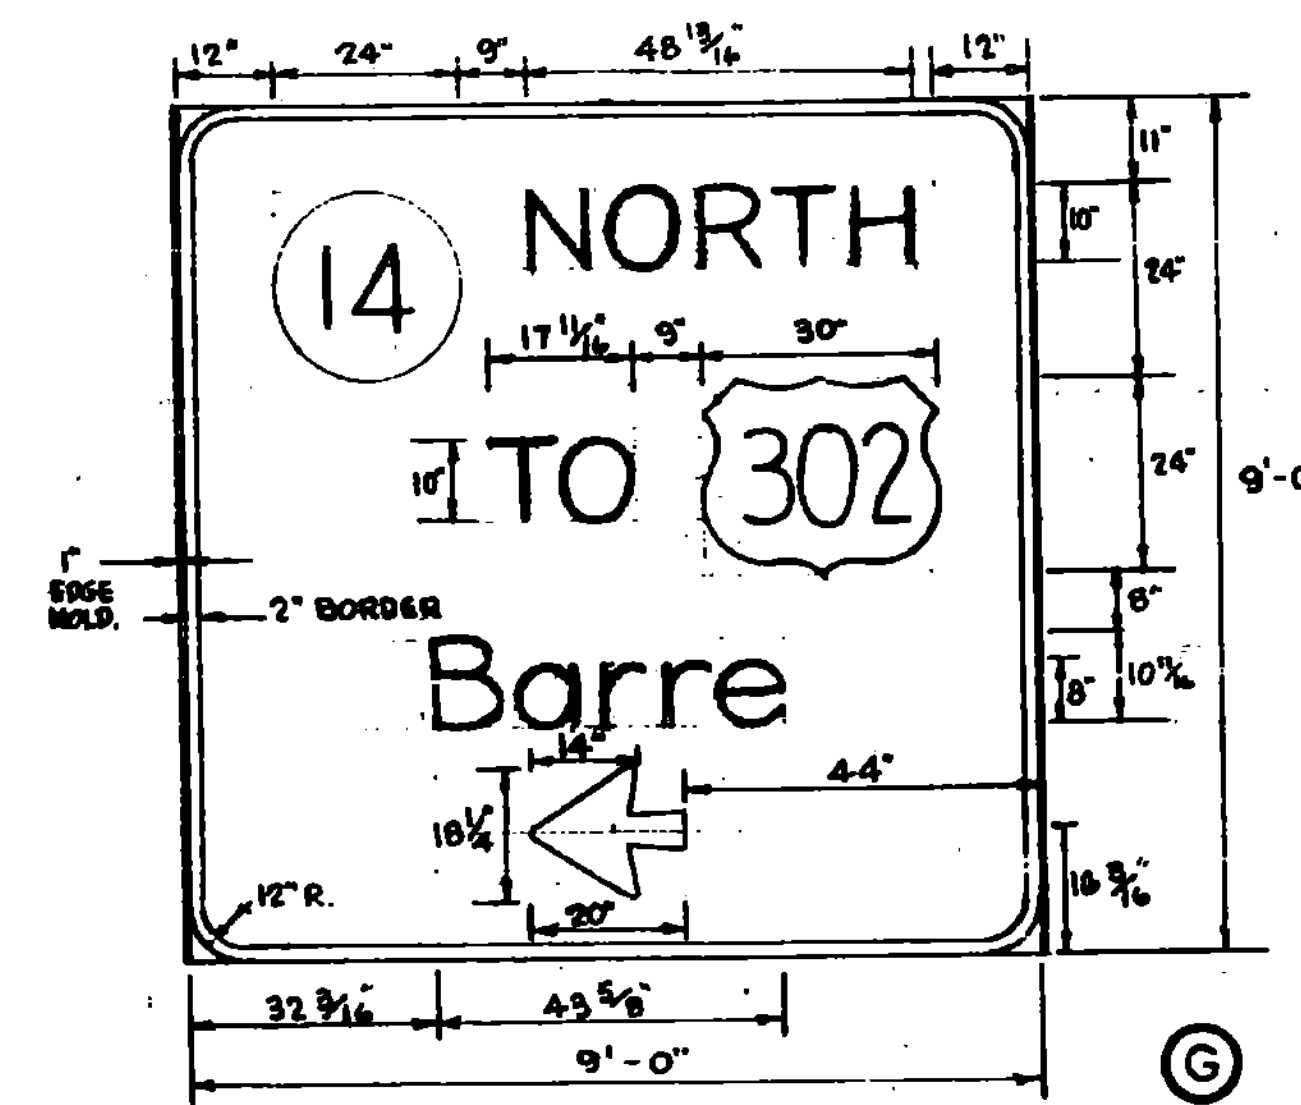
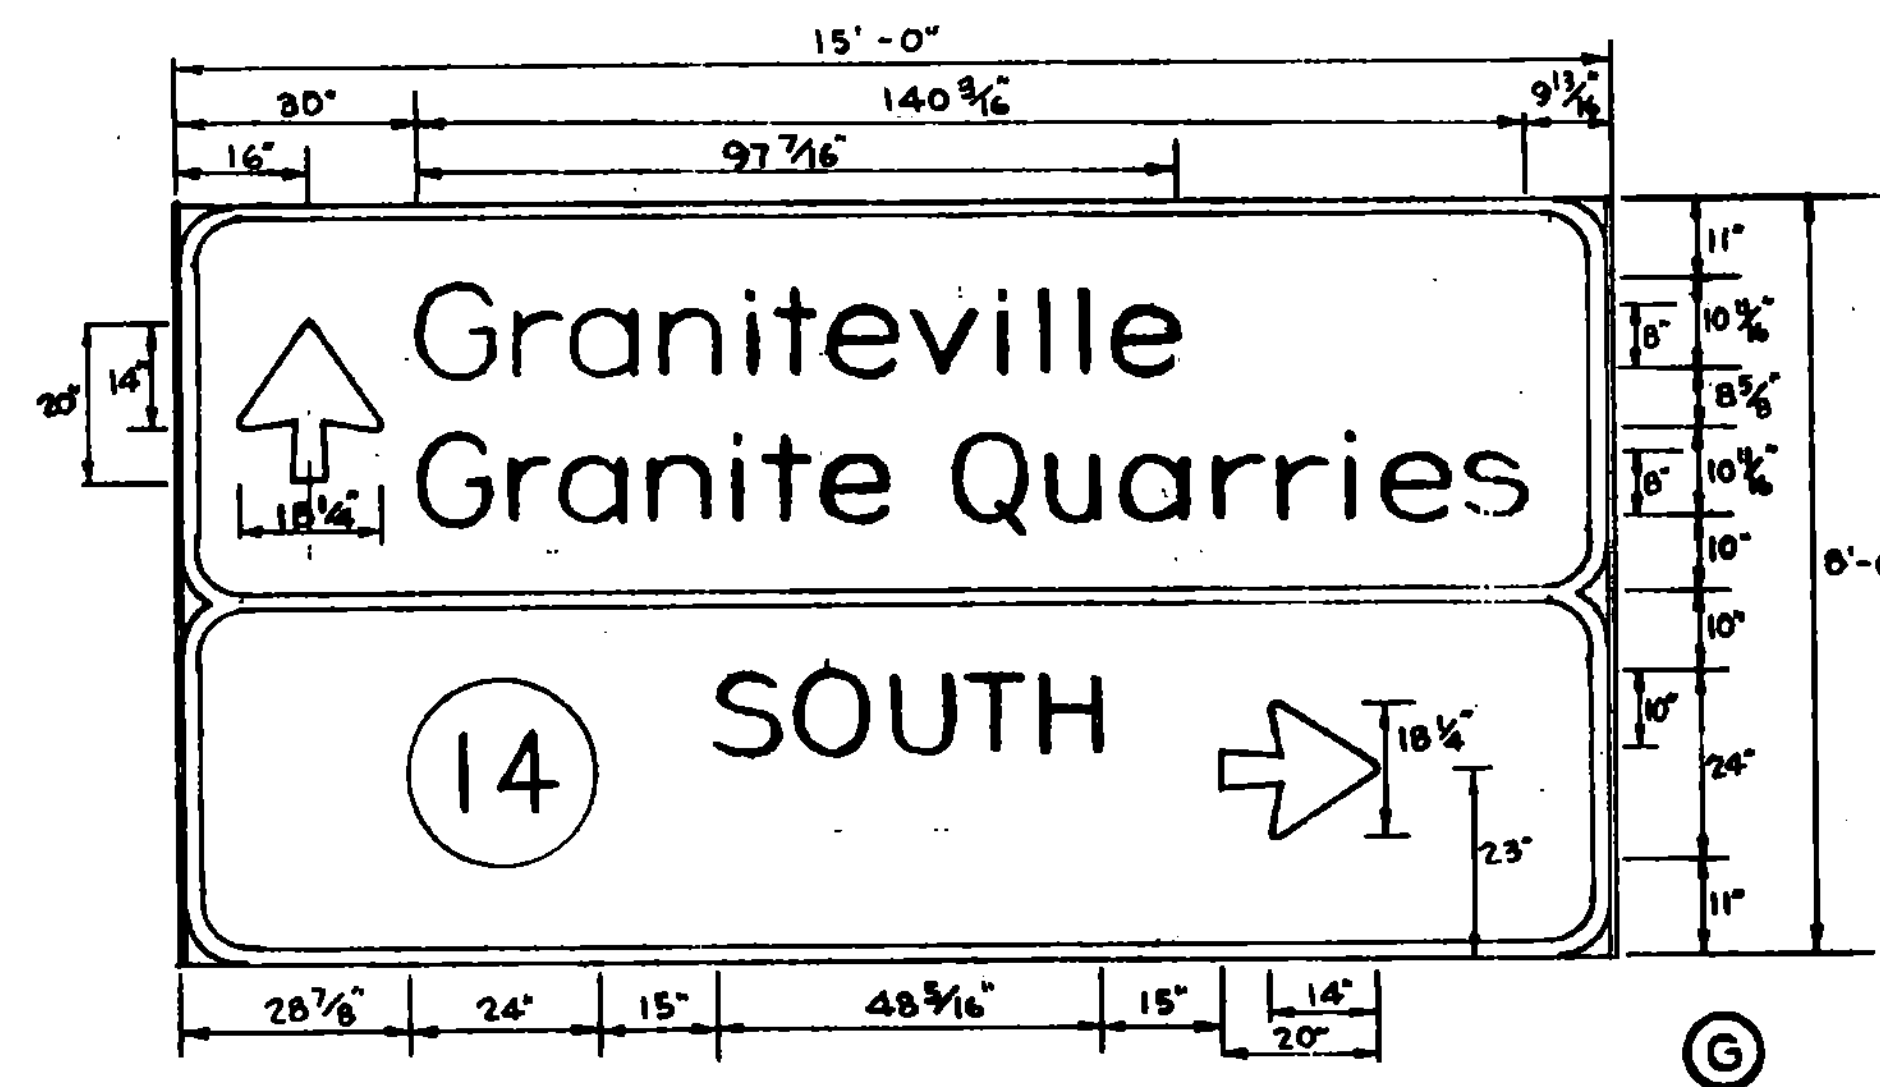
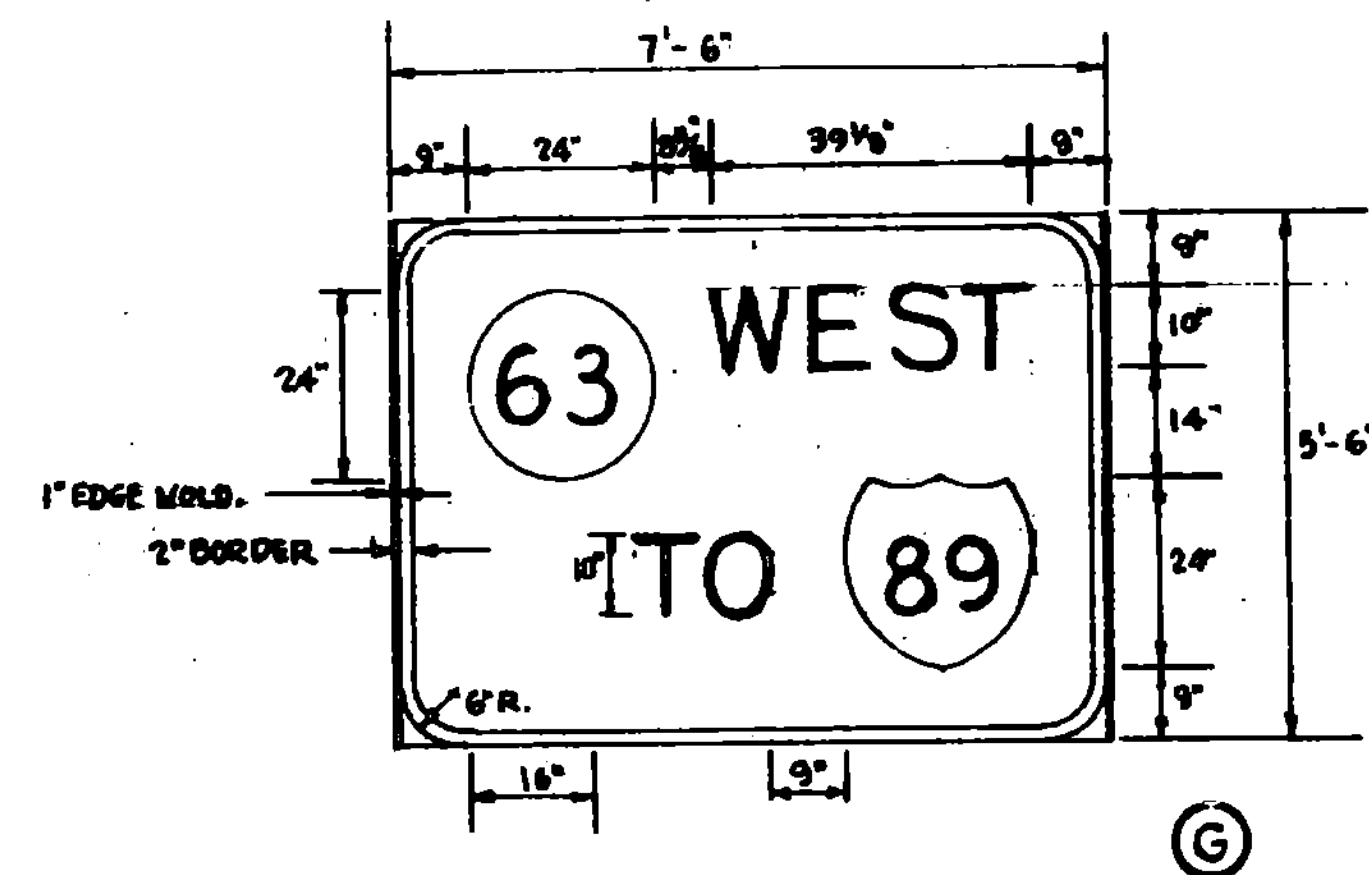
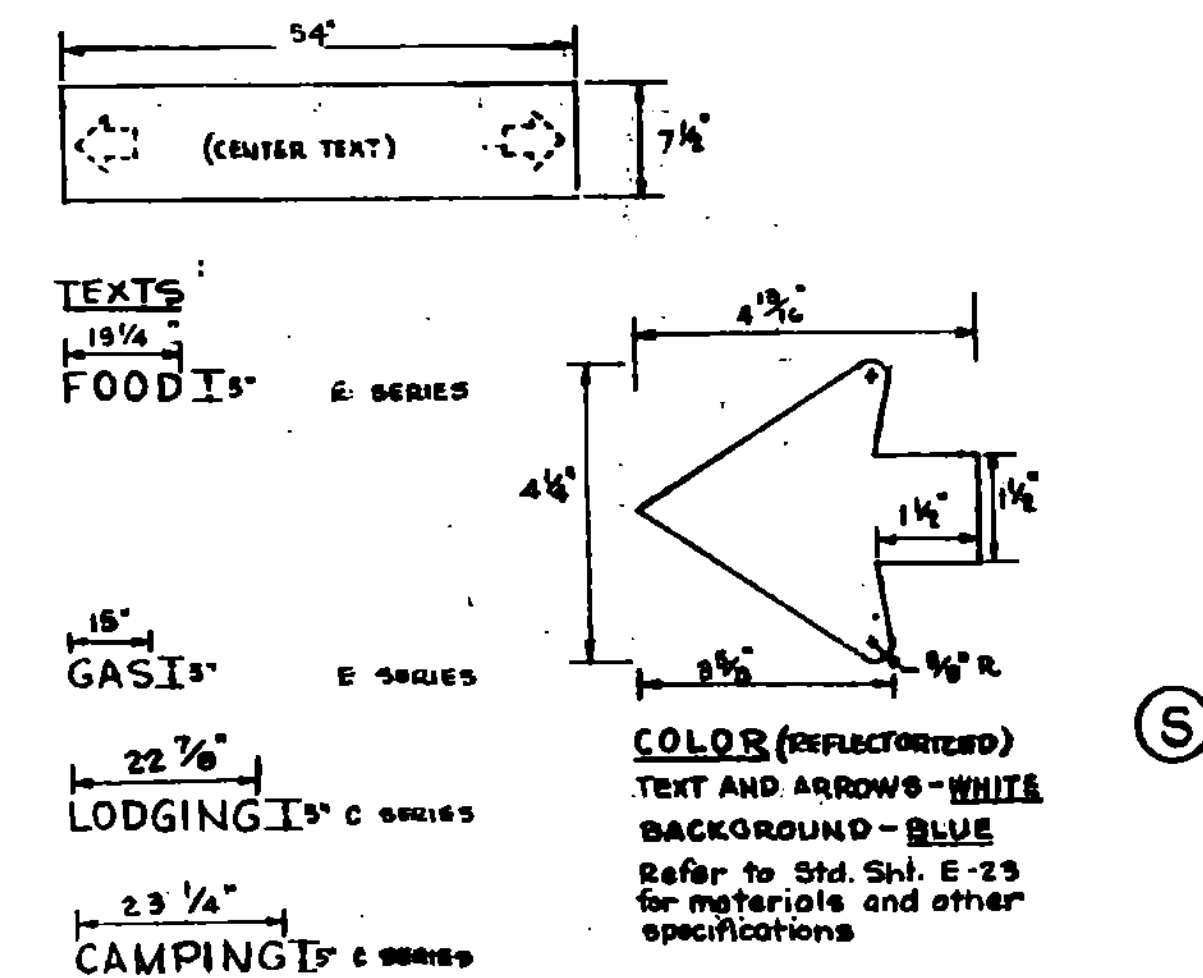
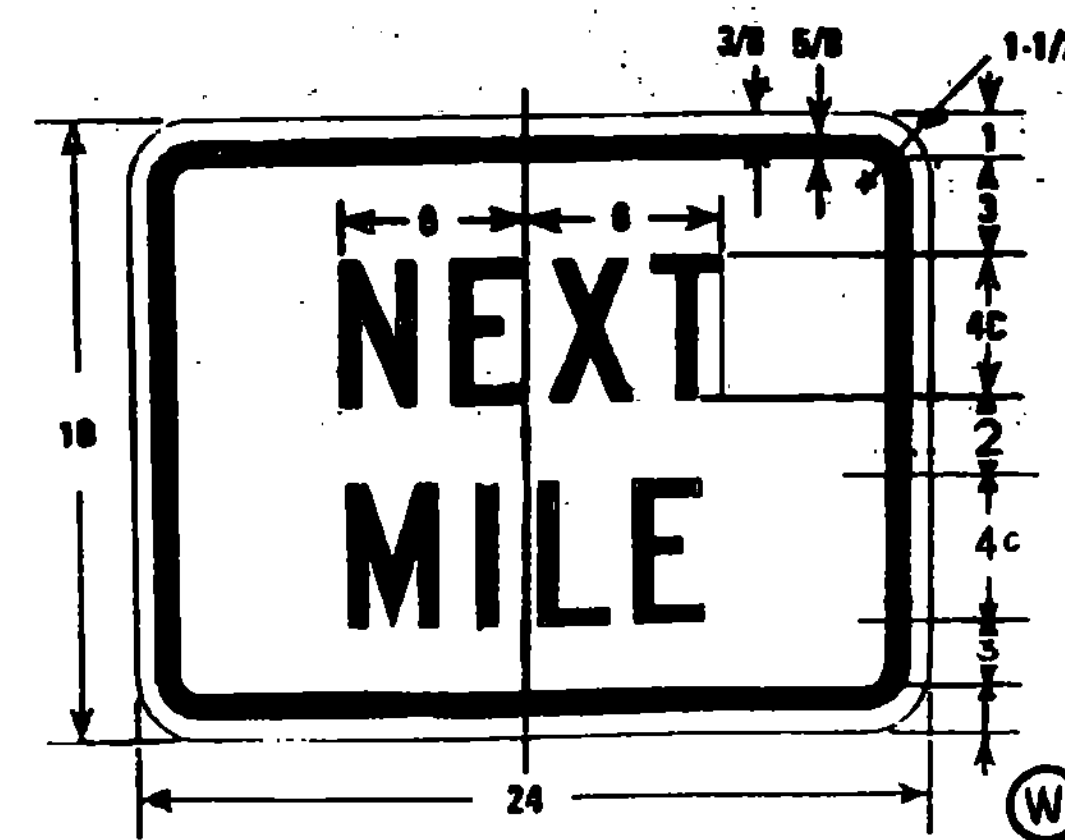


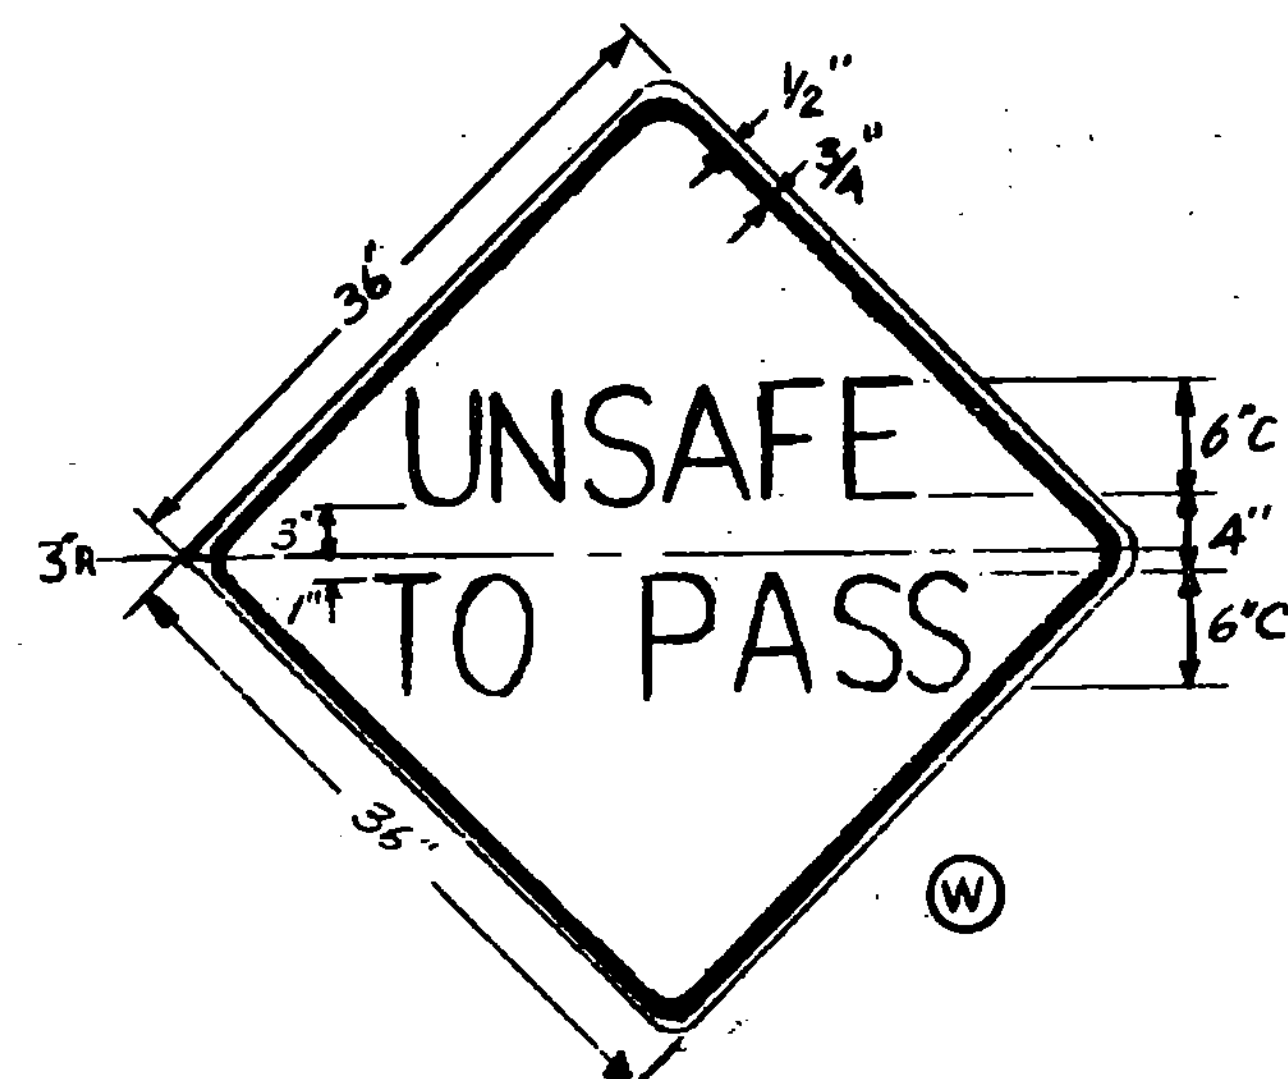

LEGEND

- (G) GUIDE SIGN
- (S) SERVICES SIGN
- (W) WARNING SIGN

SEE STANDARD SHTS. E-14, E-19 AND E-23 FOR APPROPRIATE COLORS, MATERIALS AND OTHER DETAILS.

SIGN DETAIL SHEET

CHECKED BY: BERLIN - BARRE
DATE: _____
PROJ. STATEWIDE NO. F-SFTY (85)
TRAFFIC SHEET NO. 543 SHEET 97 OF 200