



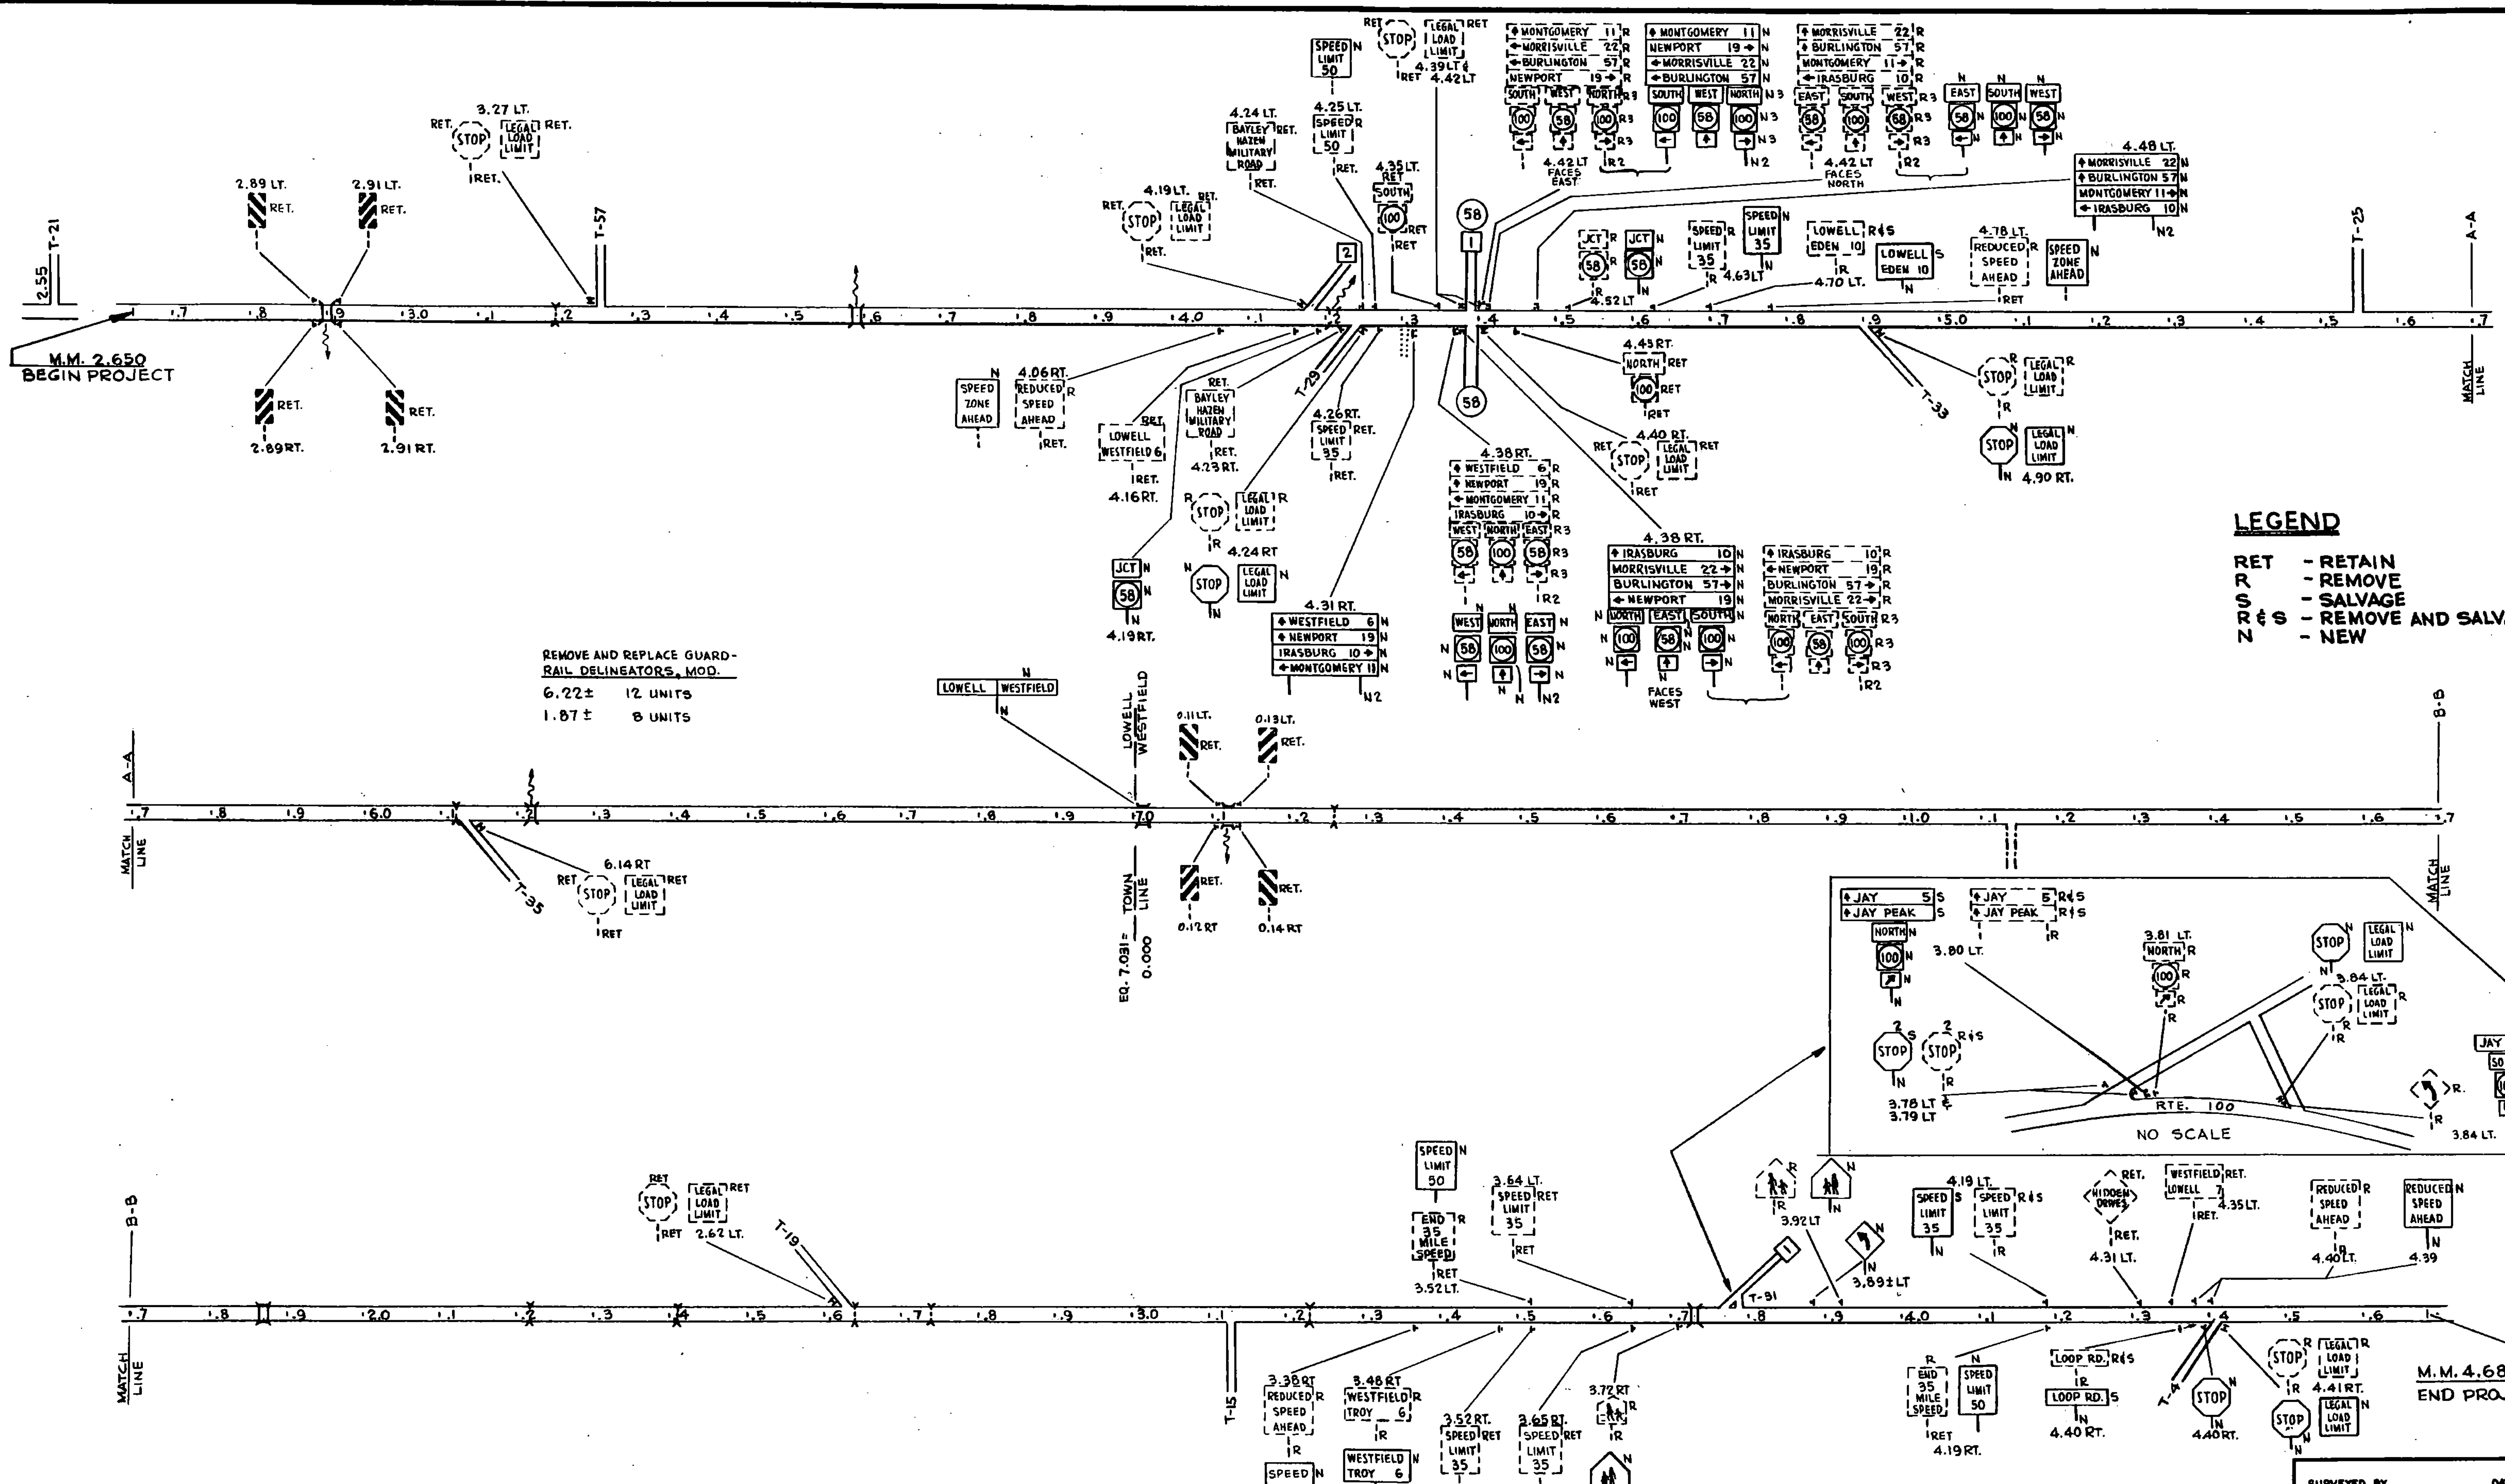

- LEGEND**
- RET - RETAIN
 - R - REMOVE
 - S - SALVAGE
 - R & S - REMOVE AND SALVAGE
 - N - NEW

REMOVE AND REPLACE GUARD-RAIL DELINEATORS, MOD.
6.22 ± 12 UNITS
1.87 ± 8 UNITS

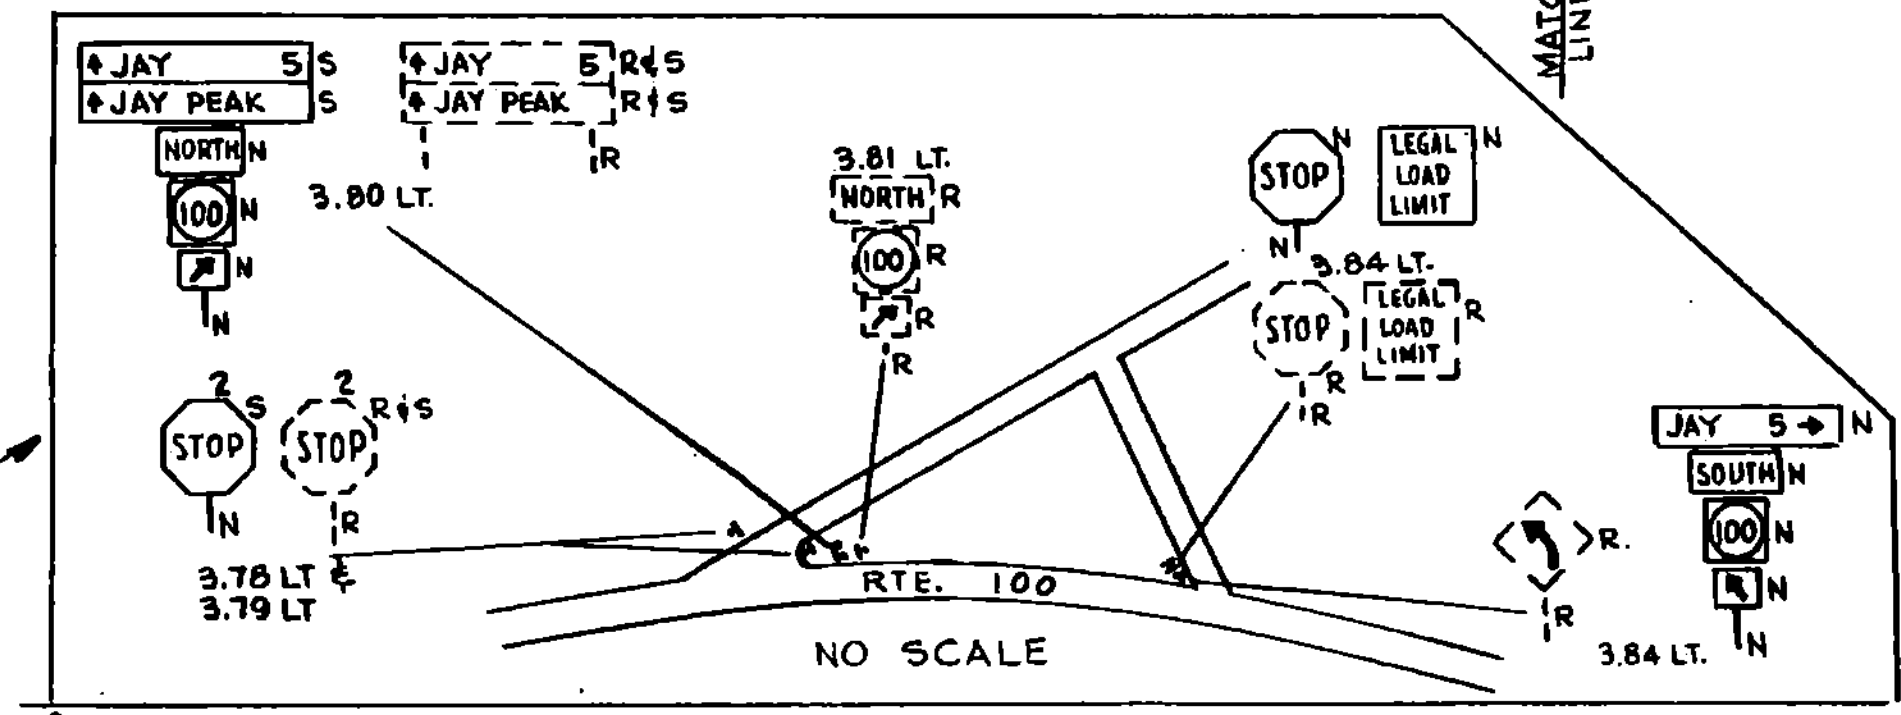

DATUM
VERTICAL _____
HORIZONTAL _____

0 0.1 0.2 MI.
SCALE

SURVEYED BY _____ DATE _____
DRAWN BY _____ DATE 9/15/85
TRACED BY _____ DATE _____
LOWELL - WESTFIELD
PROJ. STATEWIDE NO. F-SFTY (85) S
SHEET 105 OF 200