

[illegible]

TOTALS	COMMAN PROJECT	83	322.3	7	1040	228
--------	-------------------	----	-------	---	------	-----

TRAFFIC ITEM SUMMARY									
ITEM NUMBER	ITEM						ROUNDING	UNIT	TOTAL
675.20	TRAFFIC SIGNS, TYPE A	322.3					2.7	SF	325
675.30	FLANGED CHANNEL SIGN POSTS	1040					10	LB.	1050
675.32	TUBULAR ALUMINUM SIGN POSTS	228					7	LB.	235
675.50	REMOVING SIGNS	83					-	EA.	83
675.60	ERECTING SALVAGED SIGNS,	7					-	EA	7
676.13	REMOVE AND REPLACE GUARD RAIL DELINEATOR, TYPE A, MOD.	20					-	EA.	20
SEE SHEET TD 504 FOR PROJECT SUMMARY OF QUANTITIES AND REVISION NOTE FOR LEGAL LOAD LIMIT SIGNING									

SEE SHEET TD 504 FOR PROJECT SUMMARY OF QUANTITIES AND
REVISION NOTE FOR LEGAL LOAD LIMIT SIGNING

60"

1/2" WHITE (REFL.)

LOWELL WESTFIELD

5" 7 1/2"

COLORS:
TEXT - WHITE (REFL.)
BACKGROUND - GREEN (REFL.)

REDUCE LETTER SPACING 50%

SEE STD. DWG. E - 23 FOR MATERIALS

WESTFIELD TROY 6

18"

3"

5" 8"

3"

3"

3"


30" 1/2"

COLORS:
TEXT & BORDER - WHITE (REFL.)
BACKGROUND - GREEN (REFL.)

SEE STD. DWG. E - 23 FOR MATERIALS

SIGN @ M.M. 7.031 = 0.00 LT.

SIGN @ M.M. 3.48 RT.

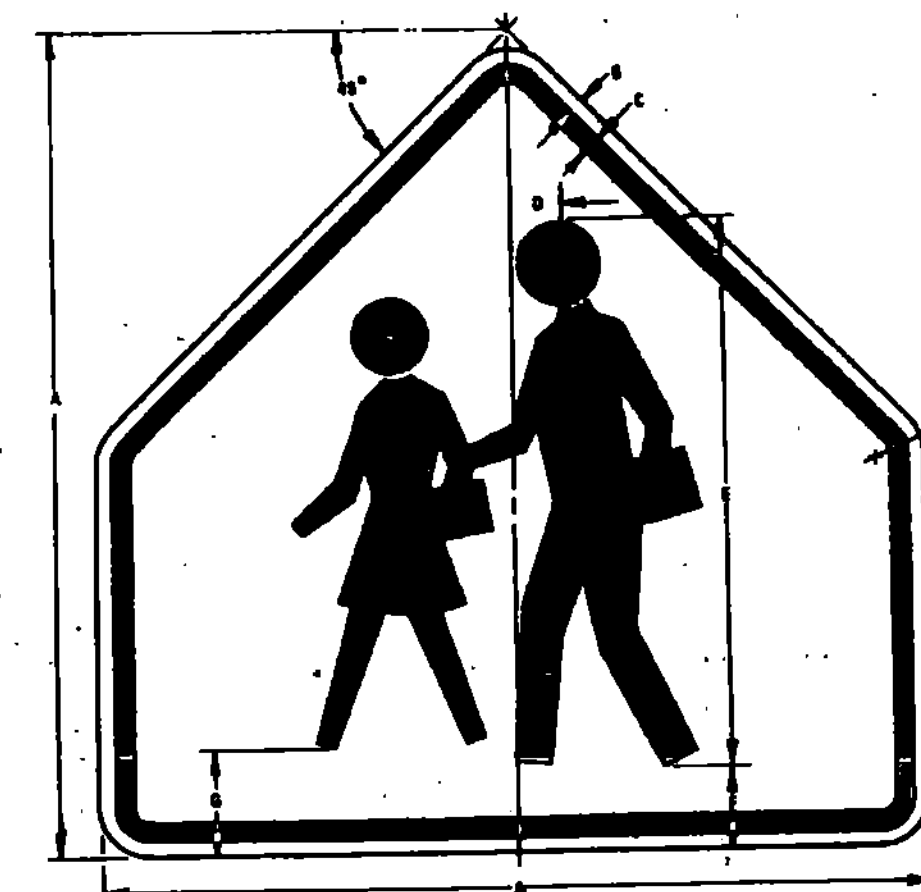

WGS	DIMENSIONS (INCHES)							
	A	B	C	D	E	F	G	H
STD. & REG.	20	1/2	3/4	1	20	3	3-04	1
EXWFF.	20	5/8	7/8	2-1/2	20	3-1/2	4-1/2	2
SPECIAL	40	3/4	1-1/4	3-3/4	22	5	5	

LEGEND - BLACK (NON-REF)
BACKGROUND - YELLOW

SIGNS @ M.M.S 3.72Rt & 3.92Lt.

ITEM SUMMARY AND SIGN DETAILS SHEET

TRAFFIC STREET NO. 522 STREET

SURVEYED BY _____ DATE _____
DRAWN BY _____ DATE _____
TRACED BY _____ DATE _____

LOWELL-WESTFIELD

PROJ. NO.
STATEWIDE F-SFTY (85) S
SHEET 109 OF 200