


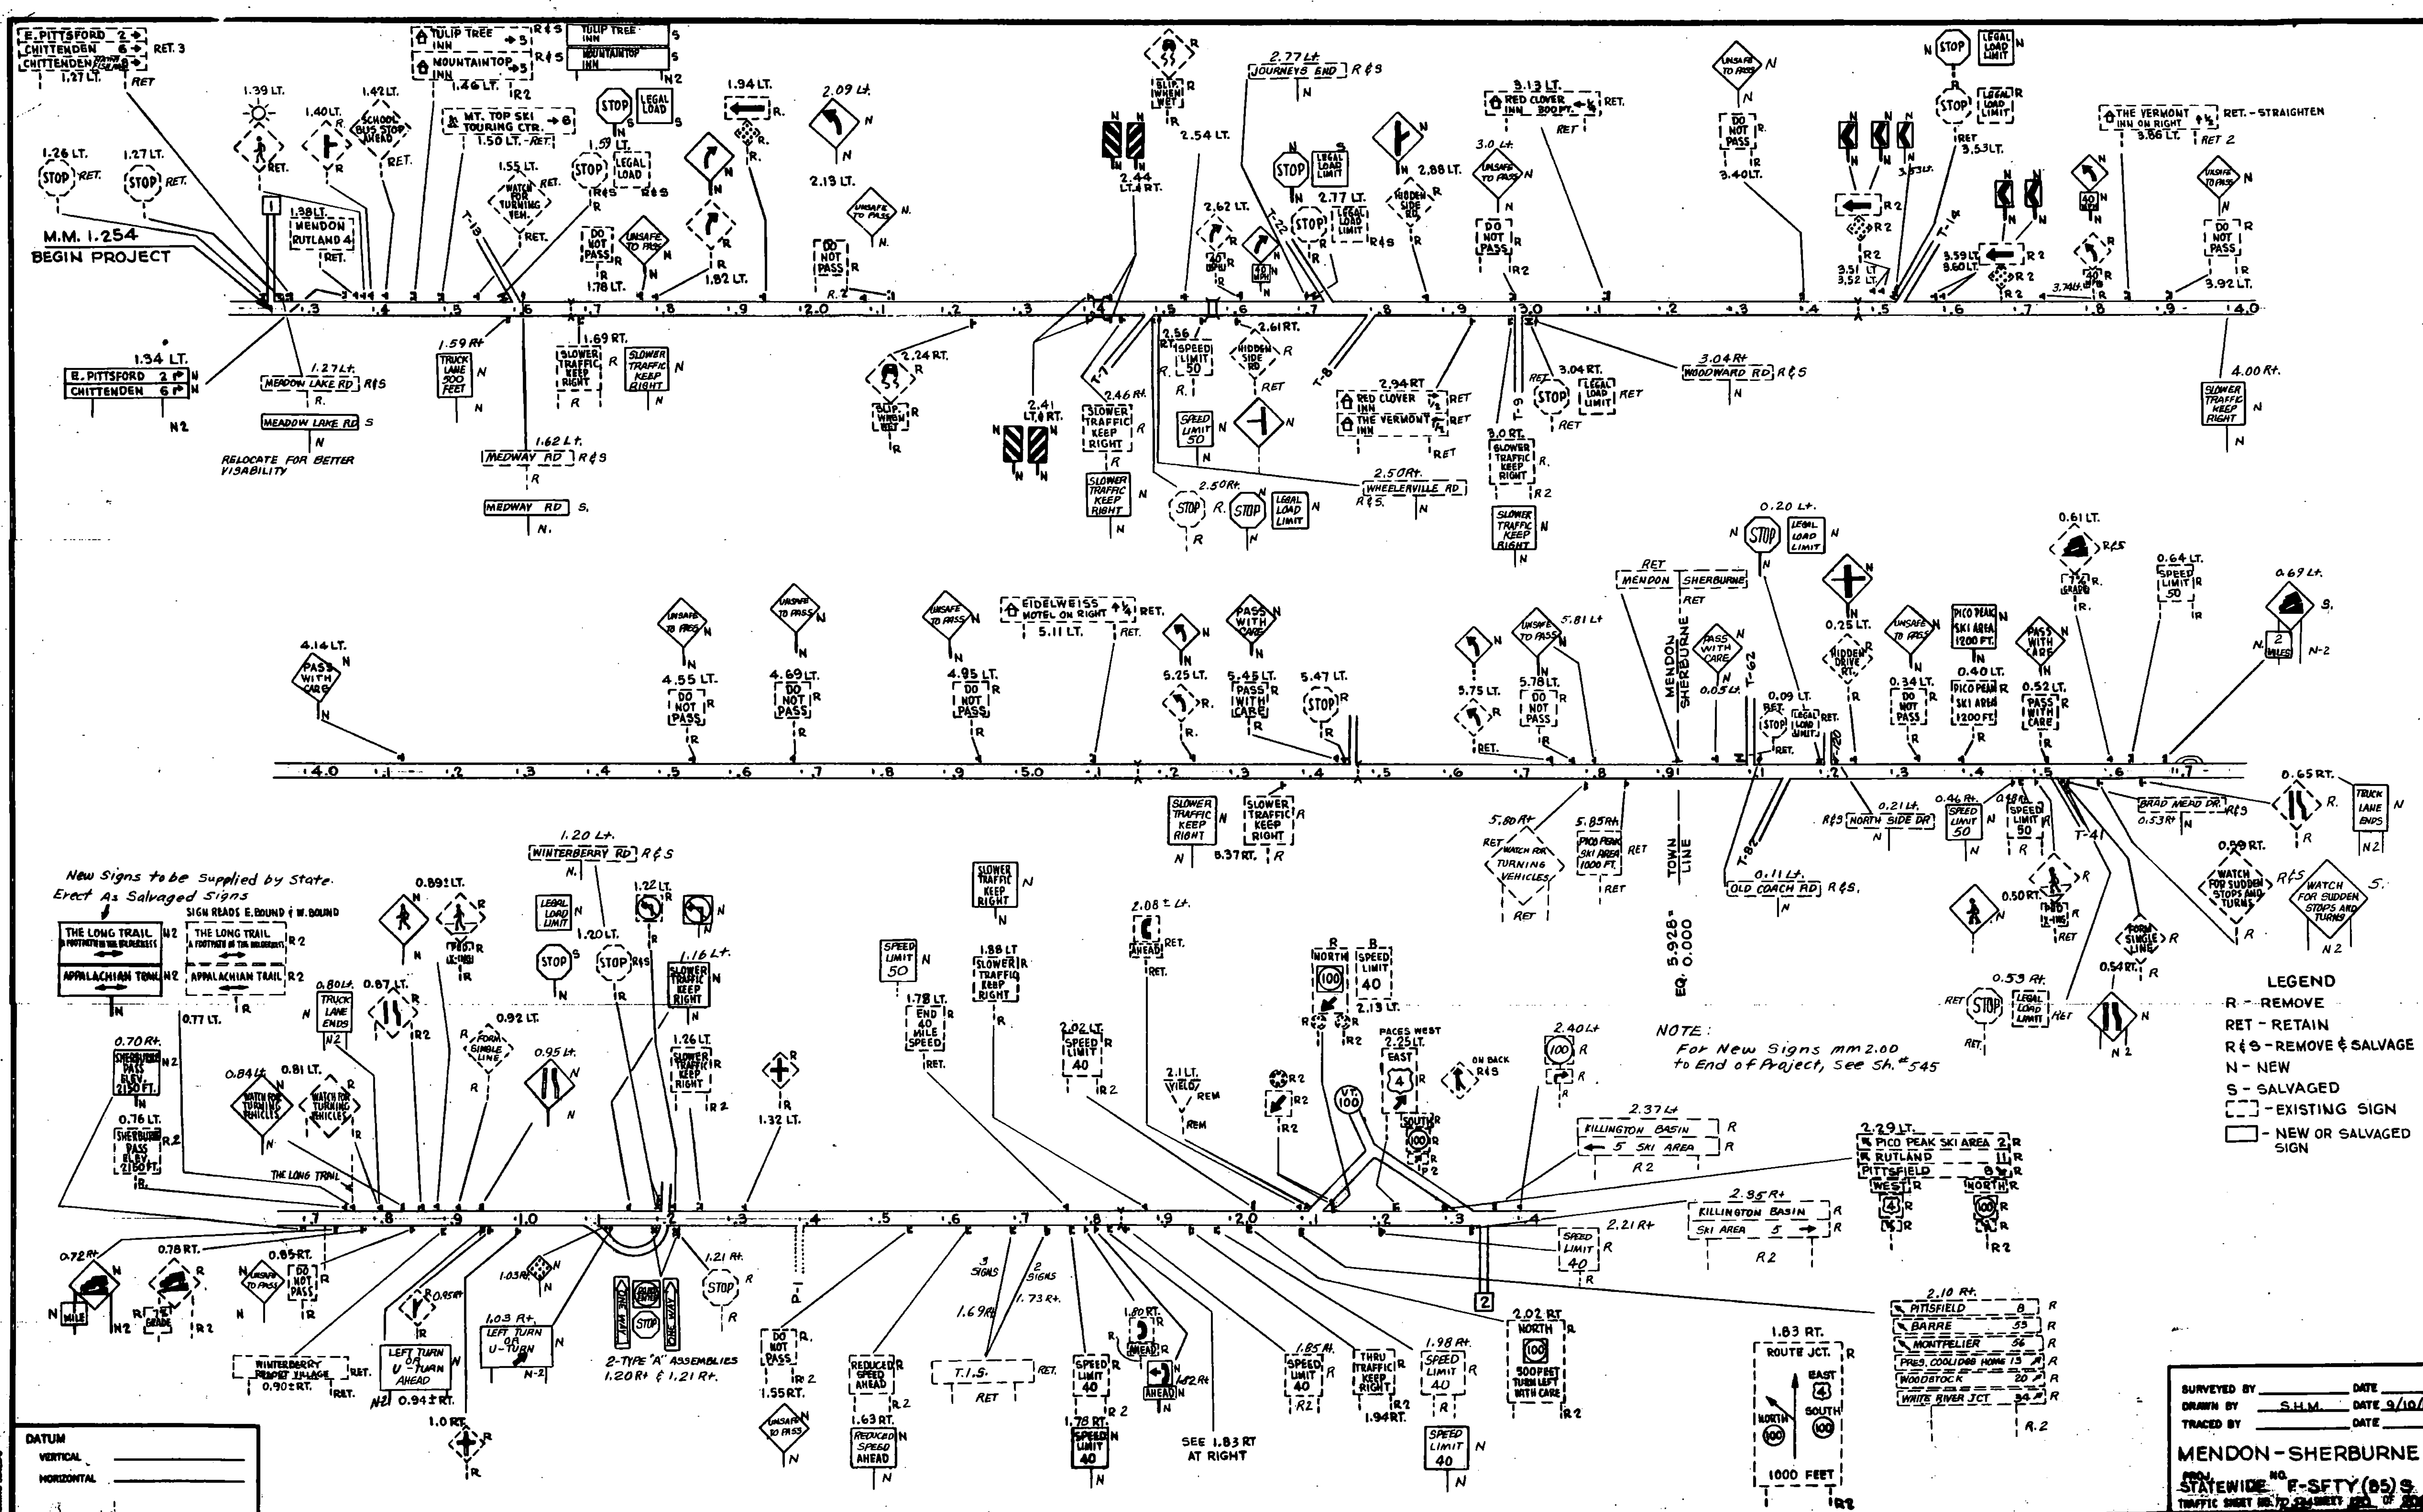

SURVEYED BY _____ DATE _____
 DRAWN BY S.H.M. DATE 9/10/85
 TRACED BY _____ DATE _____

MENDON - SHERBURNE
STATEWIDE F-SFTY (85) S
TRAFFIC SHORT REPORT SUBMITTAL NO. 200