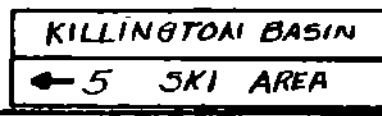


TRAFFIC SIGN SUMMARY SHEET

MILEMARKER, STATION, OR SIGN NUMBER	SIGN LEGEND	SIGN DIMENSIONS	EXISTING SIGNS		NEW AND SALVAGED SIGNS				EXISTING POSTS				NEW SIGN POSTS											REMARKS	FOR SIGN DETAIL SHEET		
			TO BE SALVAGED REMOVE (EA.)	RETAIN (X)	NEW 'A' (S.F.)	NEW 'B' (S.F.)	SALV. SIGN (EA.)	SALV. T.I.S.(S.F.)	RET.	DRILL	REM.	SALV.	NUMBER OF POSTS	FLANGED CHANNEL			TUBULAR ALUMINUM				W SHAPED STEEL				PLAN SHEET NUMBER	STD. SHEET NUMBER	
														2.0 LB./FT.	2.5 LB./FT.	3.0 LB./FT.	3.0" Ø	3.0" □	4.0" Ø	4.0" Ø MOD.	POST SIZE	WEIGHT	FTG. SIZE 24" 30"				
--237-Lt.			2								X(2)																
--237-Lt.		72" X 10"			5.0								2				X								E-23		
--237-Lt.		72" X 10"			5.0																				E-23		
--237-Lt.		72" X 20"			10.0																				E-23		
--237-Lt.		72" X 10"			5.0																				E-23		
--240-Lt.			1								X																
--241-Lt.		24" X 12"			2.0								1			X									E-13		
--241-Lt.		24" X 24"			4.0																				E-13		
--241-Lt.		21" X 15"			2.2																				E-13		
WEST APPROACH TO VT 100-NORTH	 6 EA.	(6 EA.) 18" X 24"			18.0								6	X											E-19		
EAST APPROACH TO VT 100-NORTH	 6 EA.	(6 EA.) 18" X 24"			18.0								6	X											E-19		
TOTALS			4		69.2*								15	336*		54*	68*										

FINAL LENGTHS ARE TO BE DETERMINED IN THE FIELD. POST SIZES ARE COMPUTED BASED ON INFORMATION FURNISHED ON THE STANDARD SHEETS AND THE DESIGN DIVISION'S "SIGN POST DESIGN MANUAL".

PREPARED BY J.B. DATE 1-86
CHECKED BY DATE
MENDON-SHERBURNE
PROJECT STATEWIDE NO. F-5FTY(85)3
TRAFFIC SHEET NO. 256 SHEET 12 OF 200