



MAINLINE PROFILE - VT. ROUTE 44

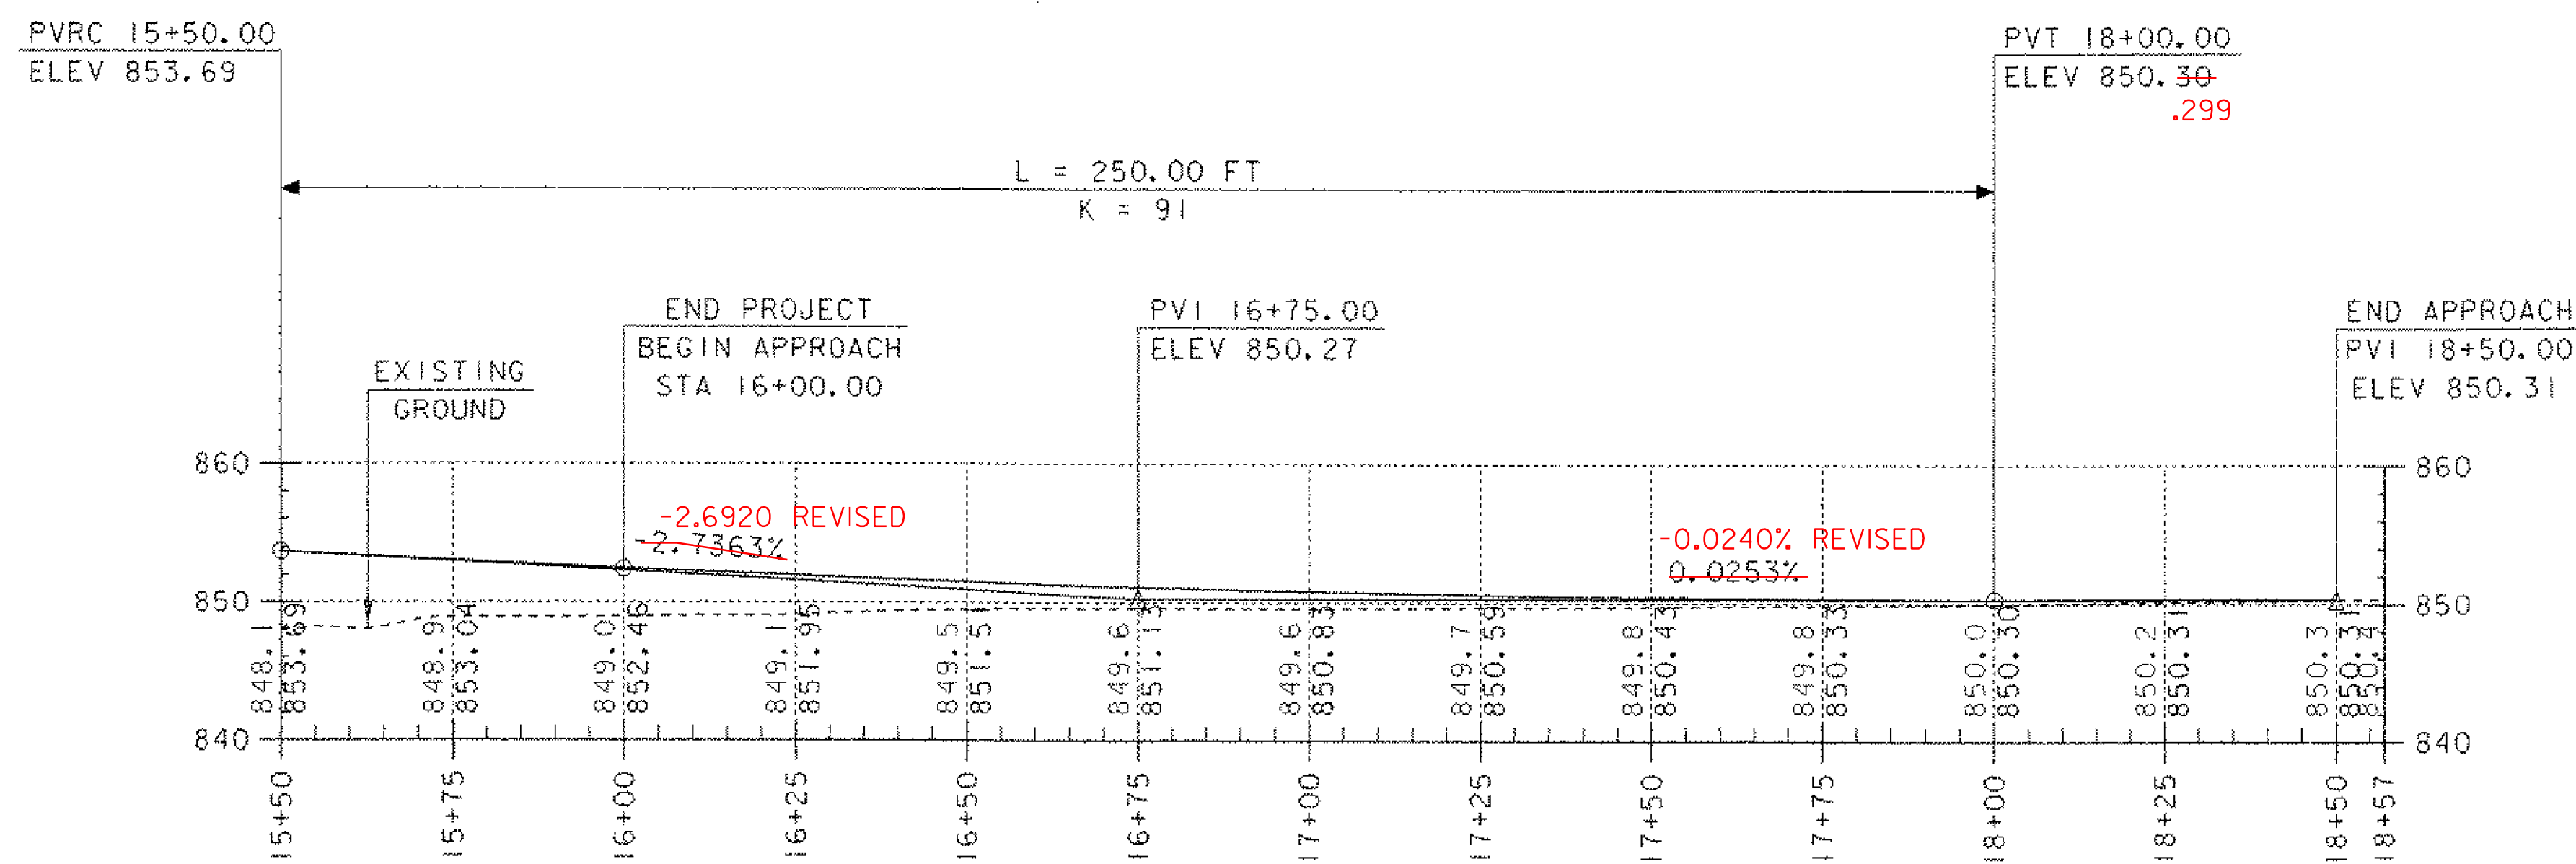

MAINLINE PROFILE (CONT'D) - VT. ROUTE 44

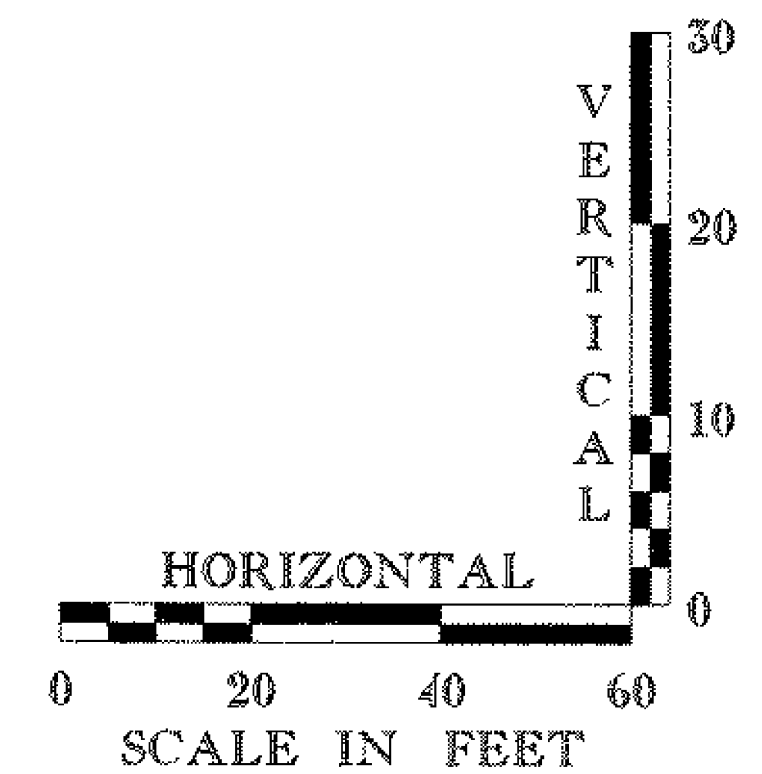

GRADES SHOWN TO THE NEAREST TENTH
 ARE OLD GROUND ALONG THE PROPOSED ALIGNMENT.
 GRADES SHOWN TO THE NEAREST HUNDREDTH
 ARE FINISHED GRADES ALONG THE PROPOSED ALIGNMENT.

SHEET NAME: MAILINE PROFILE SHEET	
PROJECT NAME: READING	HIGHWAY NO.: VT 44
PROJECT NUMBER: BRS 0148(6)S	BRIDGE NO.: 1
	OVER: THE MILL BROOK
FILE NAME: PW/85e034/Structures/se034xsl.dgn	PLOT DATE: 17-FEB-2006
PROJECT MANAGER: R. WHITCOMB	DRAWN BY: J. GILMORE
DESIGNED BY: C. CARLSON	IPARM NAME: se034mpl1
BRIDGE SHEET NUMBER:	SHEET 14 OF 83