



PARKING PROFILE
(DRIVE 1)

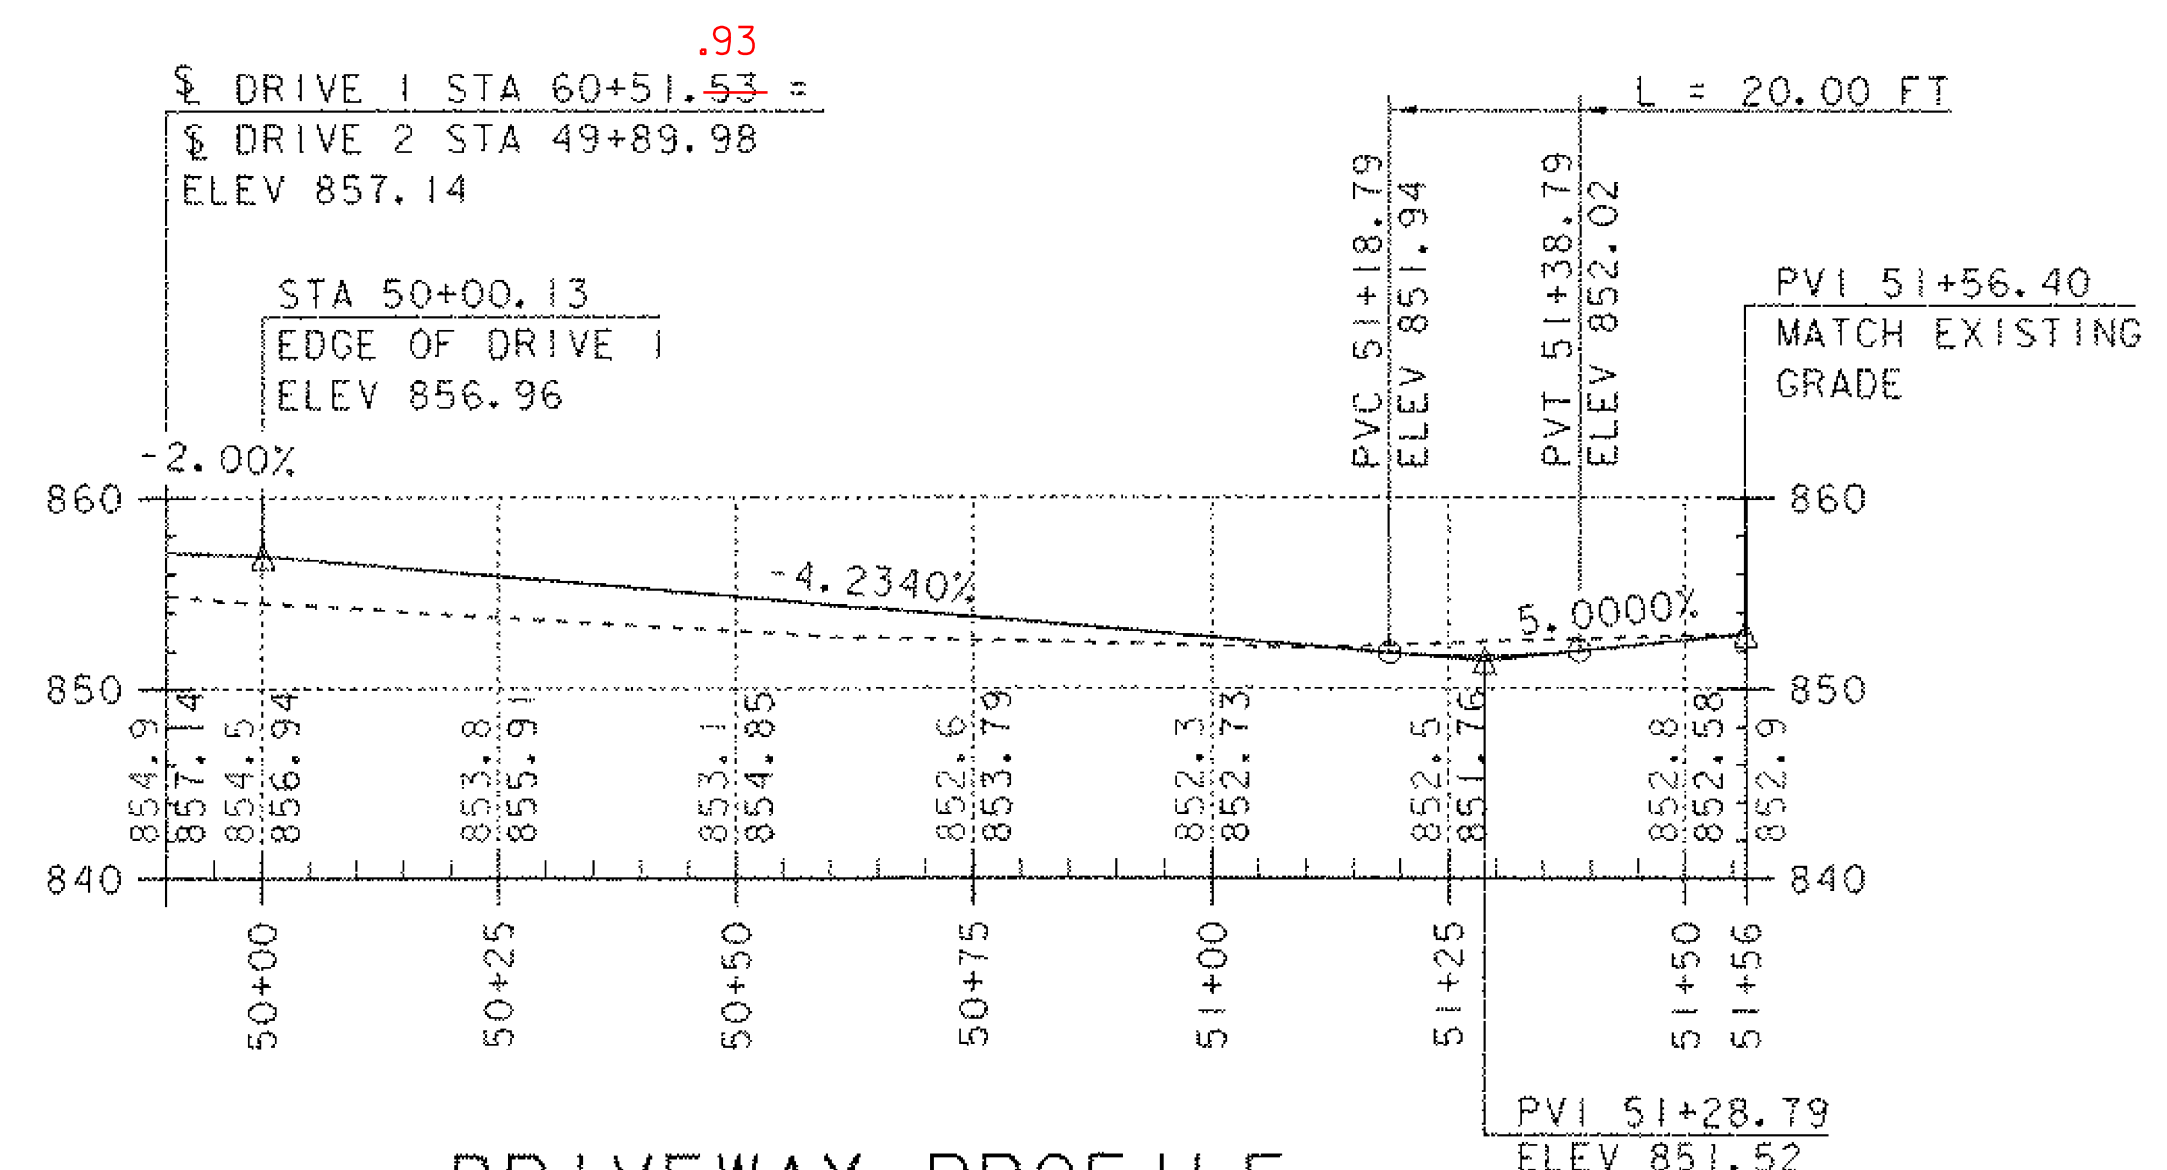

DRIVEWAY PROFILE
(DRIVE 2)

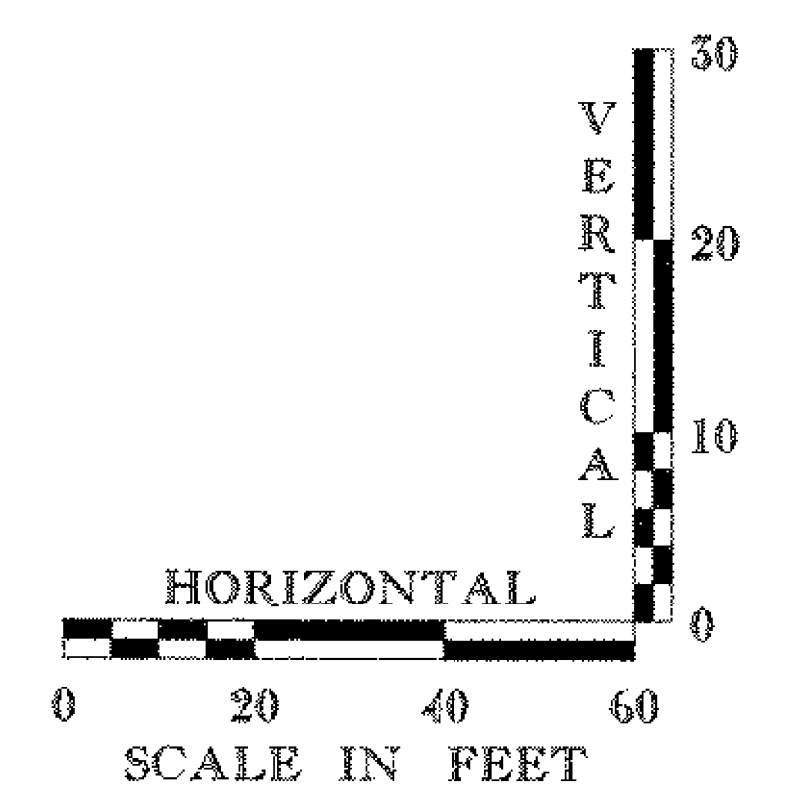

GRADES SHOWN TO THE NEAREST TENTH
ARE OLD GROUND ALONG THE PROPOSED ALIGNMENT.
GRADES SHOWN TO THE NEAREST HUNDREDTH ARE FINISHED
GRADES ALONG THE PROPOSED ALIGNMENT.

SHEET NAME: PARKING LOT DRIVE & DRIVEWAY PROFILE SHEET	
PROJECT NAME: READING	HIGHWAY NO.: VT 44
PROJECT NUMBER: BRS 0148(6)S	BRIDGE NO.: 1
	OVER: THE MILL BROOK
FILE NAME: PW/85e034/Structures/ee034xsl.dgn	PLOT DATE: 17-FEB-2006
PROJECT MANAGER: R. WHITCOMB	DRAWN BY: G. ROY
DESIGNED BY: C. CARLSON	IPARM NAME: ee034dpl.i
BRIDGE SHEET NUMBER:	SHEET 16 OF 83