


MATCH LINE

STATION 14+75

MATCH LINE

LEGEND

→ EXISTING DRAINAGE

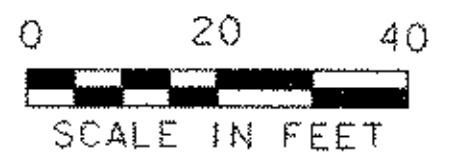

SHEET NAME: EXISTING CONDITIONS SITE PLAN #1	
PROJECT NAME: READING	HIGHWAY NO.: VT 44
PROJECT NUMBER: BRS 0148(6)S	BRIDGE NO.: 1
	OVER: THE MILL BROOK
FILE NAME: PW/95e034/Structures/se034eobdr.dgn	PLOT DATE: 17-FEB-2006
PROJECT MANAGER: R. WHITCOMB	DRAWN BY: M. HALE
DESIGNED BY: C. CARLSON	IPARM NAME: se034ecl1
BRIDGE SHEET NUMBER:	SHEET 23 OF 83