


EROSION AND SEDIMENT CONTROL INDEX	
NO.	DESCRIPTION
①	INSTALL CONTINUOUS LINE OF SILT FENCE
②	INSTALL SHORT SECTIONS TO CREATE PONDING OF RUNOFF ALONG FENCE ENDS OF FENCE TURNED UPHILL TO CREATE PONDING
③	PROJECT LIMITS DEMARCATION FENCE (SNOW FENCE (MOD.-PDF))
④	INSTALL FILTER CURTAIN
⑤	INSTALL SEDIMENT BASIN (PROPOSED LOCATION)
⑥	INSTALL STONE FILL, TYPE I (MOD. - INLET PROTECTION)
⑦	INSTALL EROSION MATTING FOR SPECIAL DITCH

NOTE: ALL DISTURBED AREAS WITH SLOPES GREATER THAN 1V:3H WILL REQUIRE TEMPORARY EROSION MATTING (SEE EROSION CONTROL DETAILS SHEET)

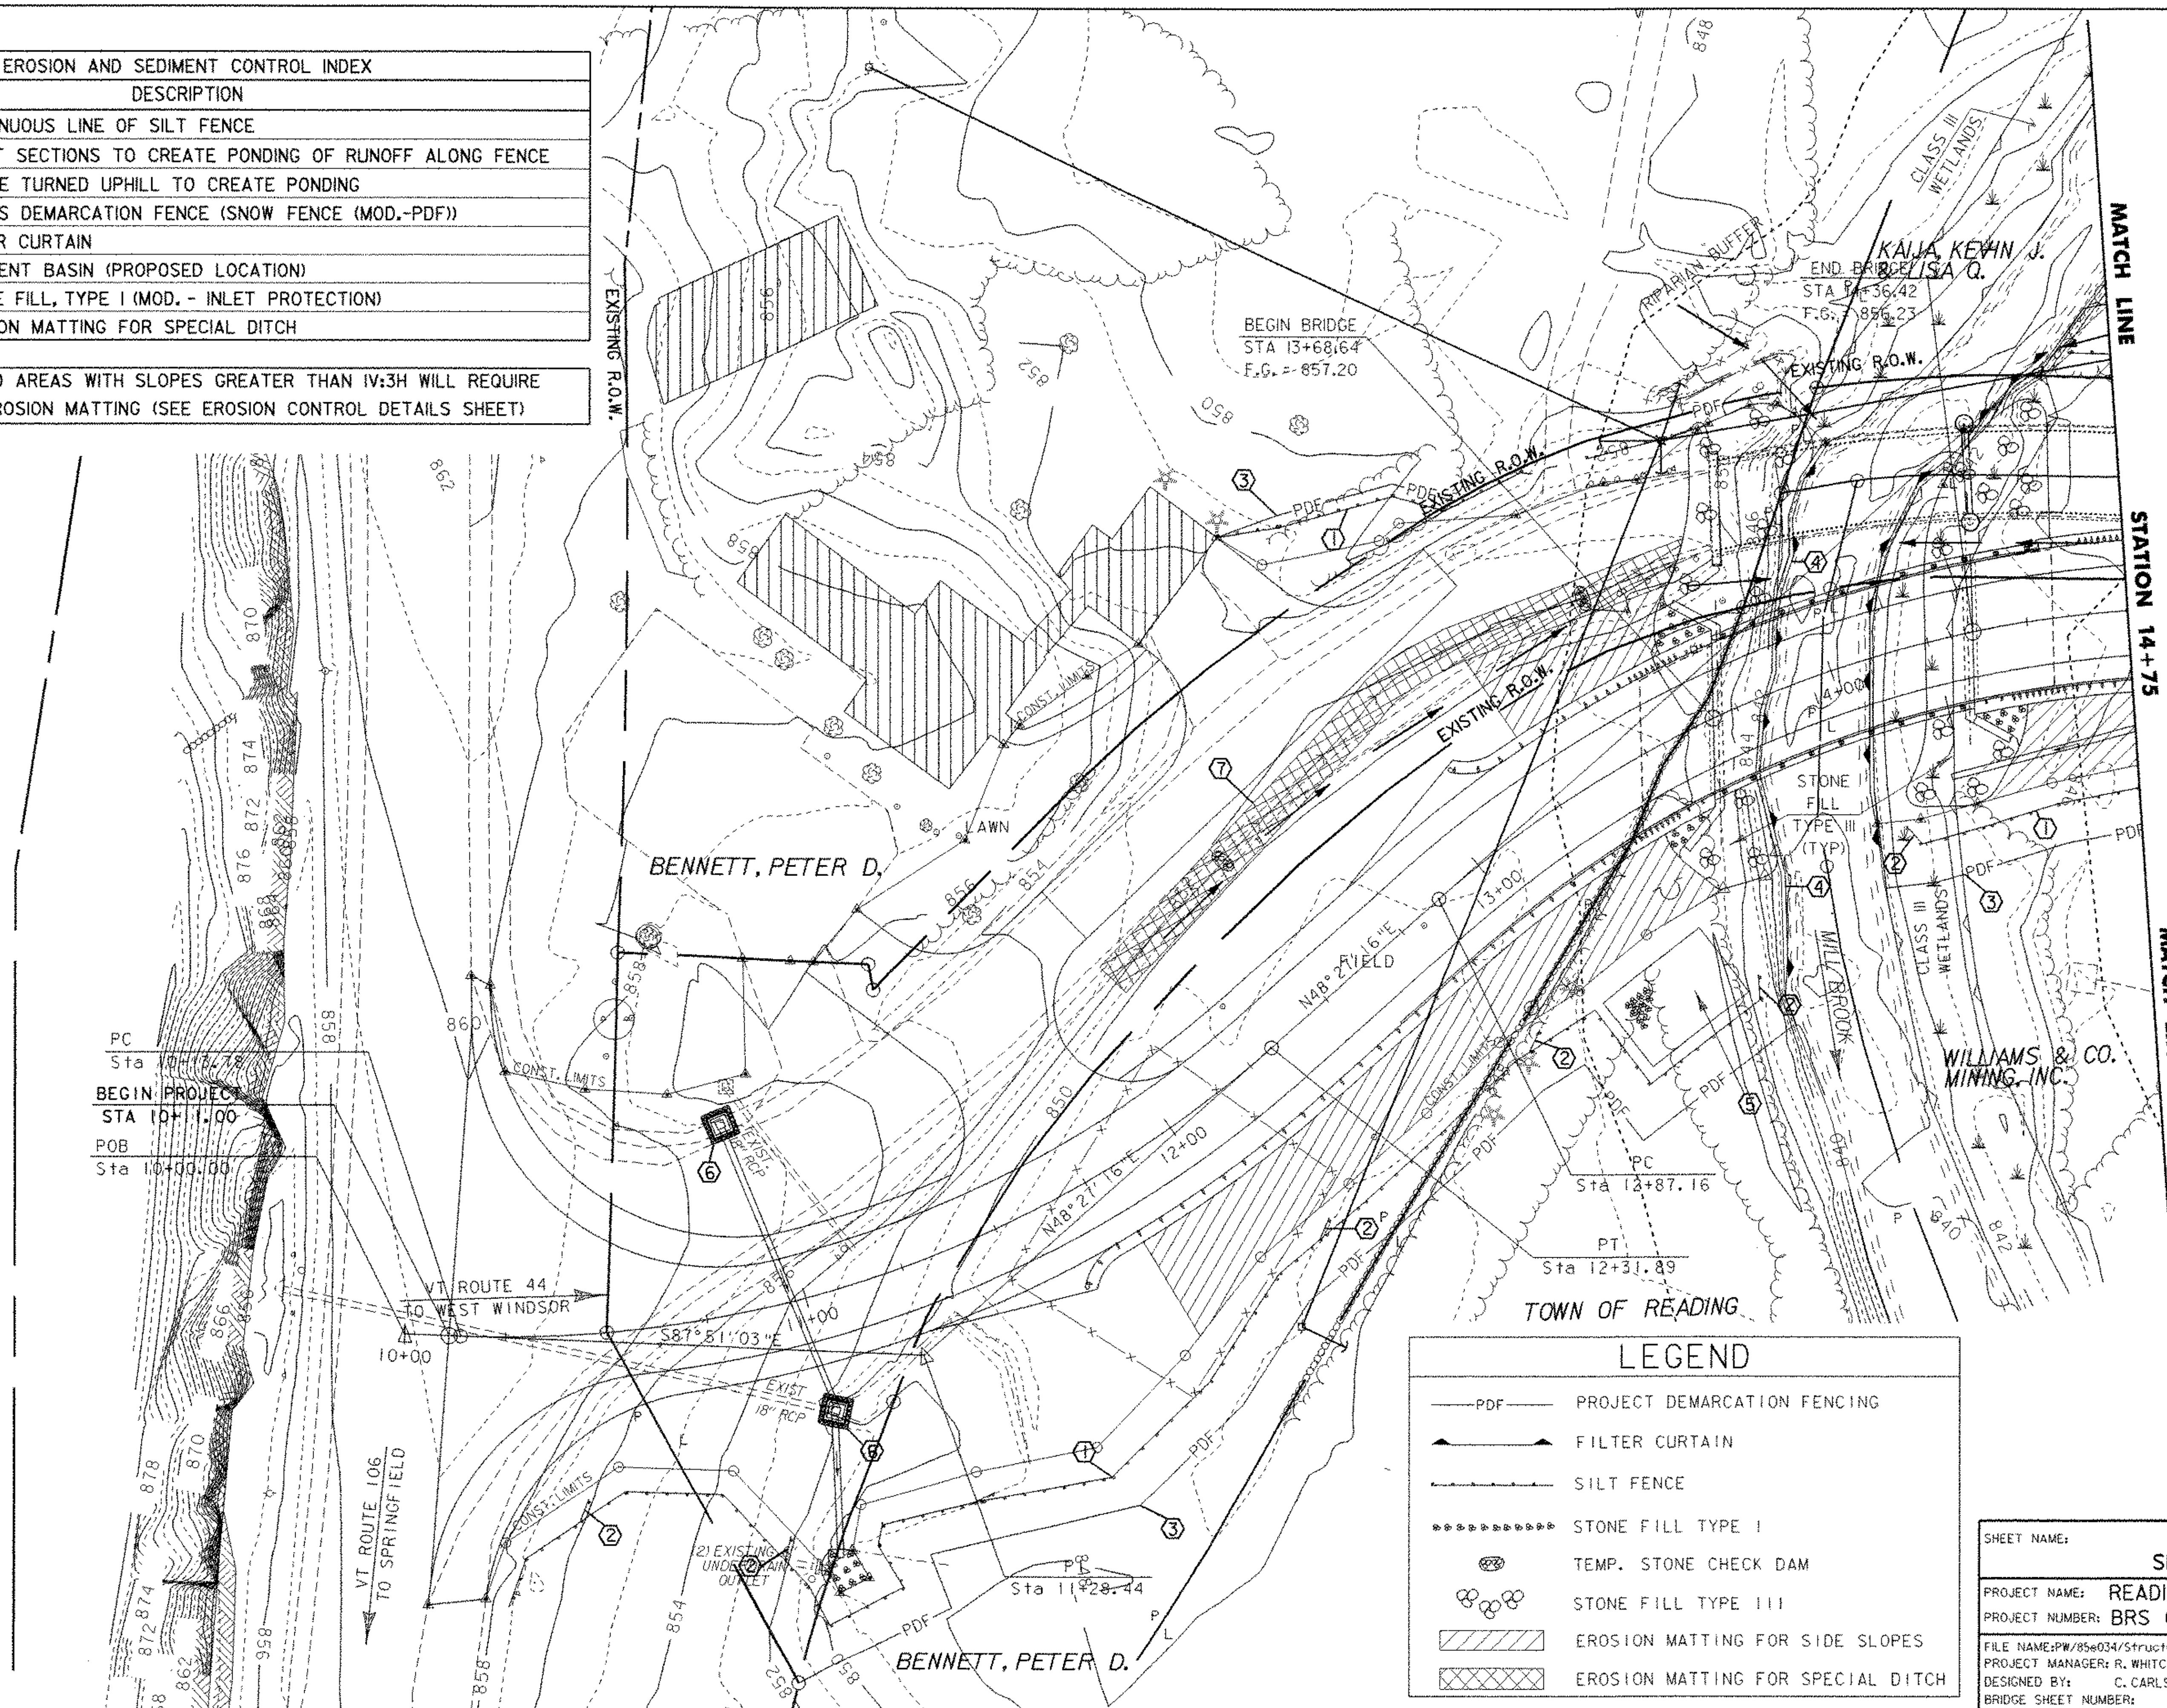

SHEET NAME: <b>EROSION PREVENTION AND SEDIMENT CONTROL PLAN #1</b>	
PROJECT NAME: <b>READING</b>	HIGHWAY NO.: <b>VT 44</b>
PROJECT NUMBER: <b>BRS 0148(6)S</b>	BRIDGE NO.: <b>1</b>
	OVER: <b>THE MILL BROOK</b>
FILE NAME: <b>PW/85e034/Structures/se034ecbdr.dgn</b>	PLOT DATE: <b>17-FEB-2006</b>
PROJECT MANAGER: <b>R. WHITCOMB</b>	DRAWN BY: <b>M. HALE</b>
DESIGNED BY: <b>C. CARLSON</b>	IPARM NAME: <b>se034ec3.i</b>
BRIDGE SHEET NUMBER:	SHEET <b>25</b> OF <b>83</b>