


GUARD RAIL AND APPROACH RAIL LAYOUT

20 0 20
SCALE: 1" = 20'-0"

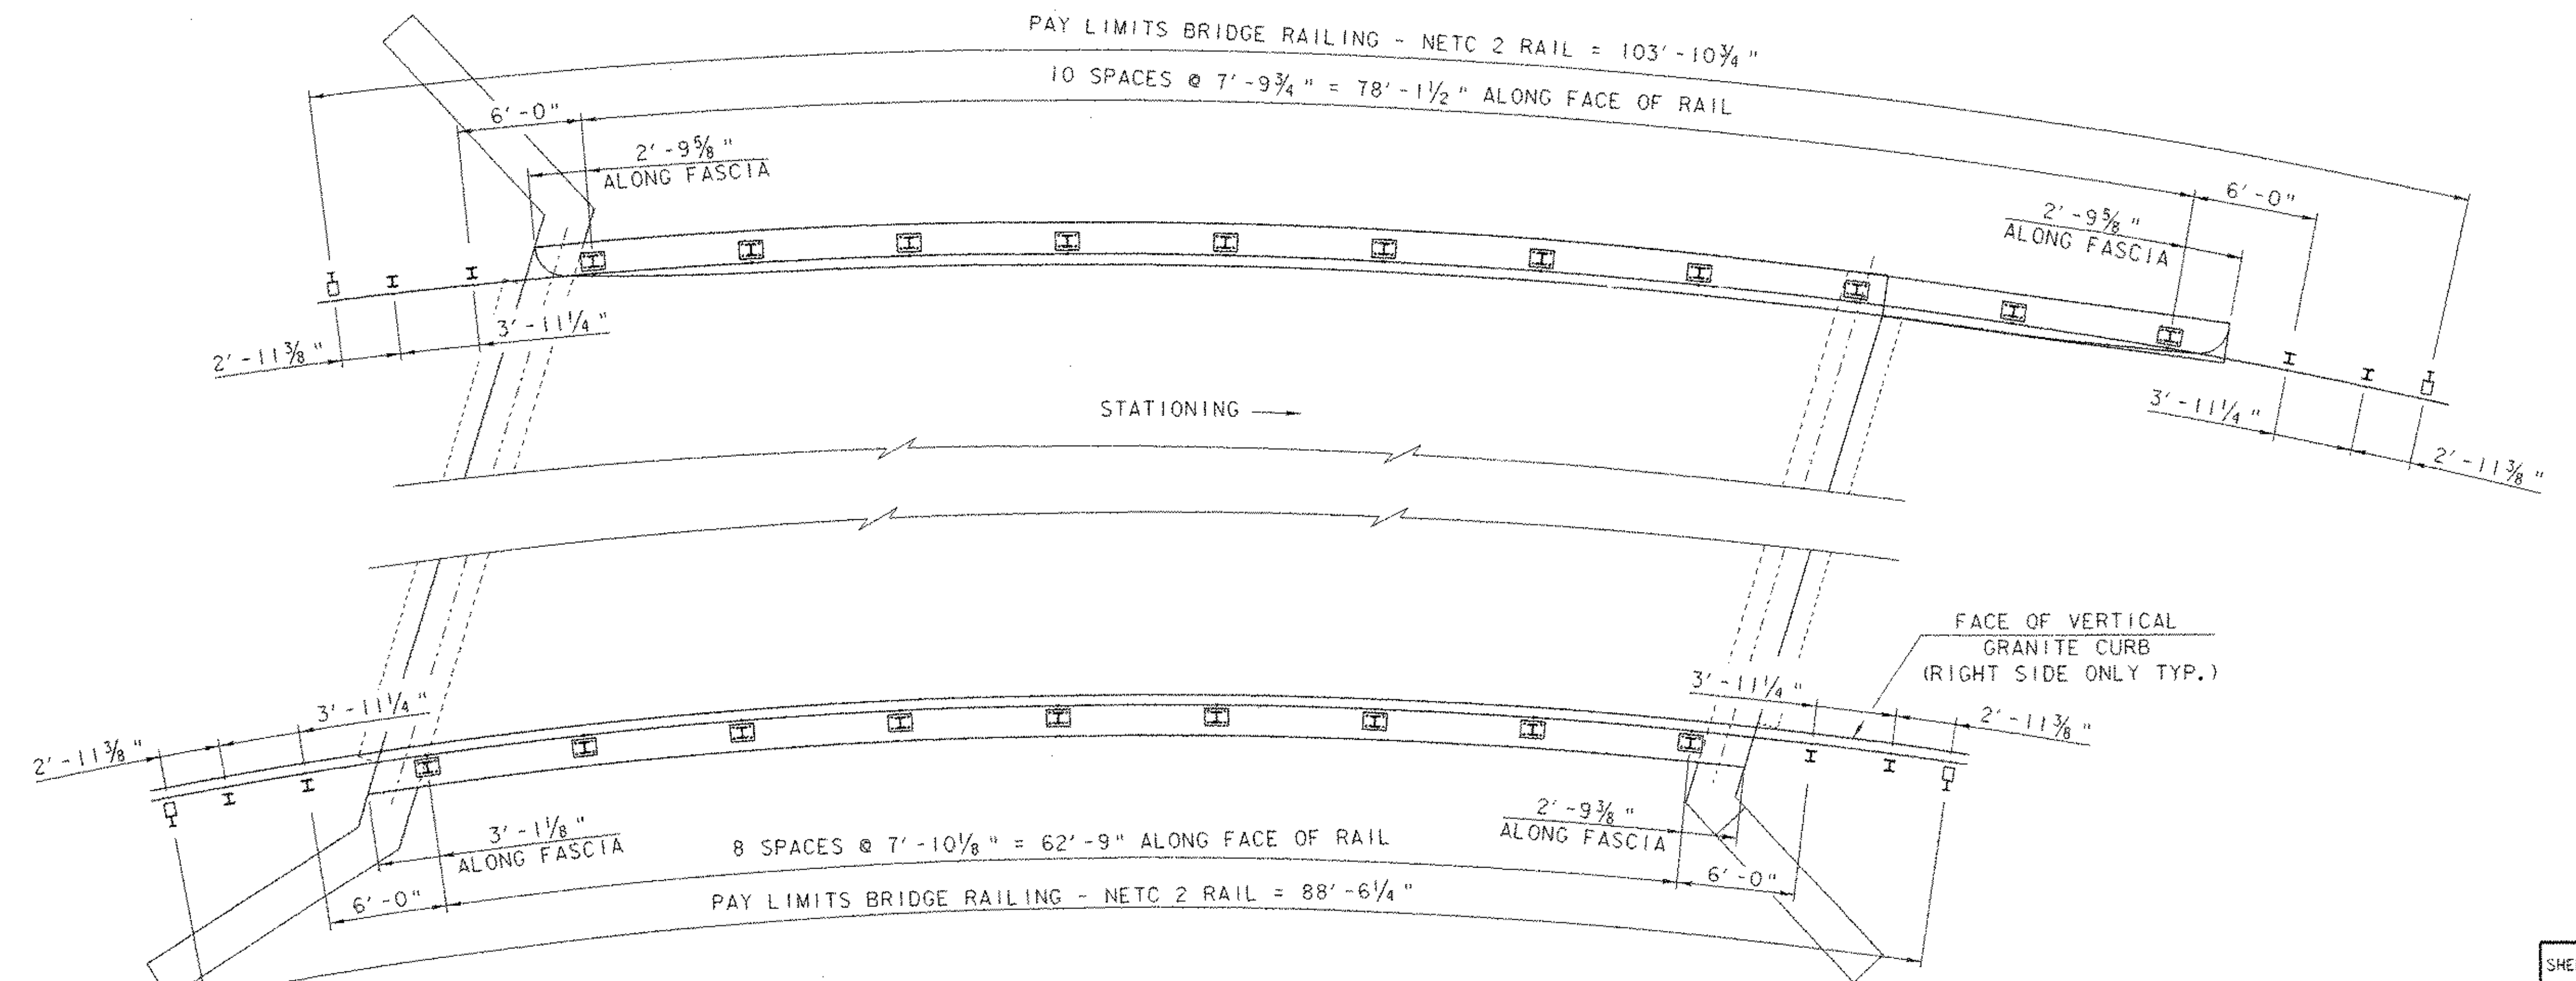

BRIDGE RAIL LAYOUT

5 0 5
SCALE: 1" = 5'-0"

*INCLUDES 2'-0" FOR END SECTION

SHEET NAME: RAILING LAYOUT SHEET	
PROJECT NAME: READING	HIGHWAY NO.: VT 44
PROJECT NUMBER: BRS 0148(6)S	BRIDGE NO.: 1
	OVER: THE MILL BROOK
FILE NAME: PW/85e034/Structures/se034r.dgn	PLOT DATE: 17-FEB-2006
PROJECT MANAGER: R. WHITCOMB	DRAWN BY: G. ROY
DESIGNED BY: C. CARLSON	IPARM NAME: se034-rd.1
BRIDGE SHEET NUMBER:	SHEET 49 OF 83