



ABUTMENT #1 PLAN

SCALE 1/4" = 1'-0"
 1 0 2 4 6

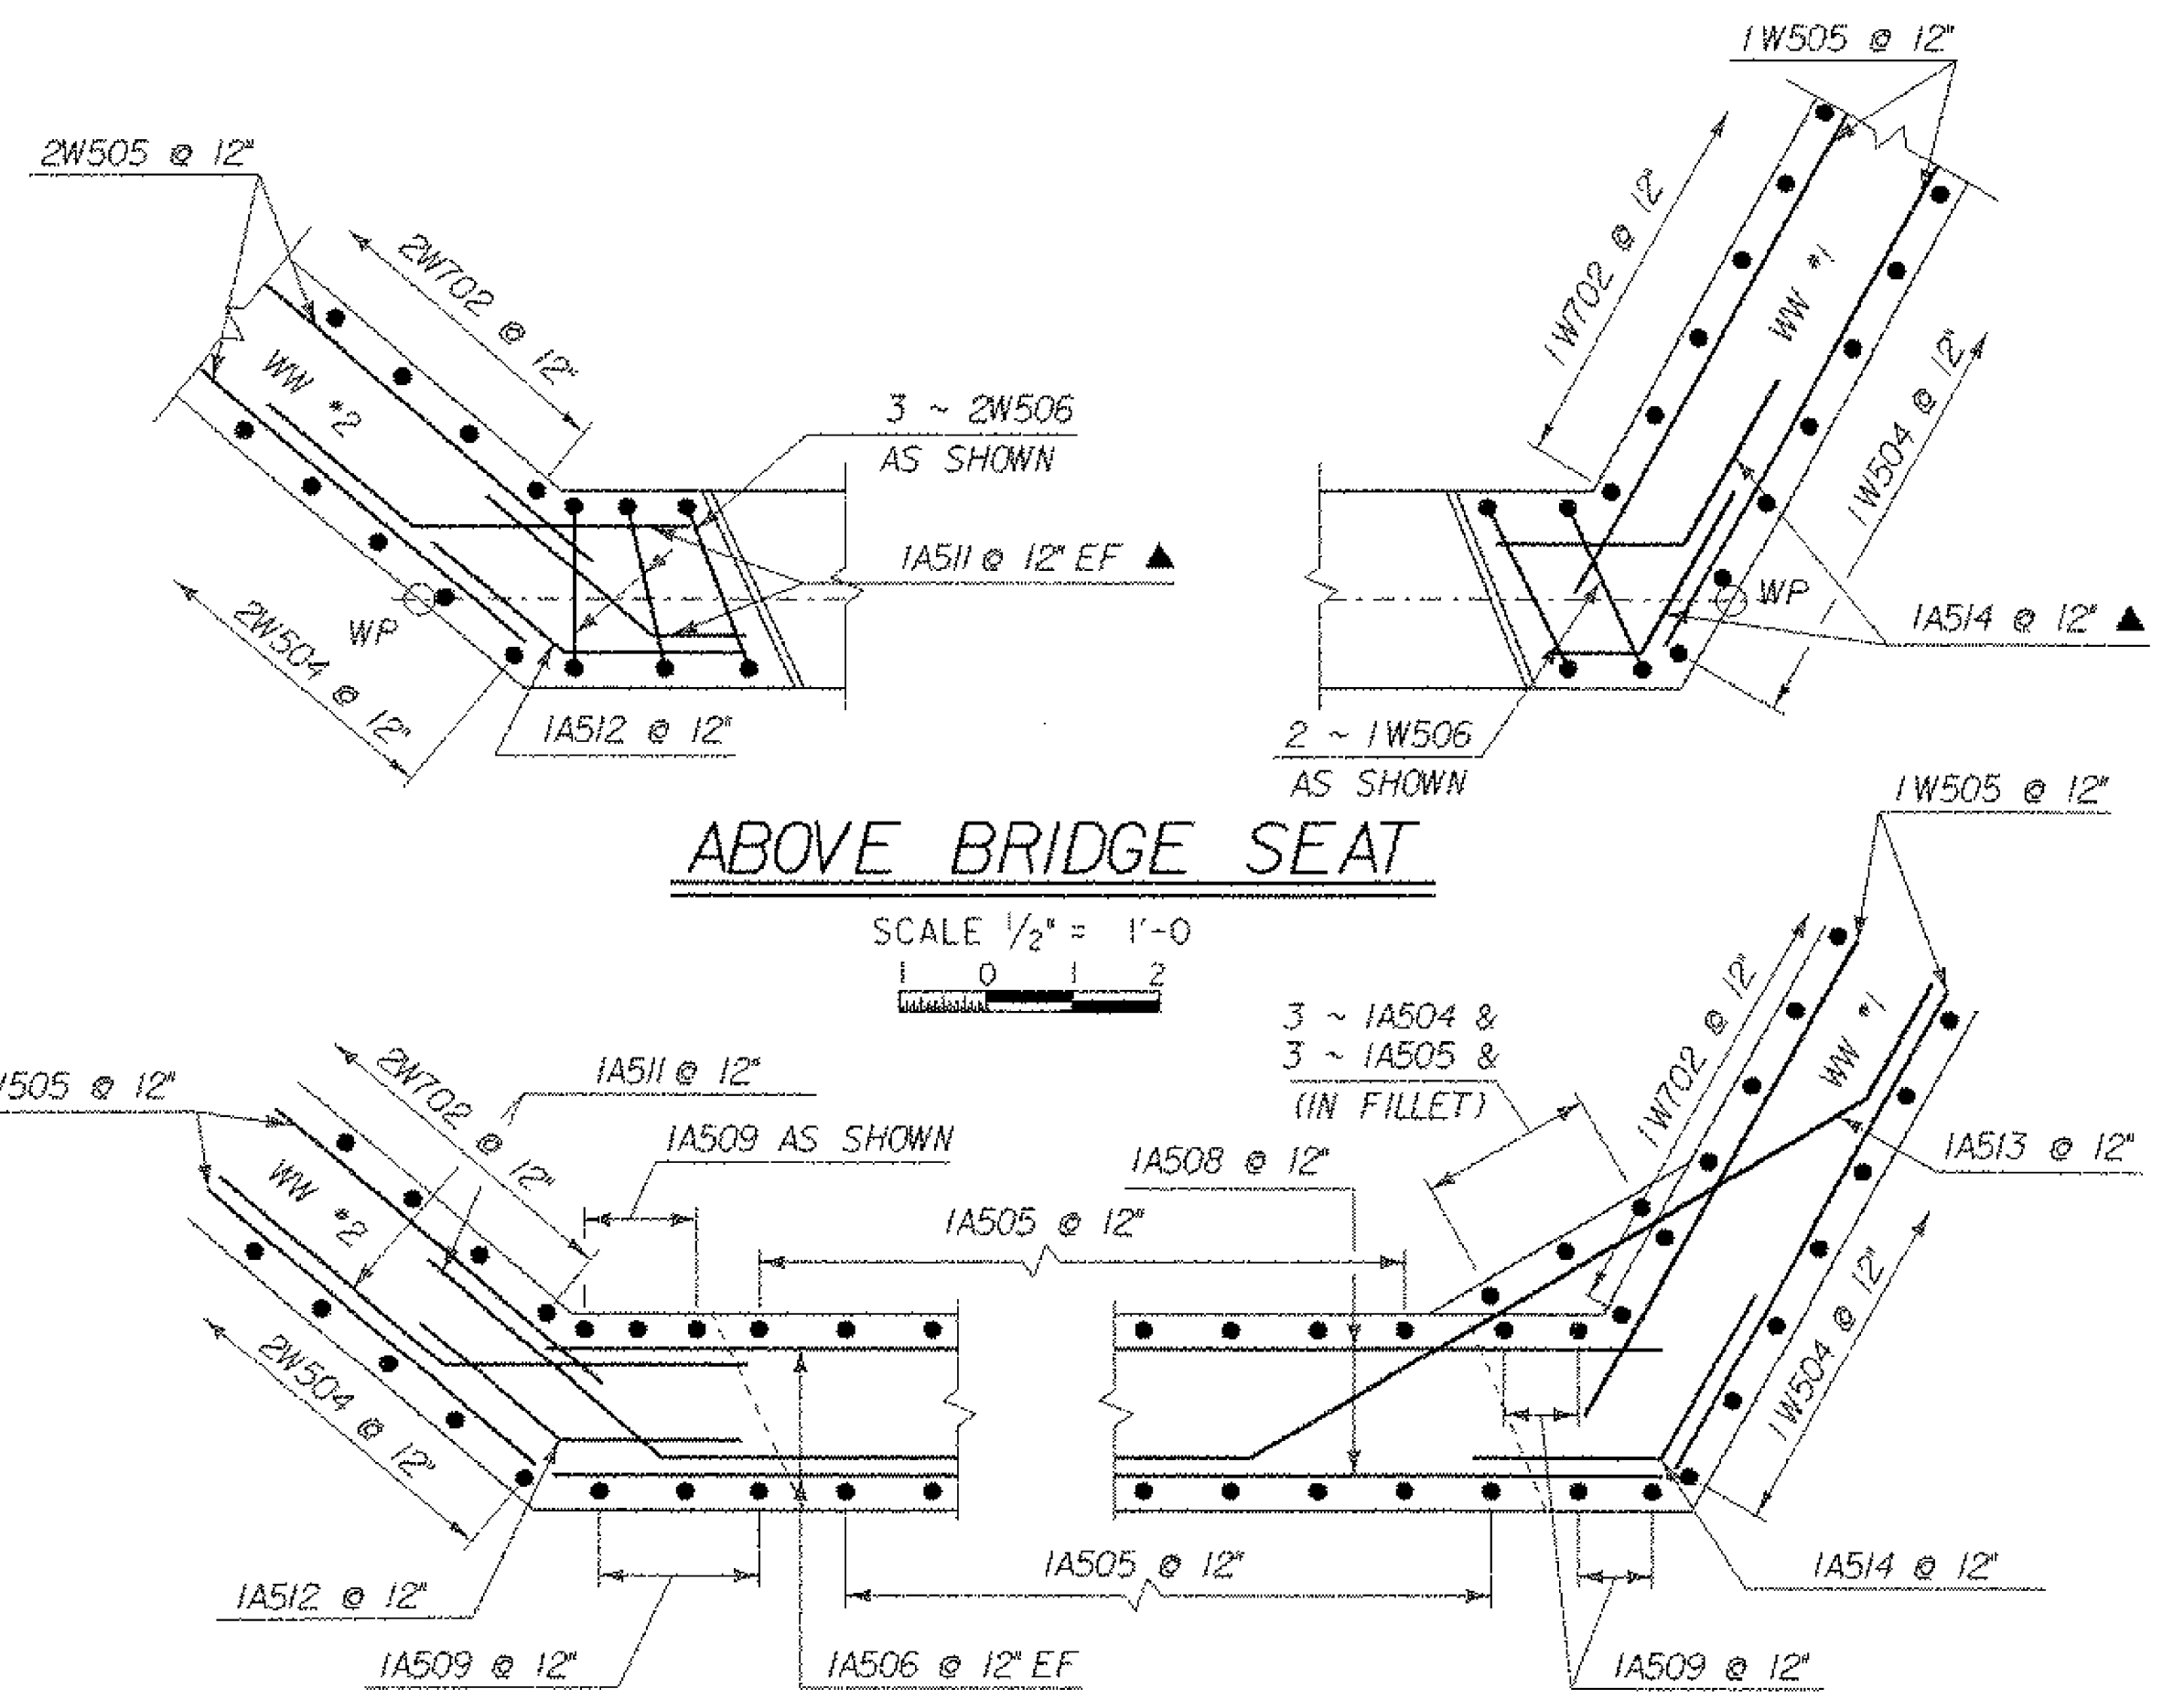


**ABUTMENT #1 CORNER DETAILS
BELOW BRIDGE SEAT**

NOTE - SOME STIRRUP BARS OMITTED FOR CLARITY
 SCALE 1/2" = 1'-0"
 1 0 2 4 6

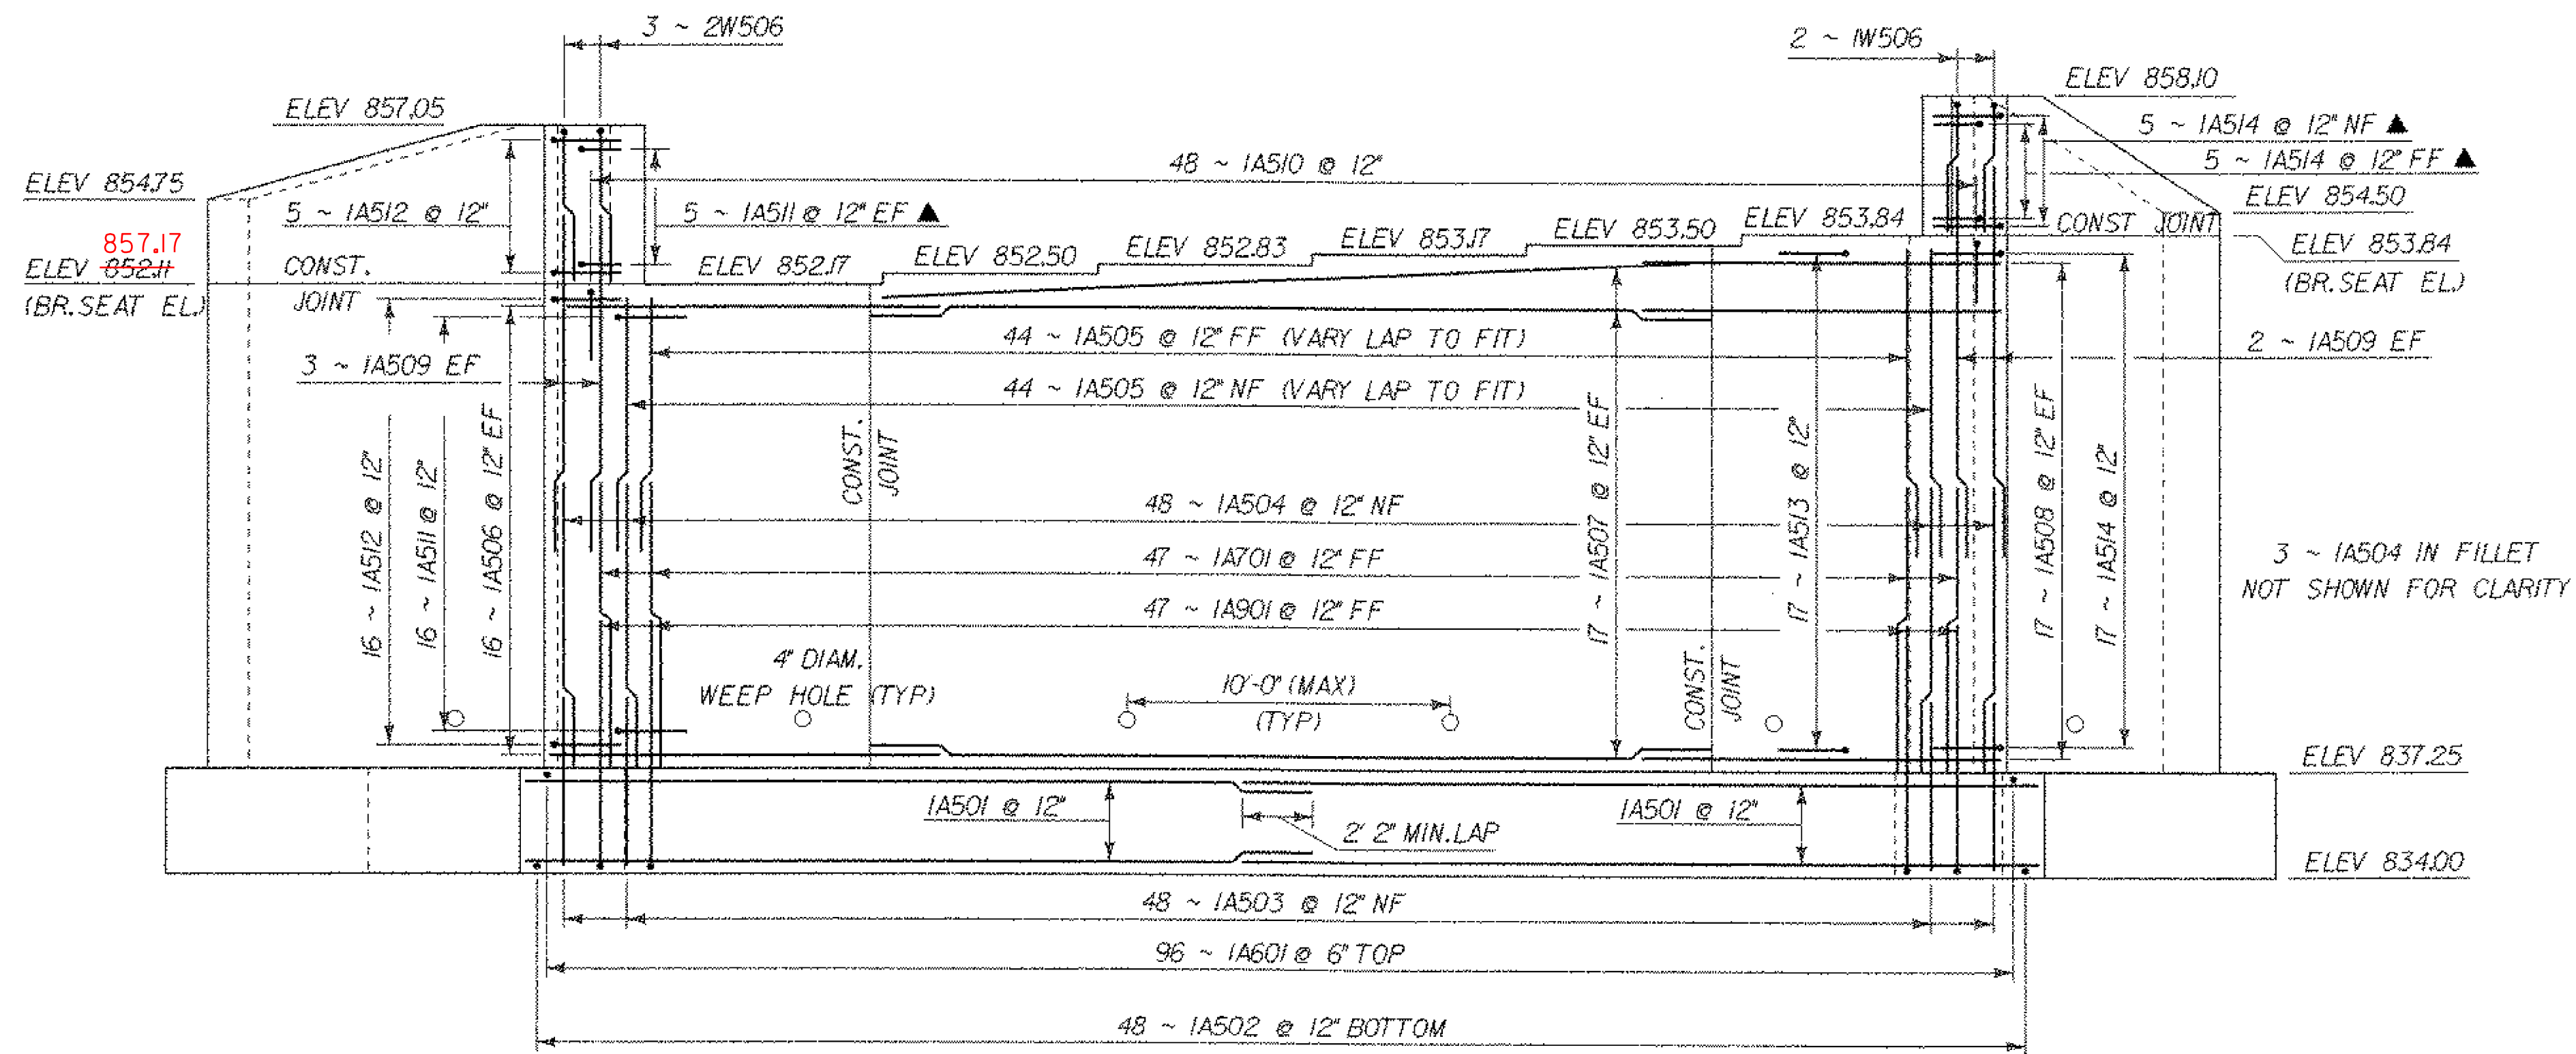

ABUTMENT #1 ELEVATION

SCALE 1/4" = 1'-0"
 1 0 2 4 6

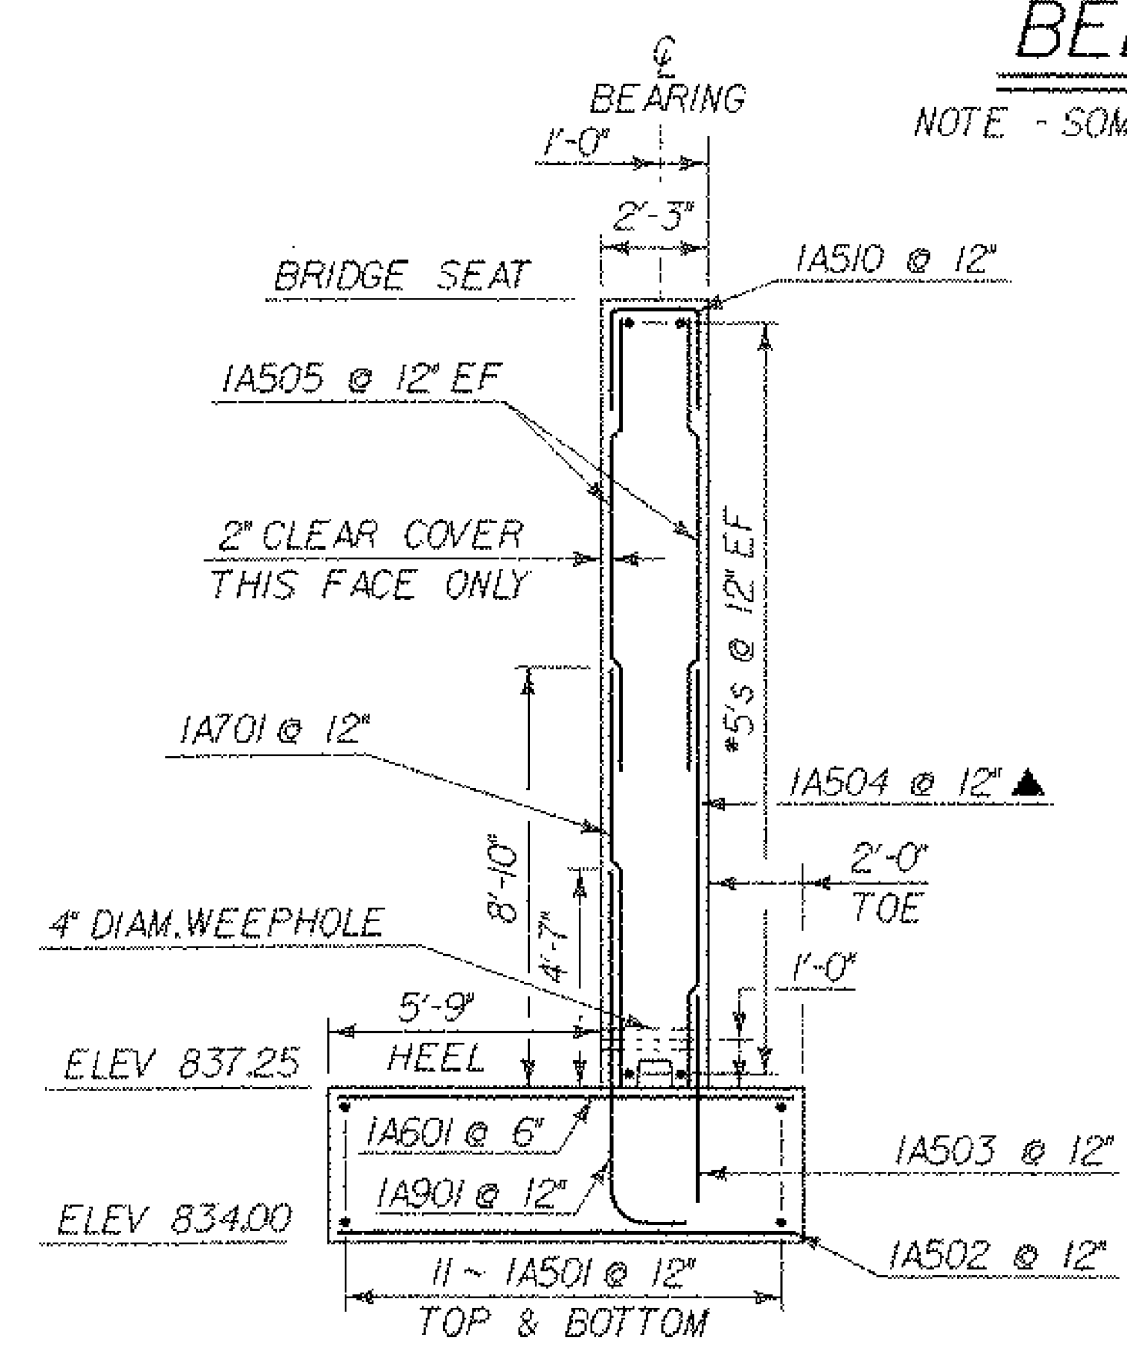

ABUTMENT #1 SECTION

SCALE 1/4" = 1'-0"
 1 0 2 4 6

- NOTES:**
1. NF = NEAR FACE
 2. FF = FAR FACE
 3. EF = EACH FACE
 4. ▲ = CUT TO FIT IN FIELD
 5. 3" CLR. UNLESS OTHERWISE SPECIFIED ON THE PLANS.
 6. LAP SPLICES ARE 2'-2" UNLESS OTHERWISE NOTED.
 7. SEE SHT. 56 FOR SCORE MARK DETAILS

SHEET NAME: ABUTMENT #1 DETAILS	
PROJECT NAME: READING	HIGHWAY NO.: VT 44
PROJECT NUMBER: BRS 0148(6)S	BRIDGE NO.: 1
	OVER: THE MILL BROOK
FILE NAME: PW/85e034/Structures/se034sub.dgn	PLOT DATE: 17-FEB-2006
PROJECT MANAGER: R. WHITCOMB	DRAWN BY: T. FILLBACH
DESIGNED BY: C. CARLSON	IPARM NAME: se034abi.1
BRIDGE SHEET NUMBER:	SHEET 53 OF 83