


**WINGWALL #4 SECTION**

SCALE  $\frac{3}{8}" = 1'-0"$   
 1 0 1 2 3 4

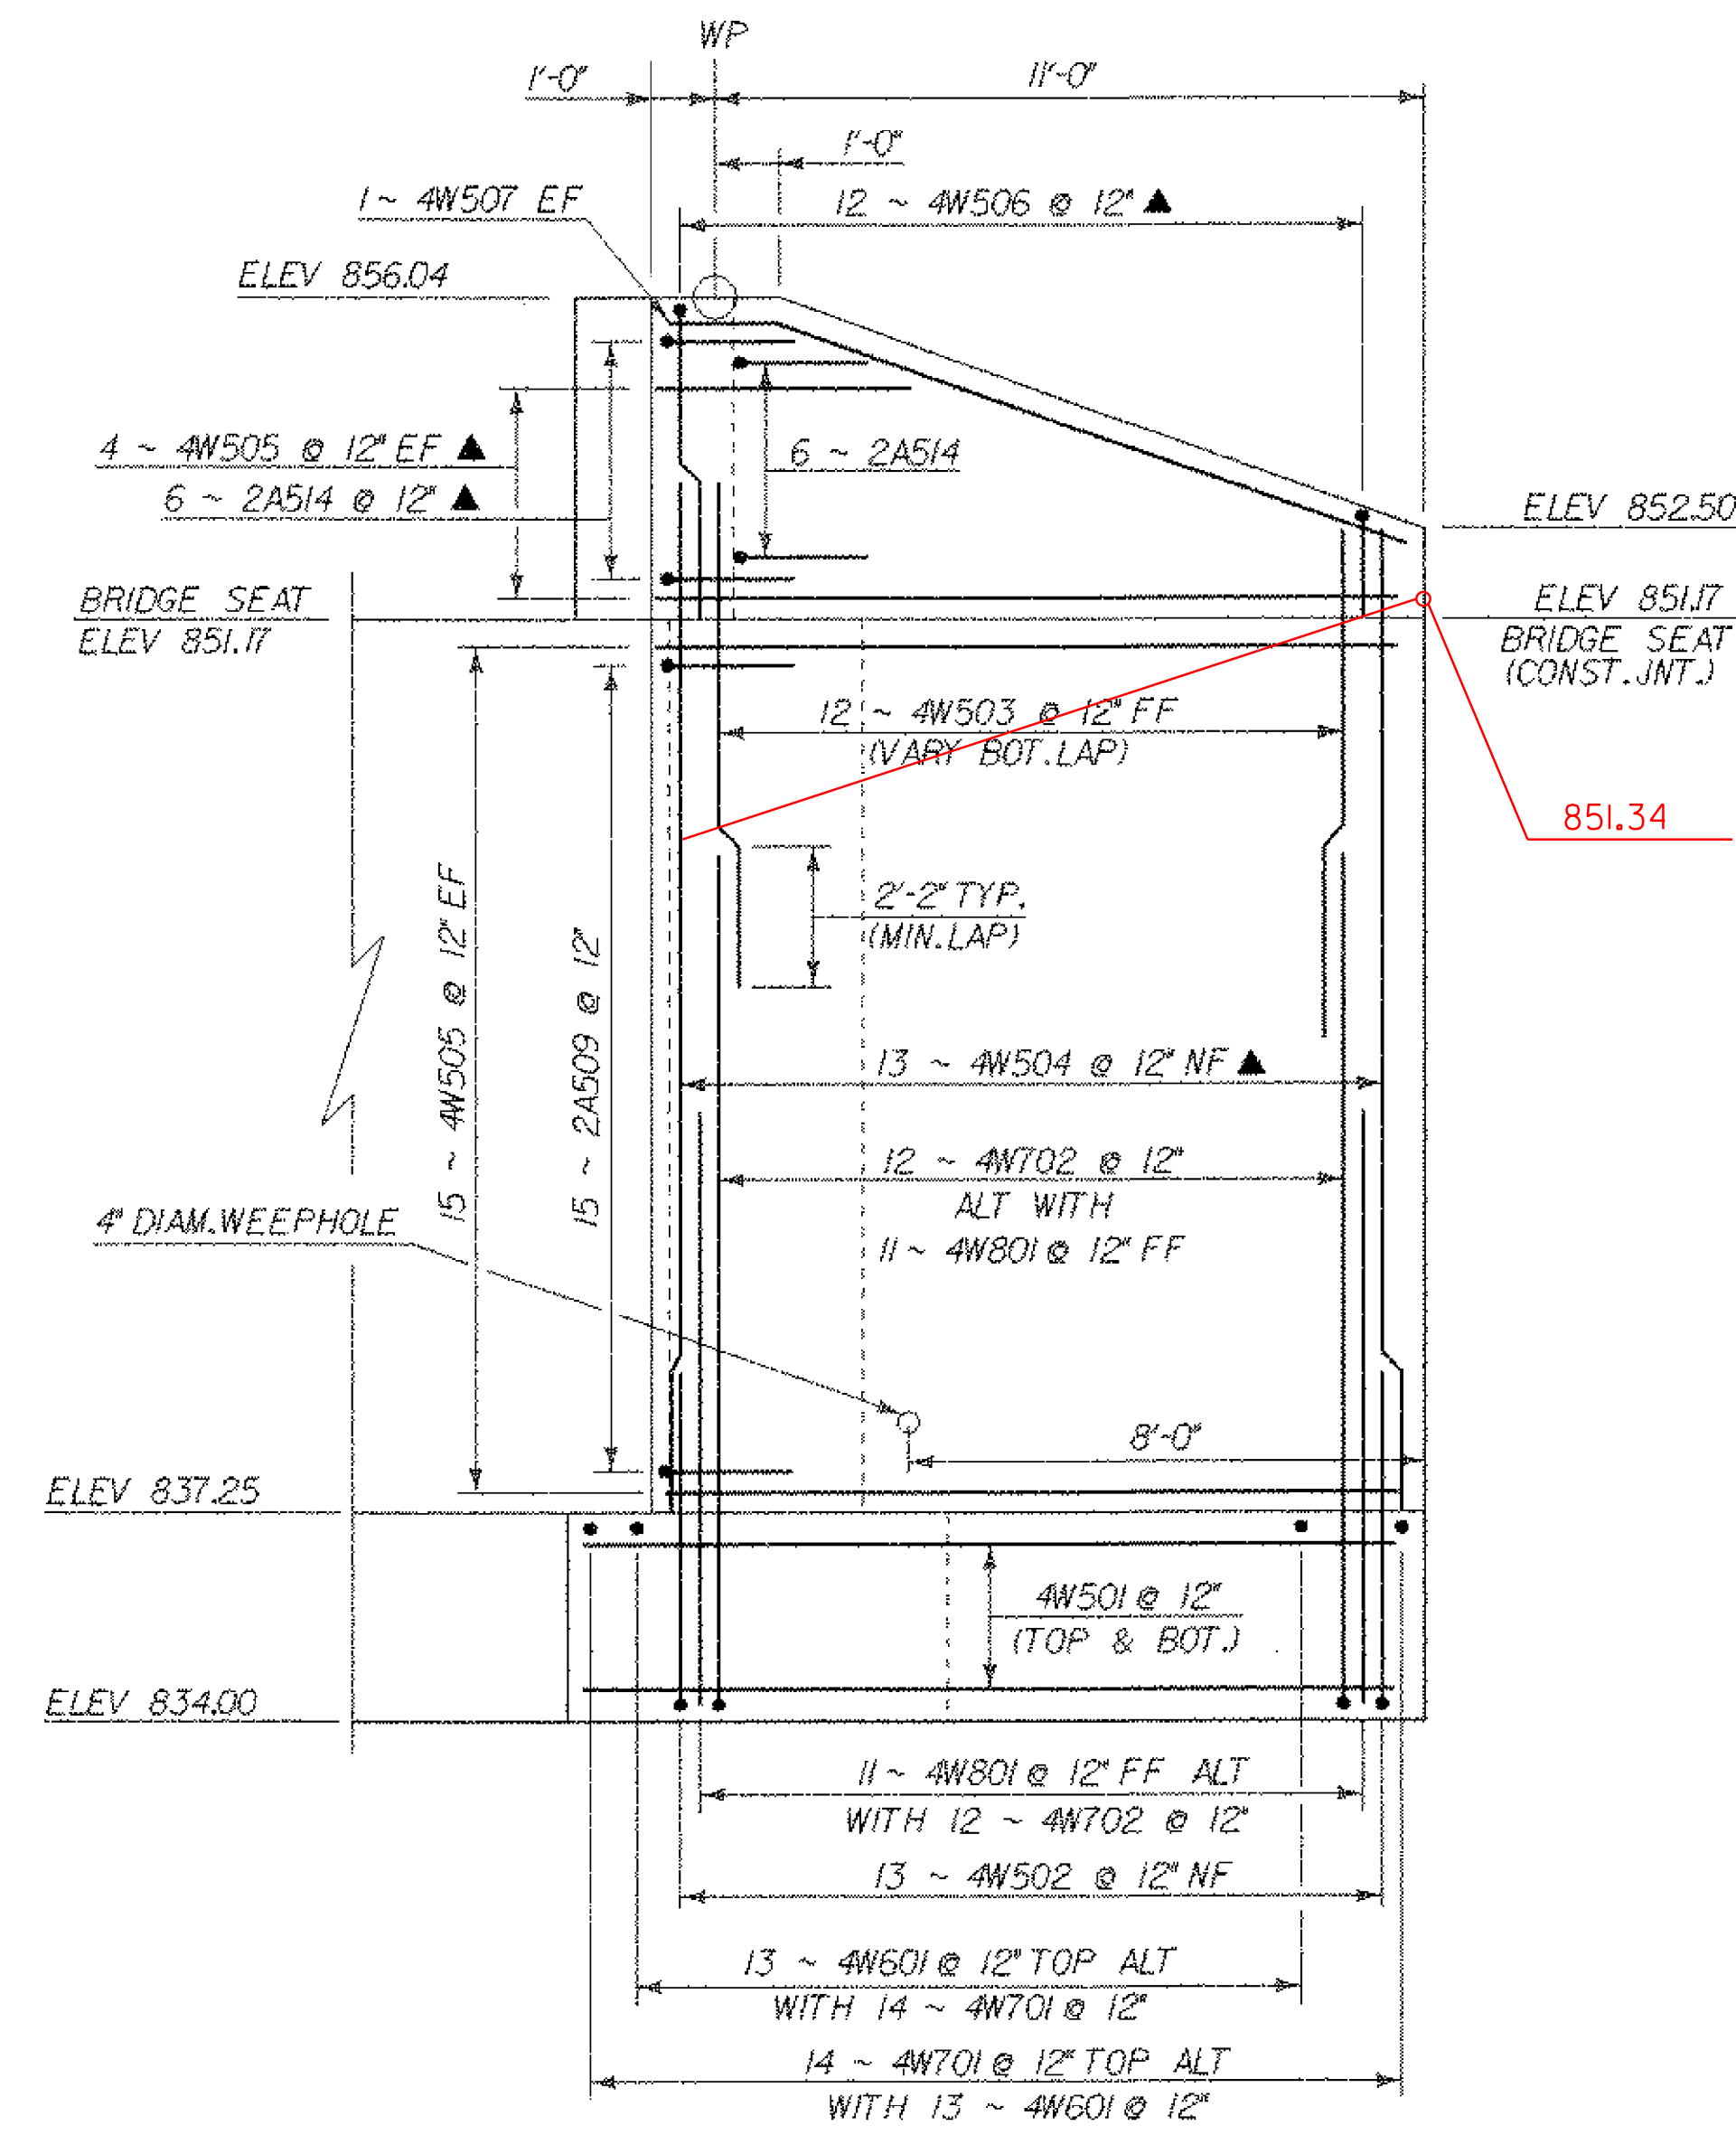

**WINGWALL #4 ELEVATION**

SCALE  $\frac{3}{8}" = 1'-0"$   
 1 0 1 2 3 4

**NOTES:**

1. NF = NEAR FACE
2. FF = FAR FACE
3. EF = EACH FACE
4. ▲ = CUT TO FIT IN FIELD
5. 3" CLR. UNLESS OTHERWISE SPECIFIED ON THE PLANS.
6. LAP SPLICES ARE 2'-2" UNLESS OTHERWISE NOTED.

SHEET NAME: <b>WINGWALL #4 DETAILS</b>	
PROJECT NAME: <b>READING</b>	HIGHWAY NO.: <b>VT 44</b>
PROJECT NUMBER: <b>BRS 0148(6)S</b>	BRIDGE NO.: <b>1</b>
	OVER: <b>THE MILL BROOK</b>
FILE NAME: <b>PW/85e034/Structures/se034sub.dgn</b>	PLOT DATE: <b>17-FEB-2006</b>
PROJECT MANAGER: <b>R. WHITCOMB</b>	DRAWN BY: <b>T. FILLBACH</b>
DESIGNED BY: <b>C. CARLSON</b>	IPARM NAME: <b>se034ww3.1</b>
BRIDGE SHEET NUMBER:	SHEET <b>58</b> OF <b>83</b>