



BEGIN MAINLINE SUBBASE DETAIL (VT 44)  
N. T. S.

END MAINLINE SUBBASE TRANSITION DETAIL (VT 44)  
N. T. S.

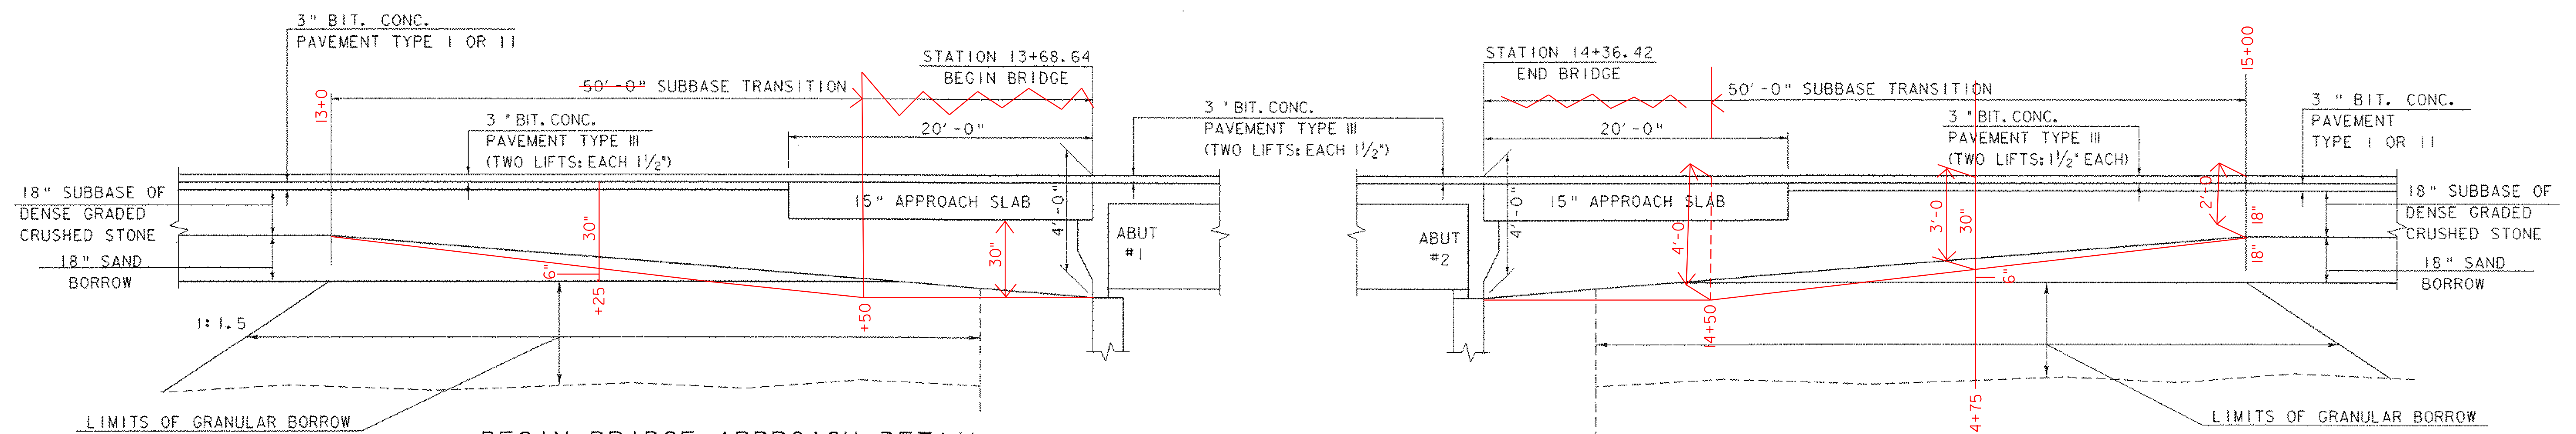

BEGIN BRIDGE APPROACH DETAIL  
N. T. S.

END BRIDGE APPROACH DETAIL  
N. T. S.

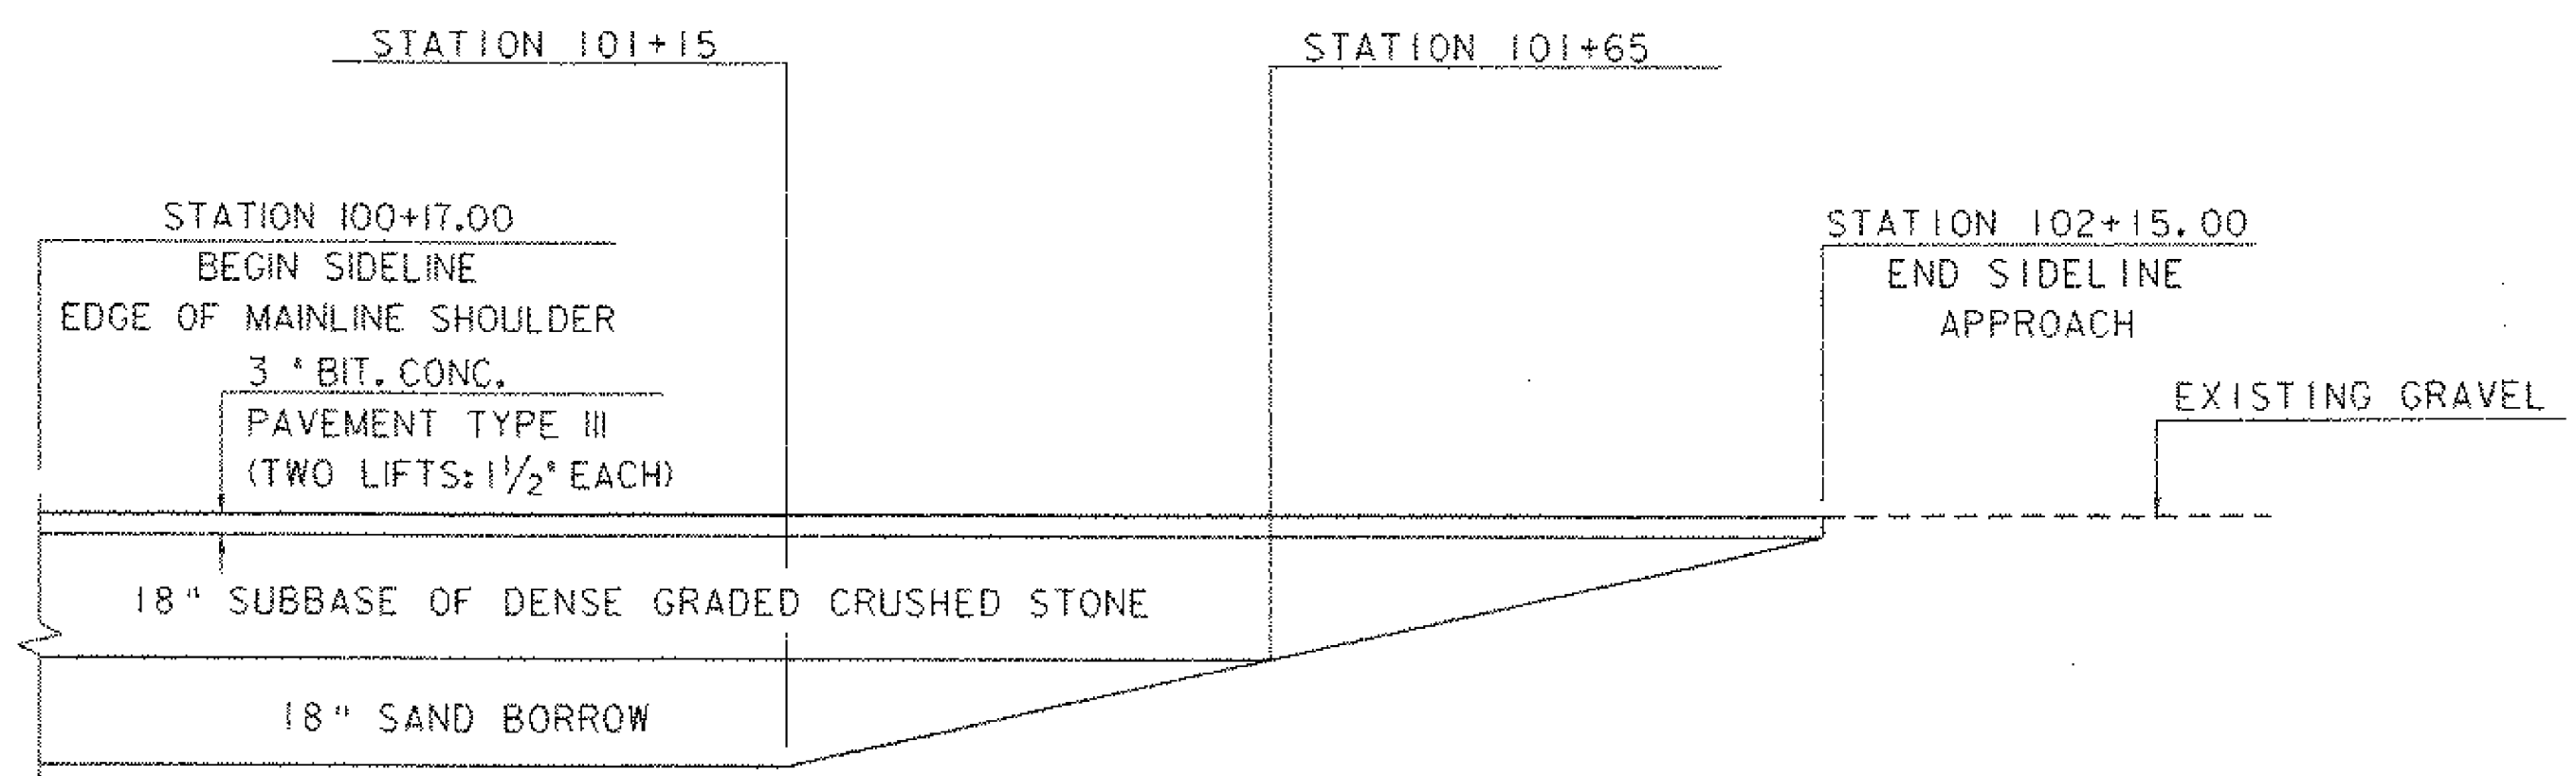

SIDELINE SUBBASE TRANSITION DETAIL (FLAT IRON RD.)  
N. T. S.

SHEET NAME: <b>SUBBASE TRANSITION DIAGRAMS</b>	
PROJECT NAME: <b>READING</b>	HIGHWAY NO.: <b>VT 44</b>
PROJECT NUMBER: <b>BRS 0148(6)S</b>	BRIDGE NO.: <b>1</b>
	OVER: <b>THE MILL BROOK</b>
FILE NAME: <b>PW/85e034/Structures/se034xsl.dgn</b>	PLOT DATE: <b>17-FEB-2006</b>
PROJECT MANAGER: <b>R. WHITCOMB</b>	DRAWN BY: <b>J. GILMORE</b>
DESIGNED BY: <b>C. CARLSON</b>	IPARM NAME: <b>se034std.1</b>
BRIDGE SHEET NUMBER:	SHEET <b>62</b> OF <b>83</b>