




18" X 74' PIPE OPTION
10+90 LT. - 11+00 RT.

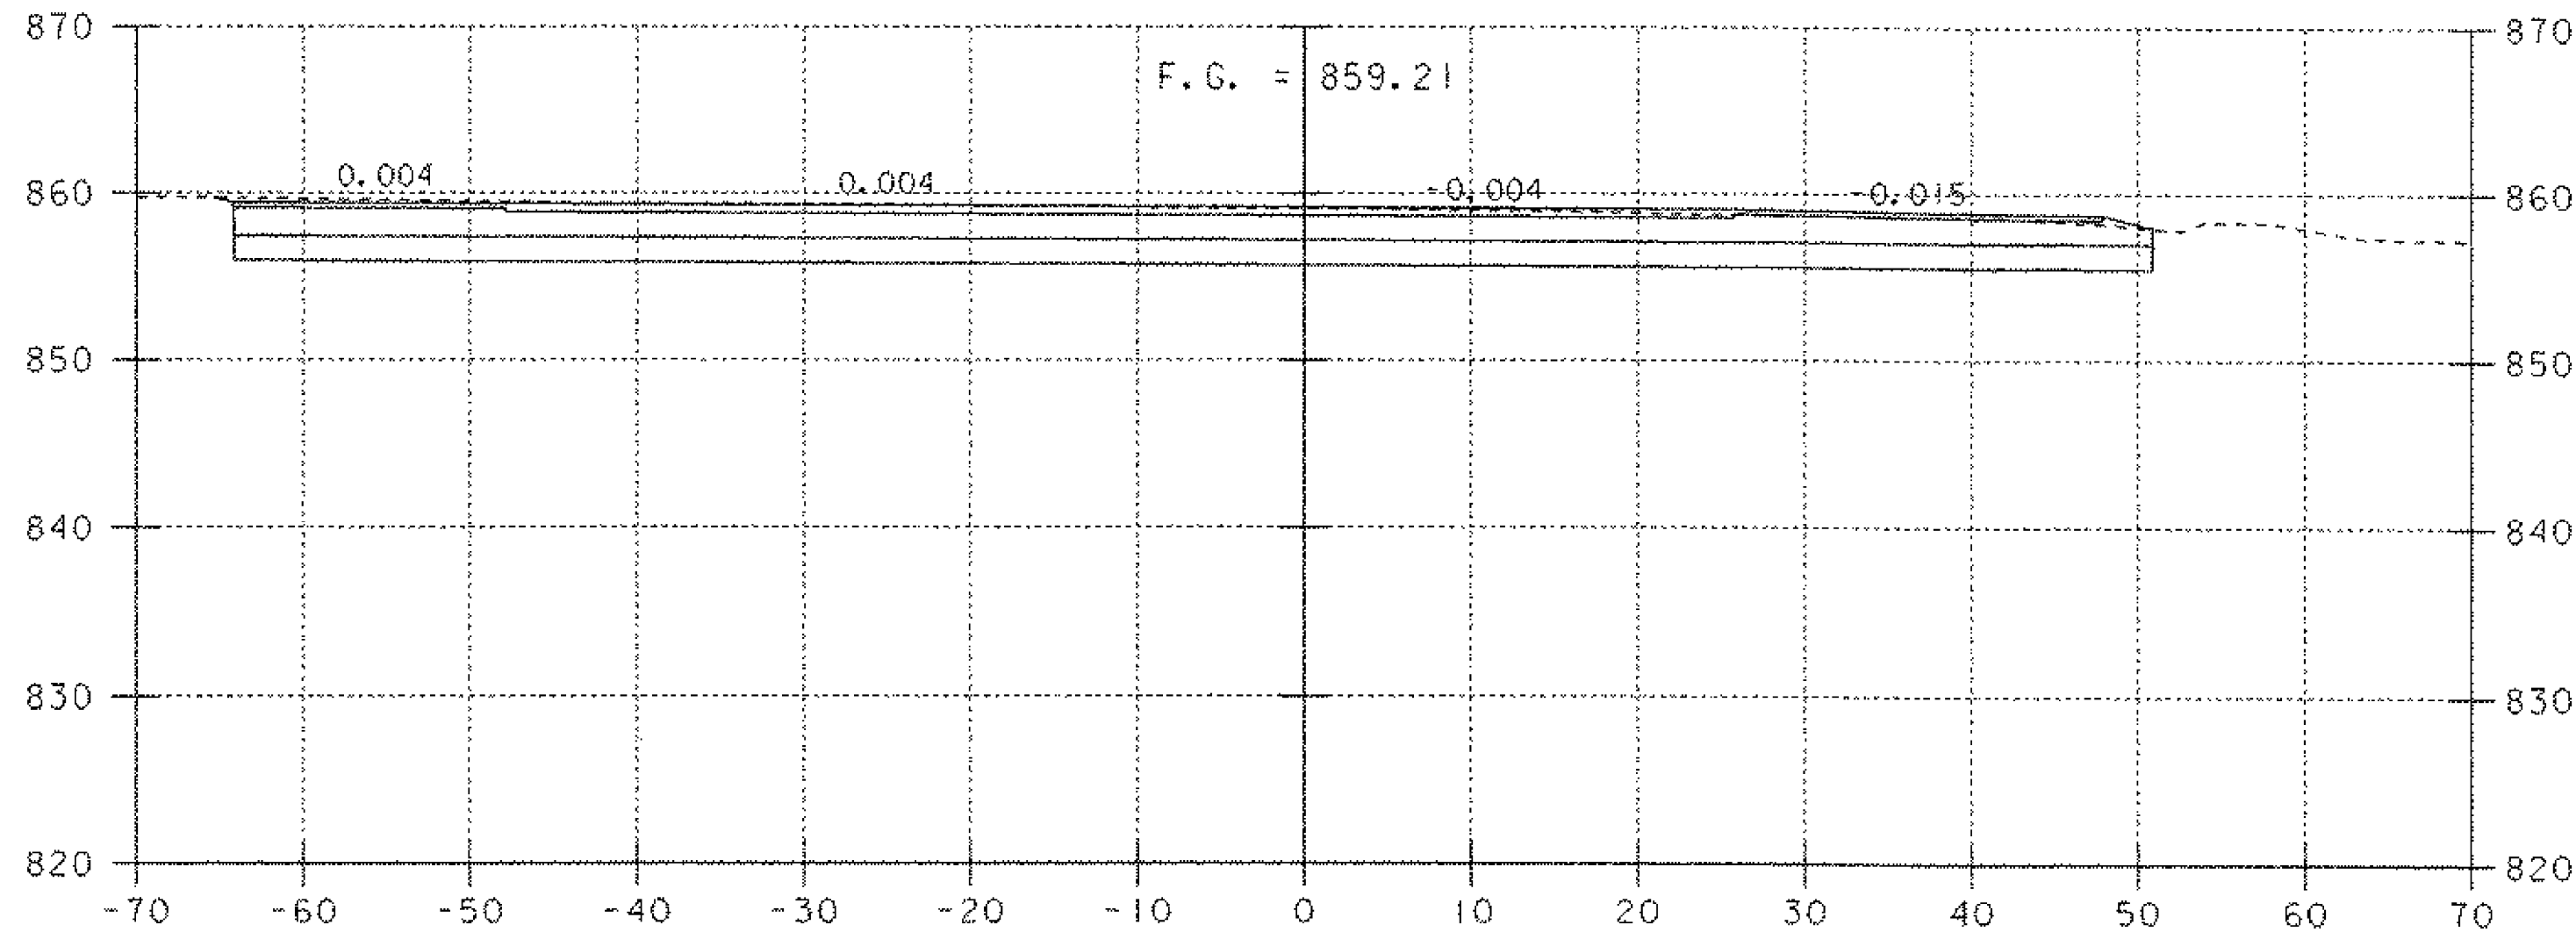


10+25

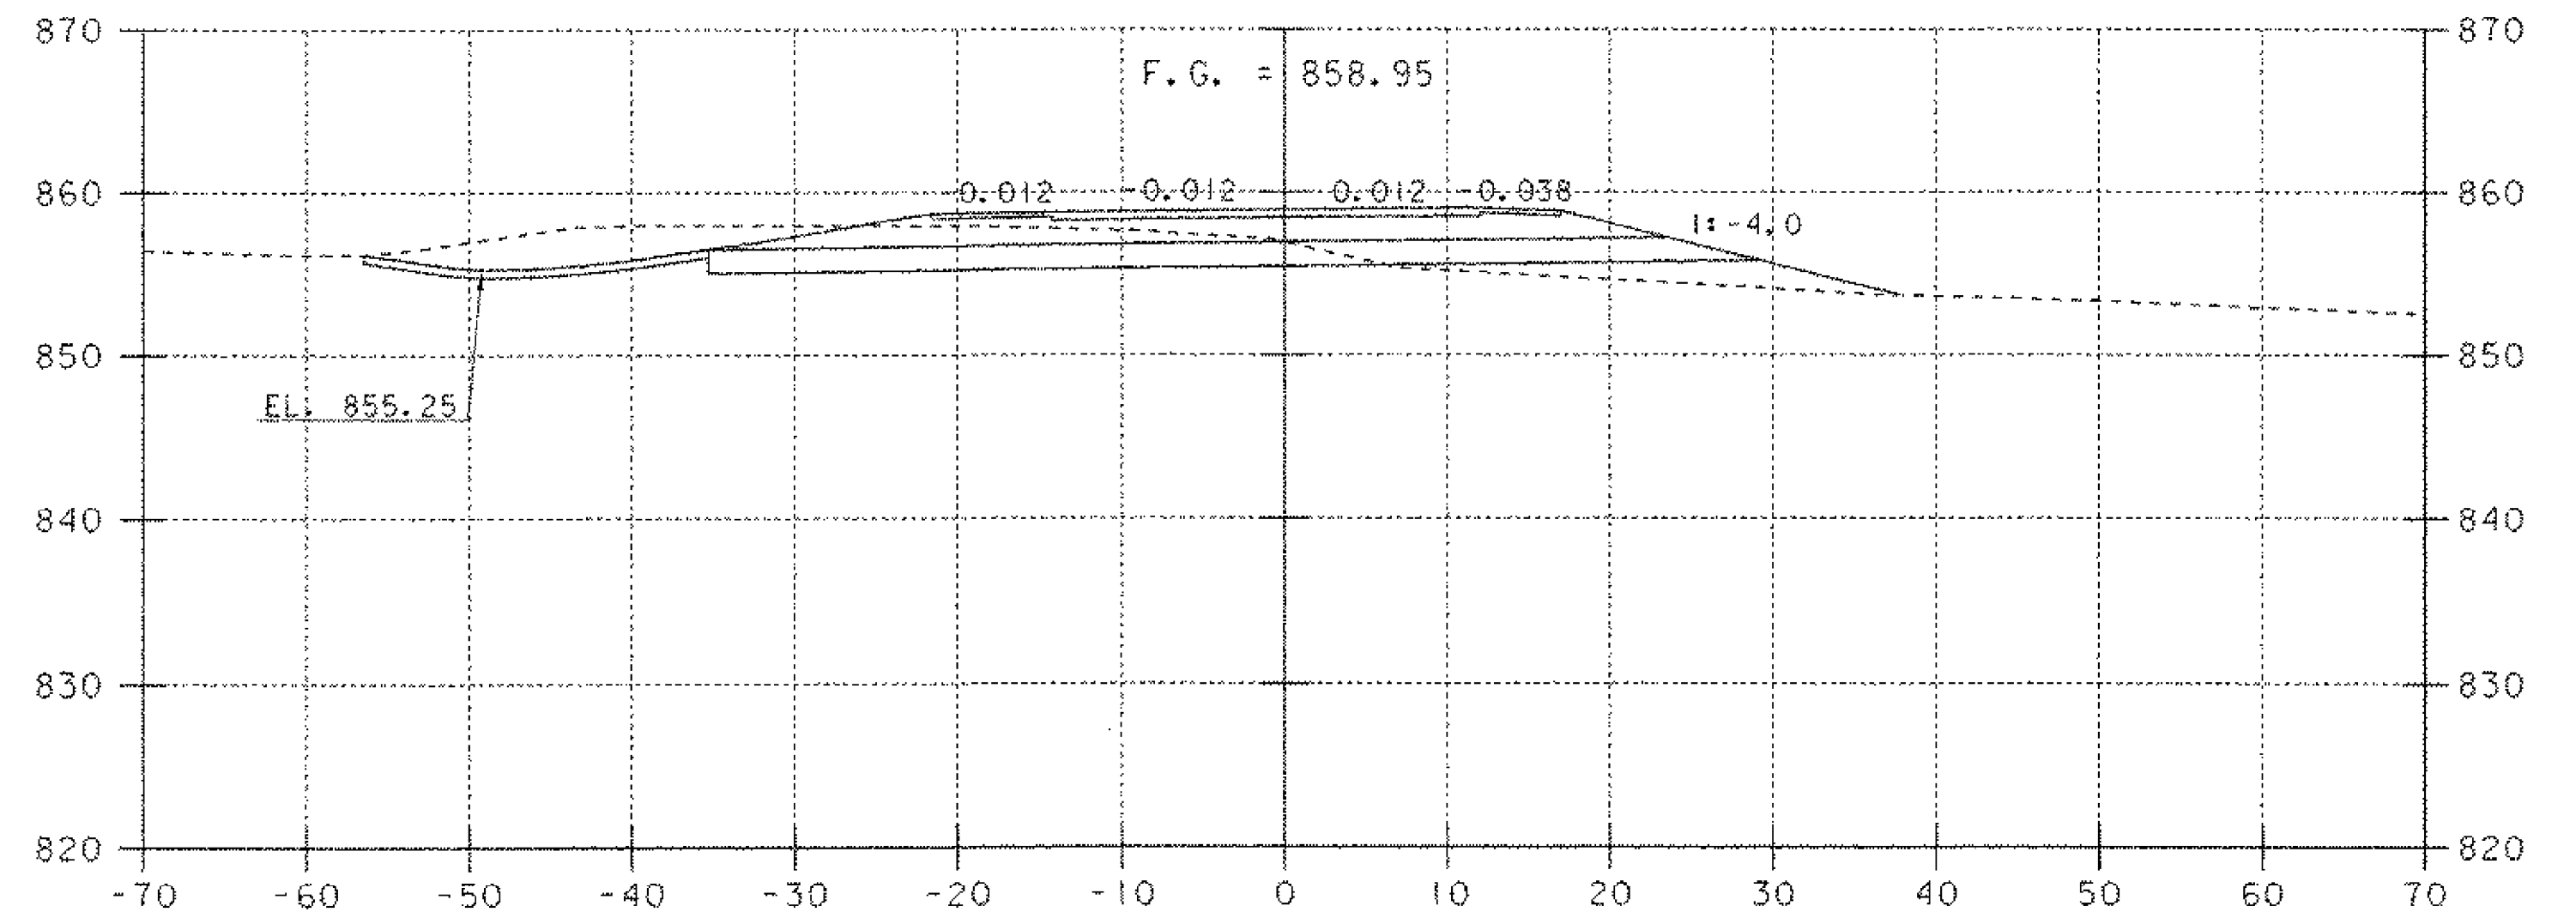


10+75

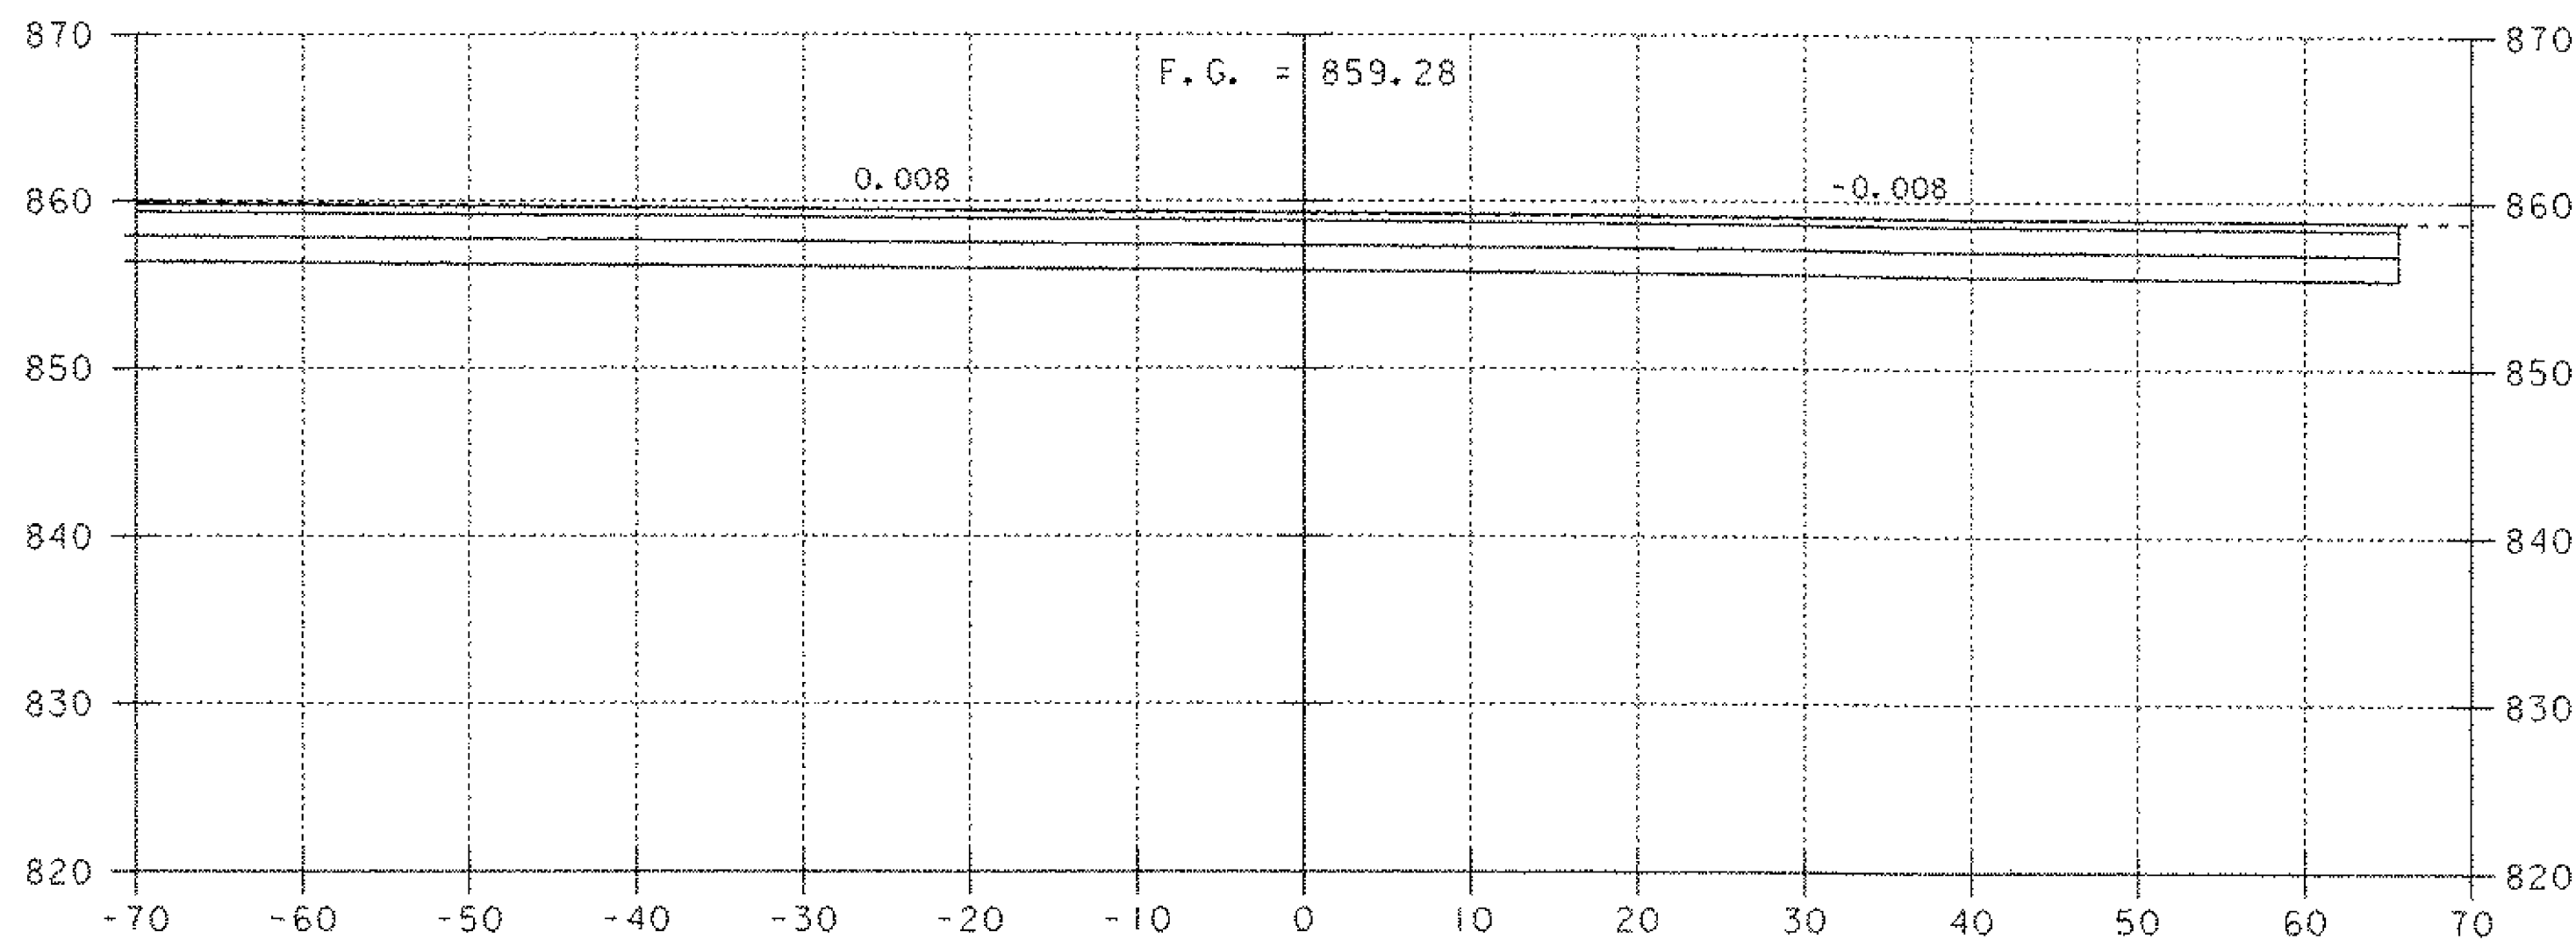

10+11
BEGIN PROJECT

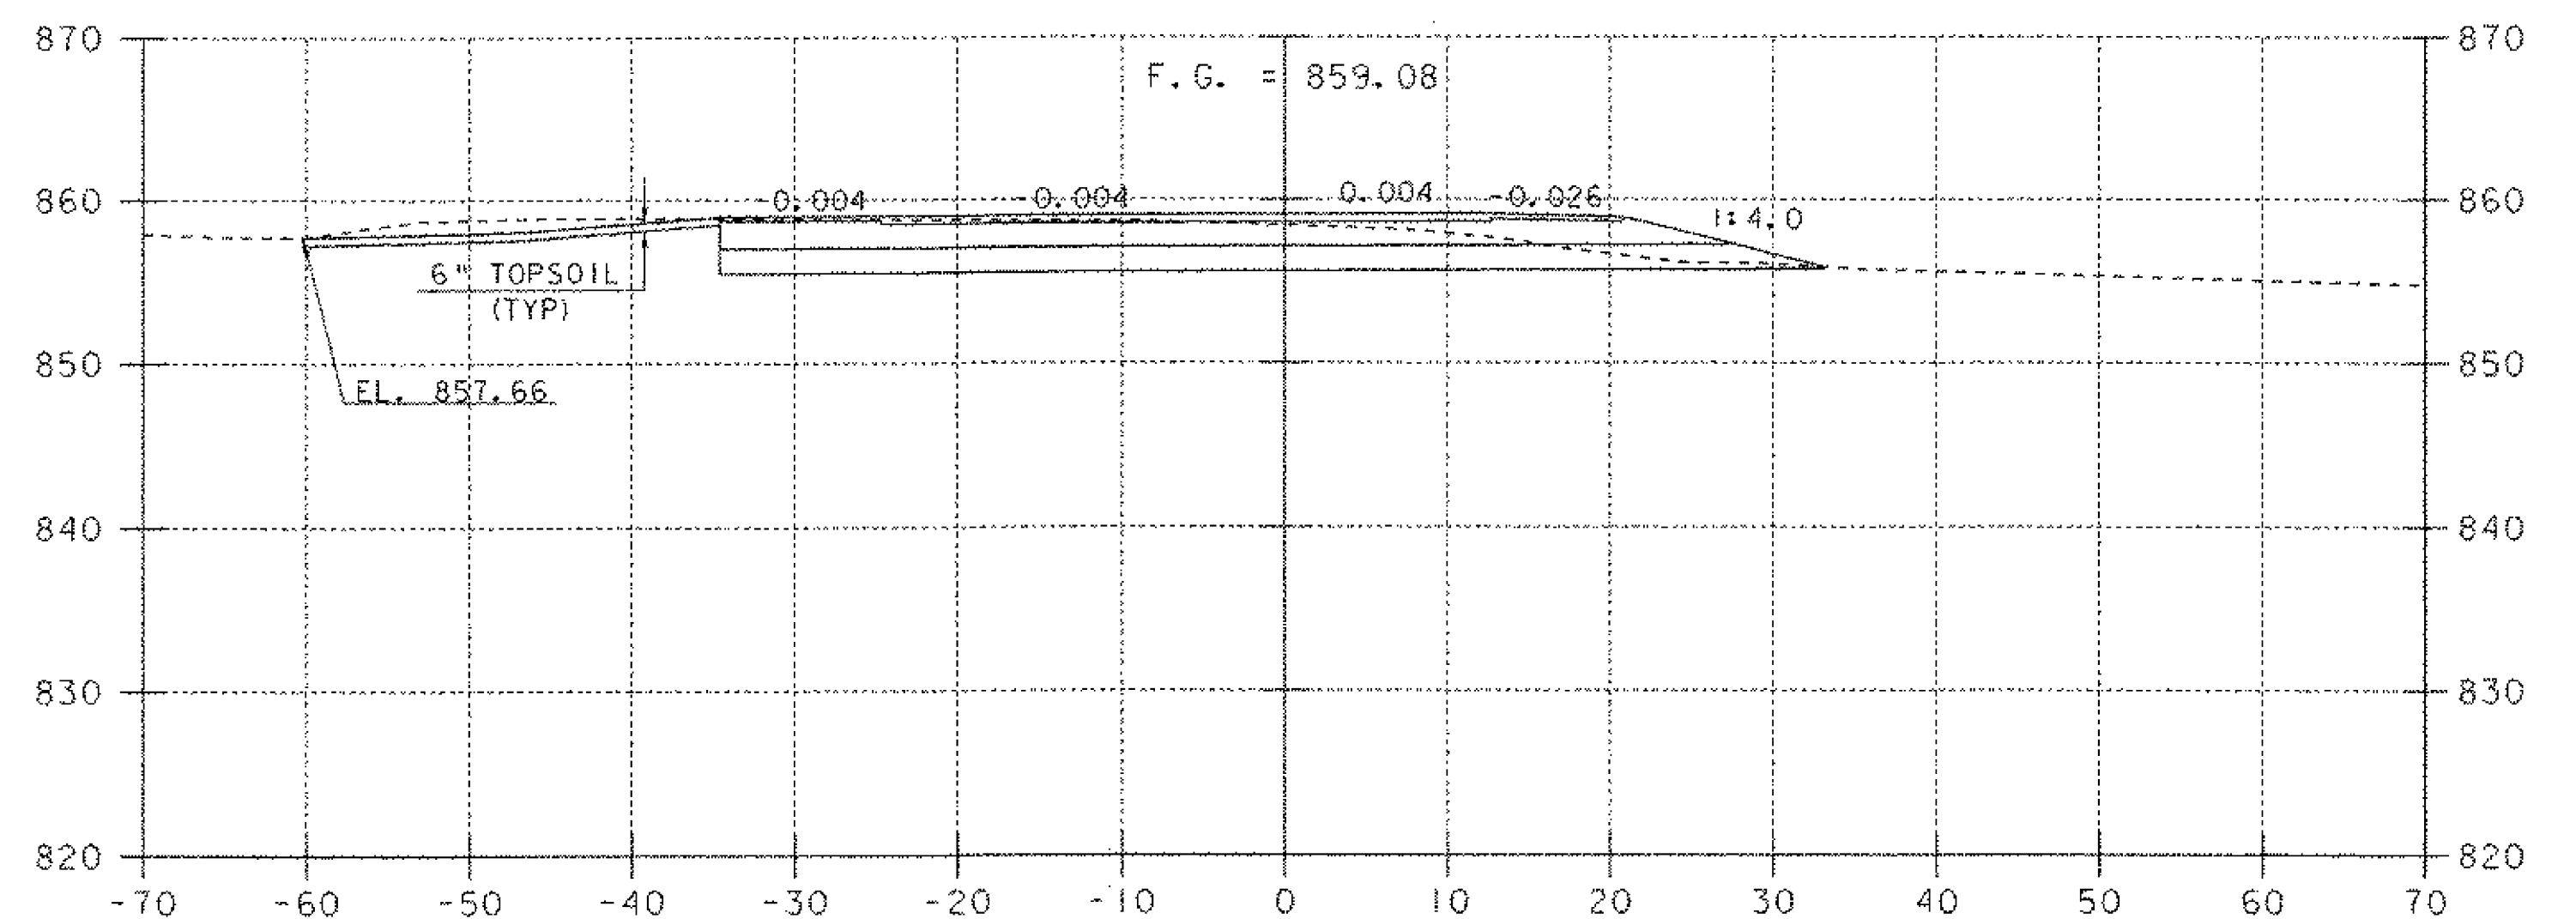

10+50

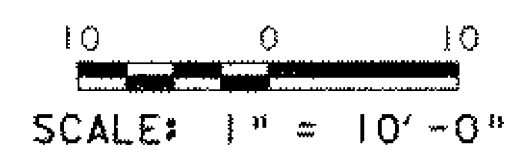

SHEET NAME: MAINLINE CROSS SECTIONS	
PROJECT NAME: READING	HIGHWAY NO.: VT 44
PROJECT NUMBER: BRS 0148(6)S	BRIDGE NO.: 1
	OVER: THE MILL BROOK
FILE NAME: PW/85e034/Structures/se034xsl.dgn	PLOT DATE: 17-FEB-2006
PROJECT MANAGER: R. WHITCOMB	DRAWN BY: J. GILMORE
DESIGNED BY: C. CARLSON	IPARM NAME: se034mx1.l
BRIDGE SHEET NUMBER:	SHEET 63 OF 83