

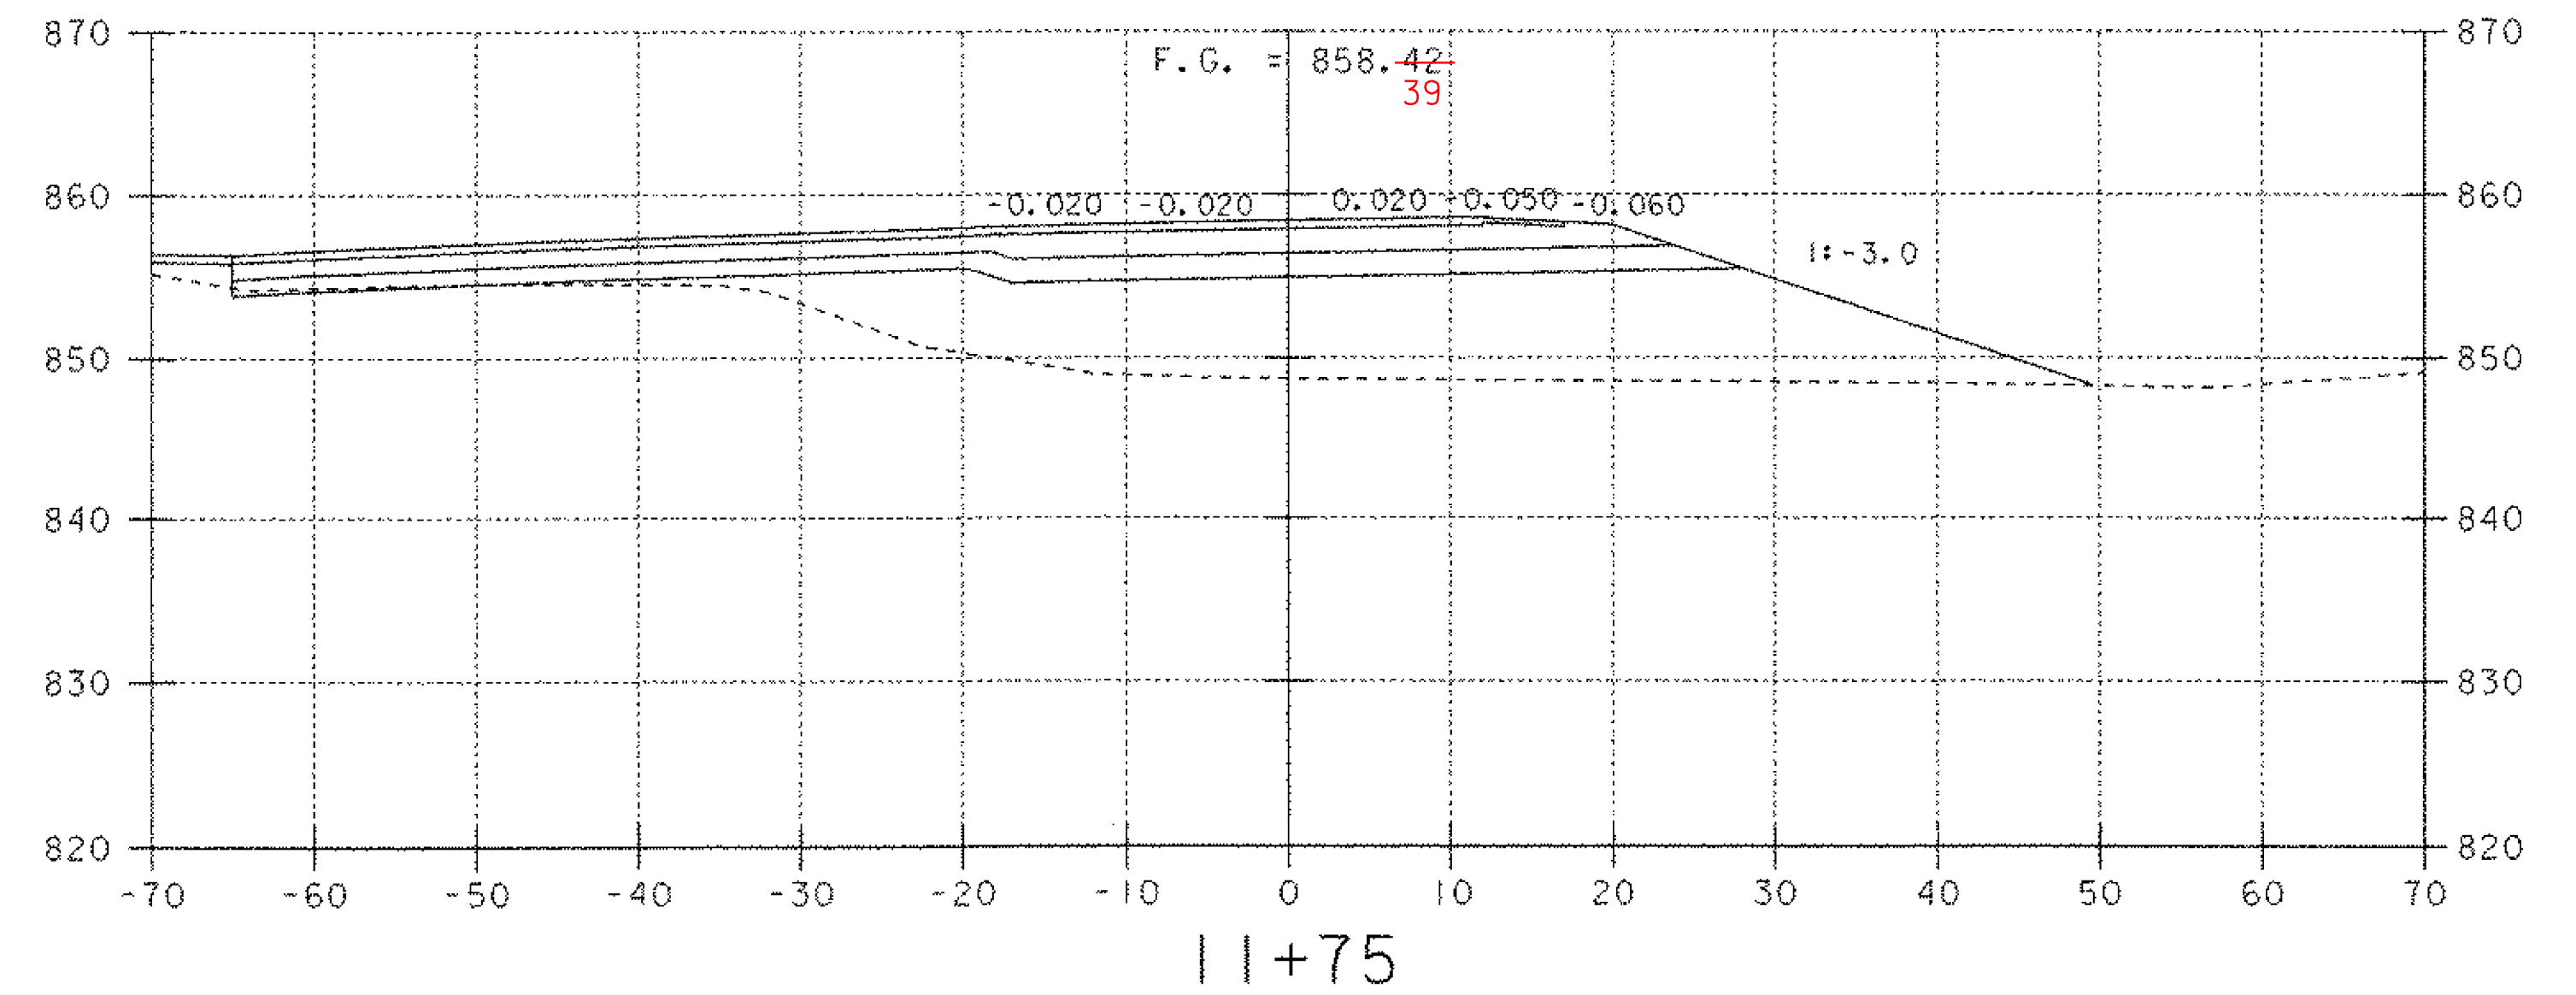
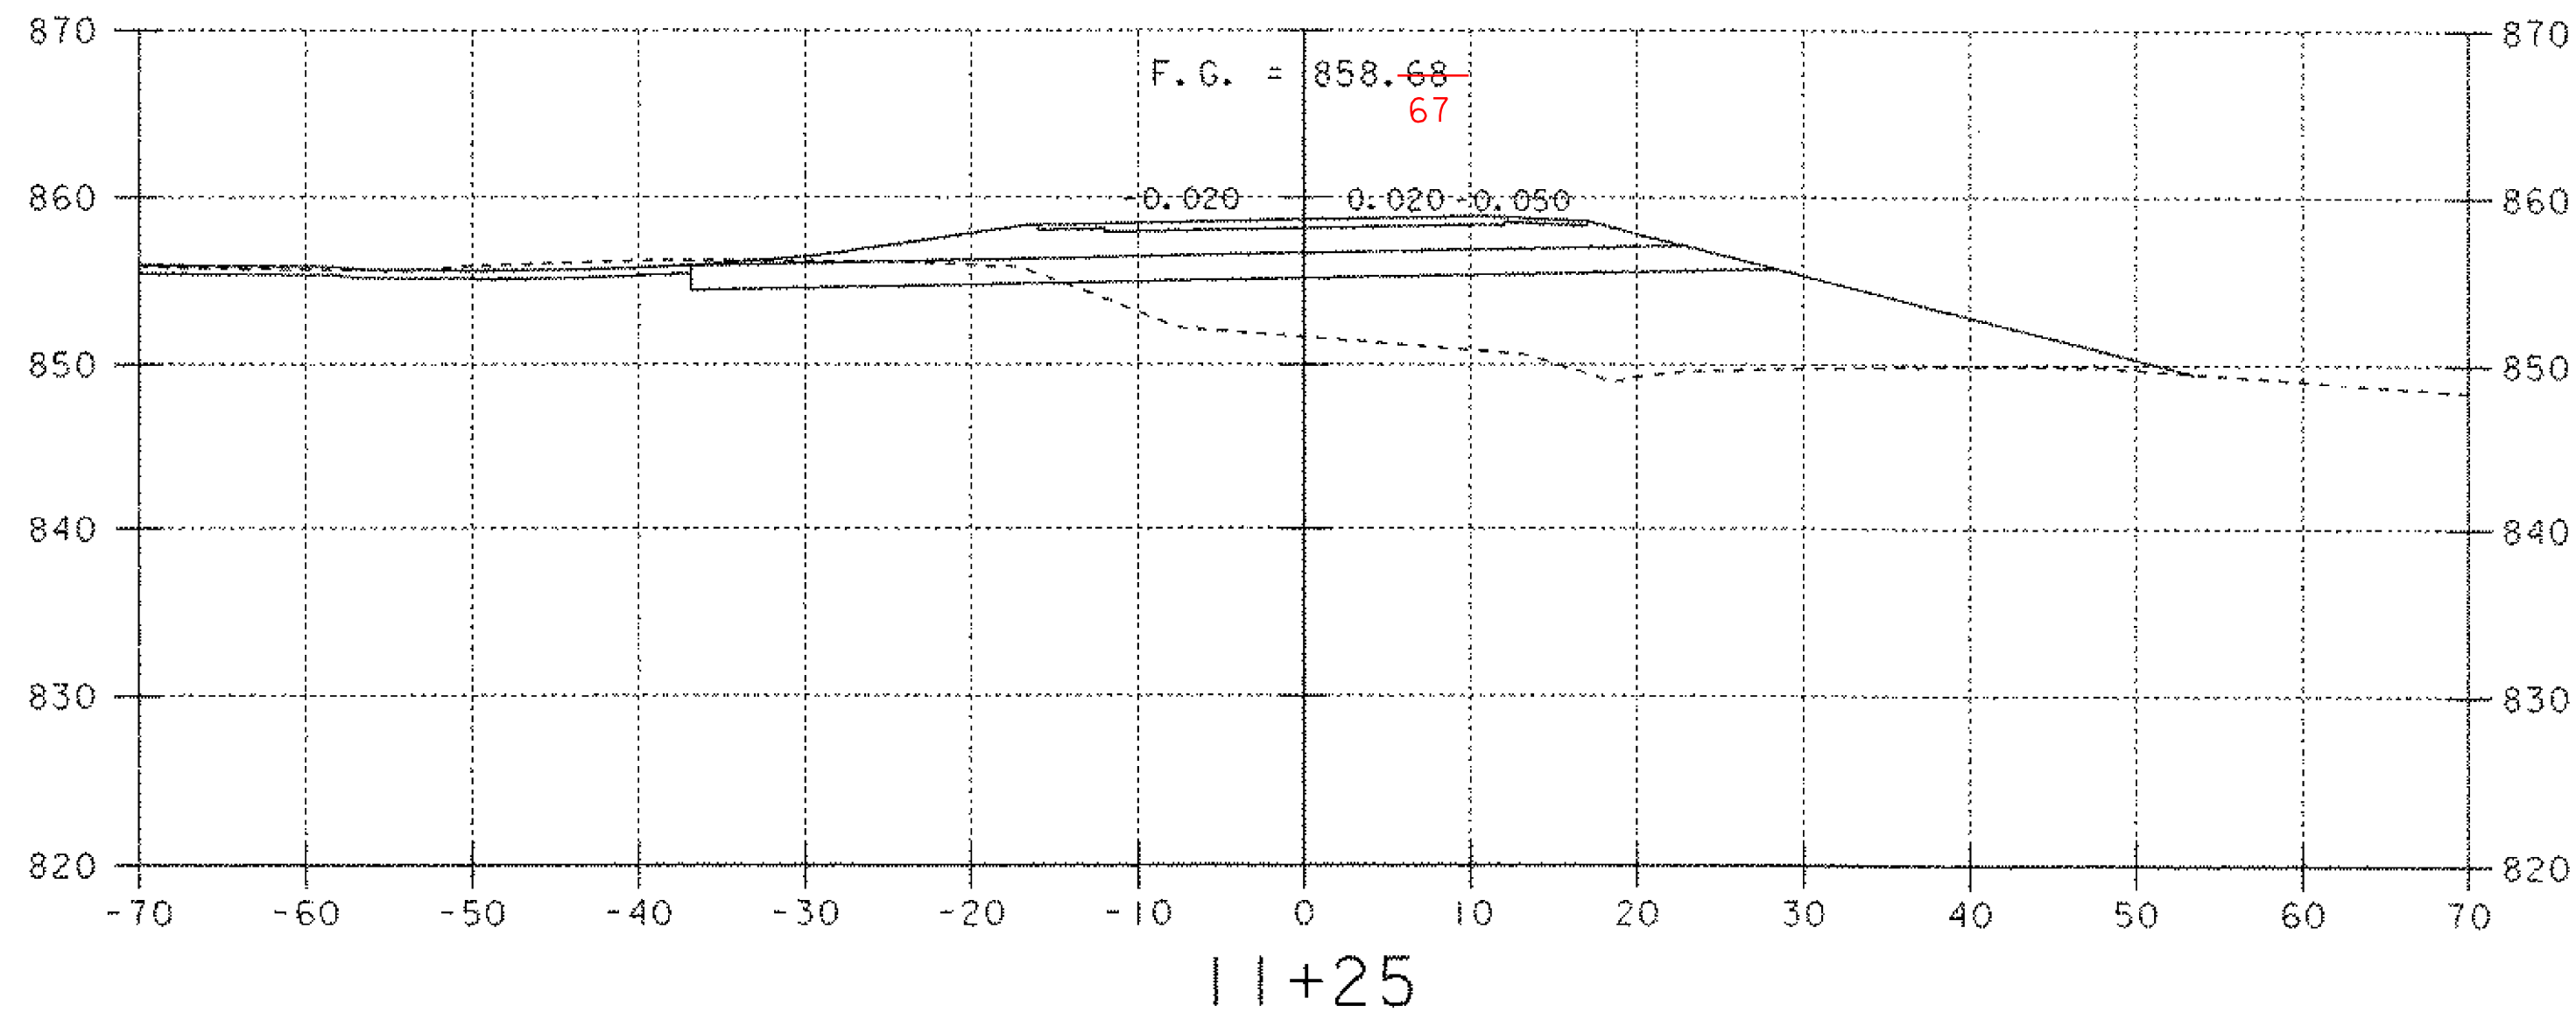


18" X 36' CPEP (SL) PIPE  
11+00 RT. - 10+93 RT.

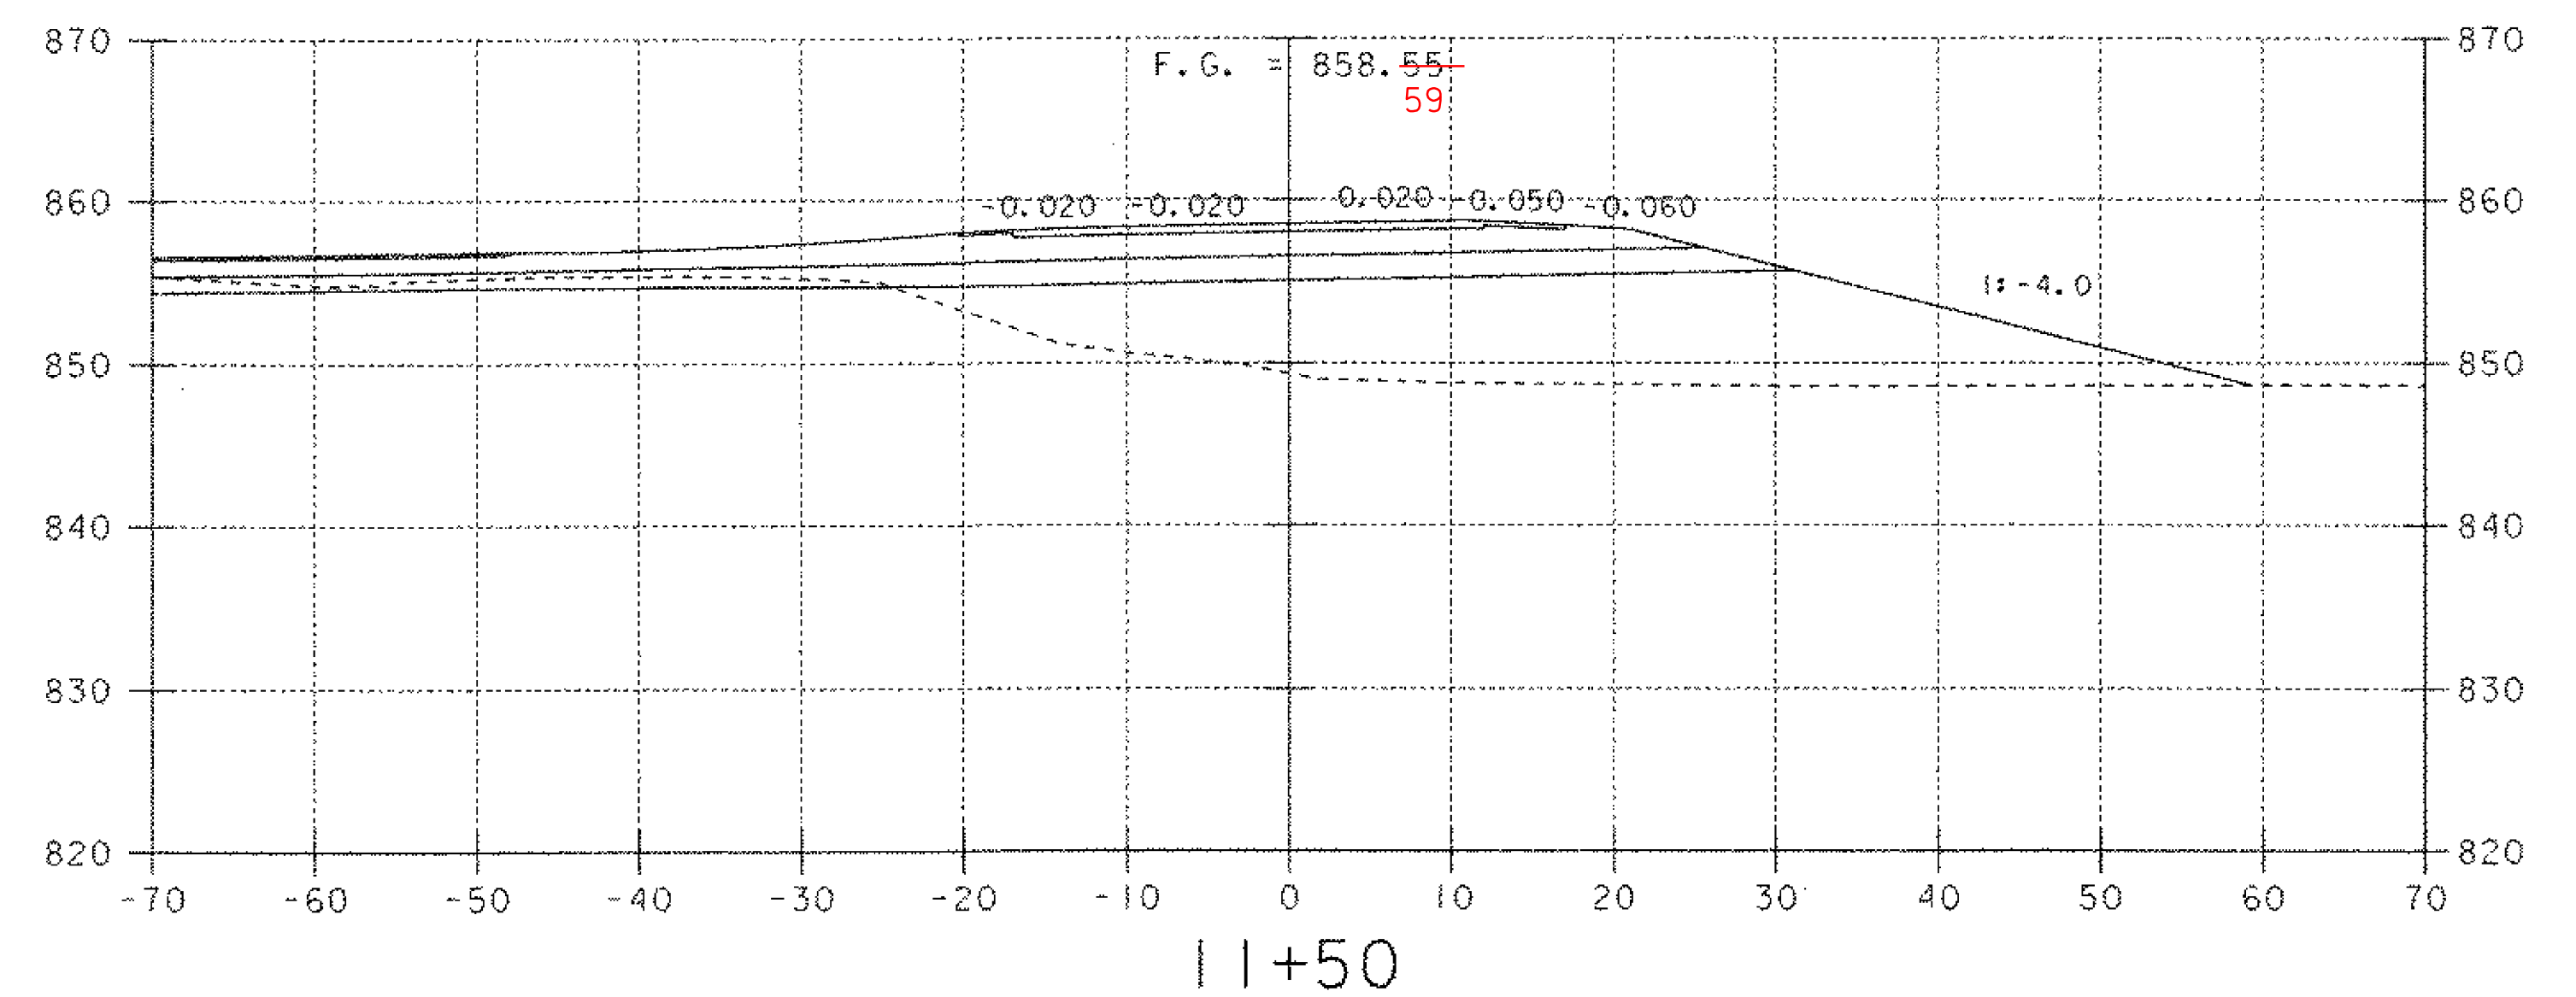

CONSTRUCT DRIVE LEFT

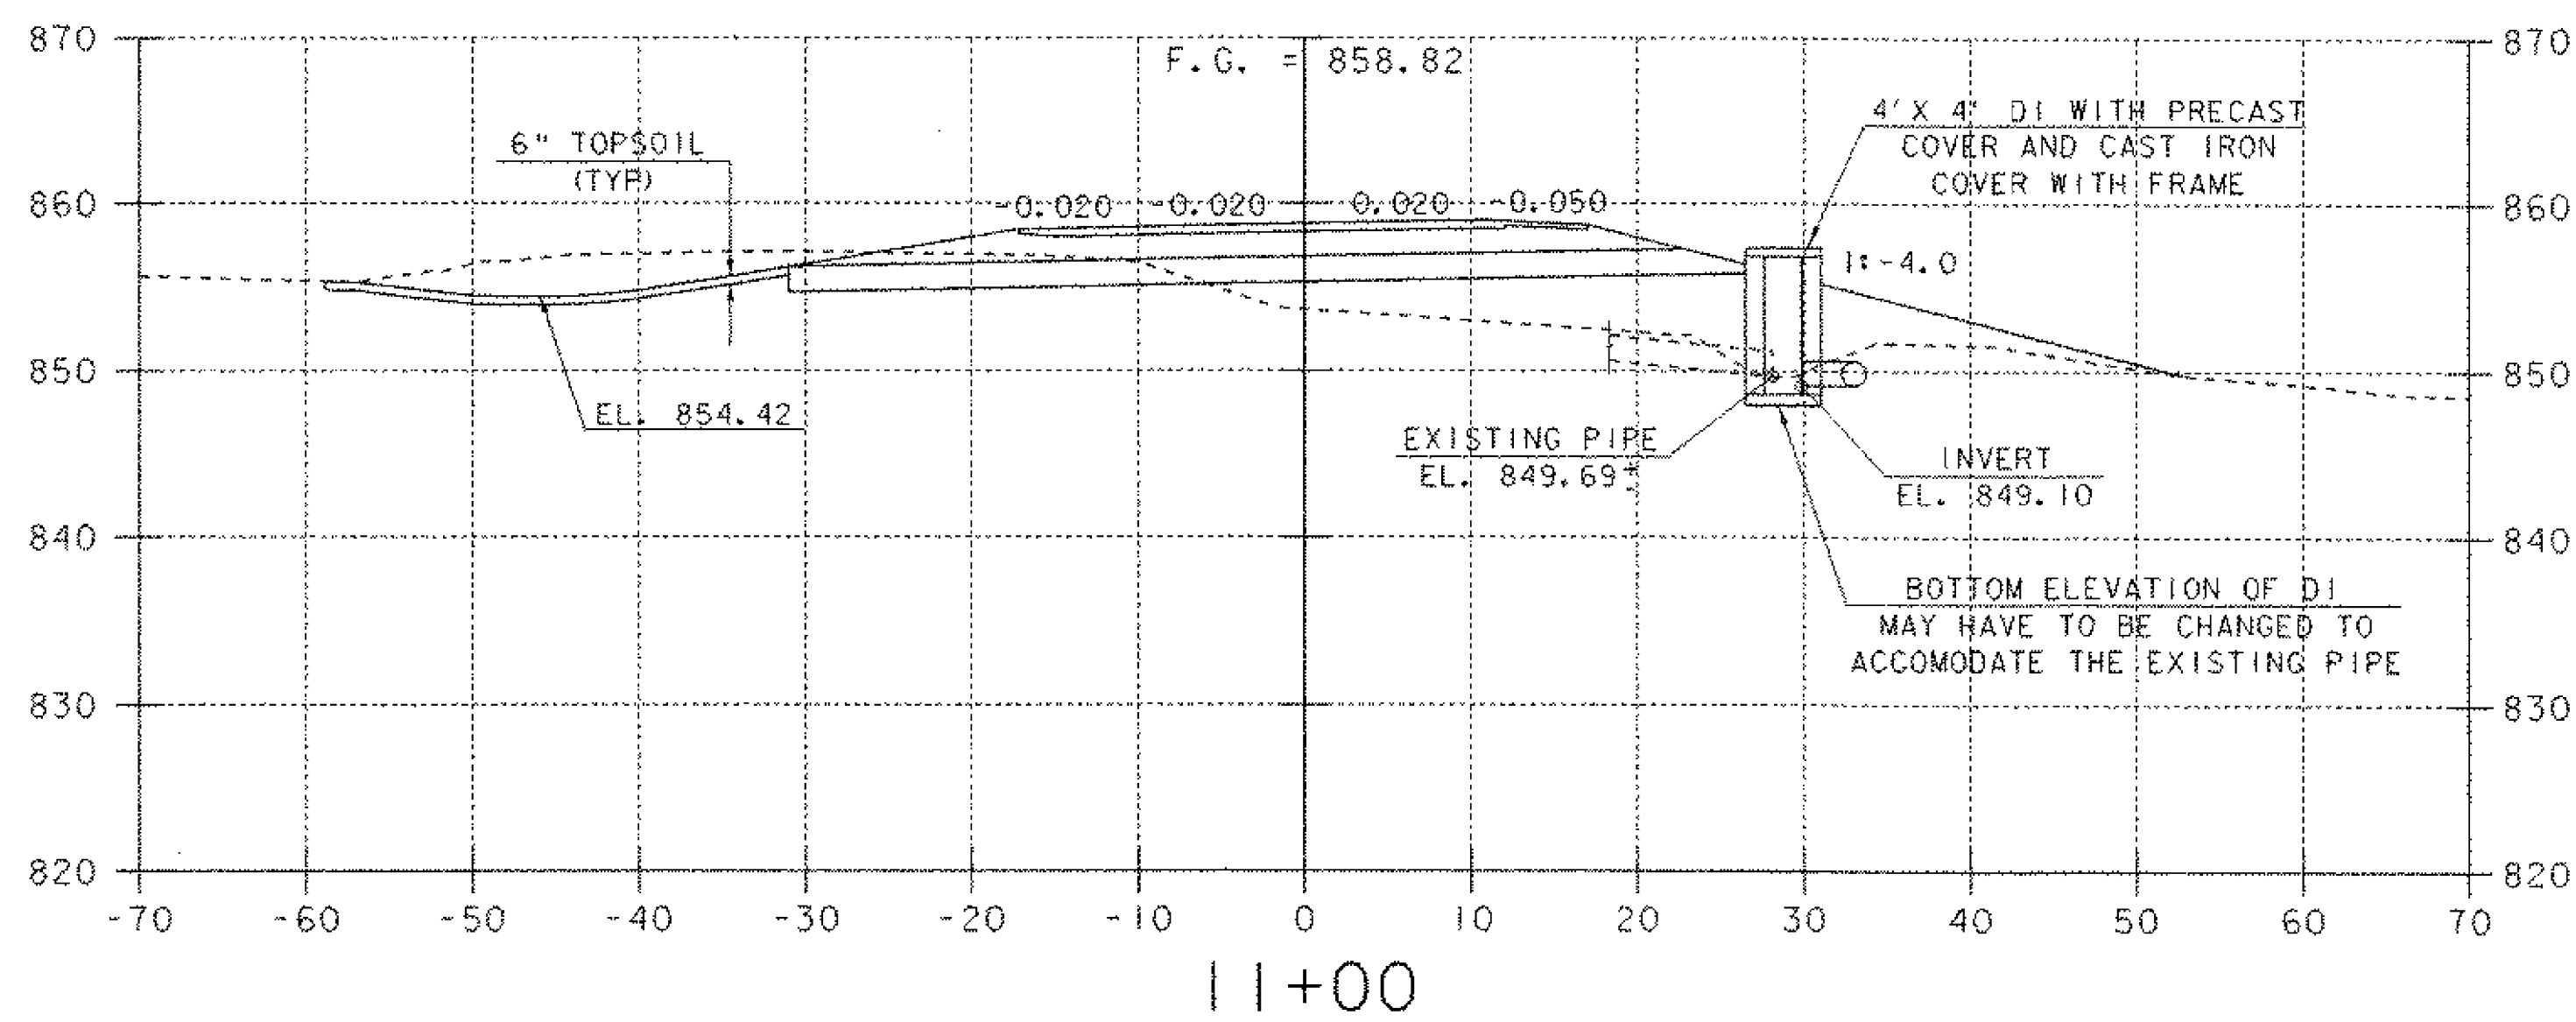

SHEET NAME: MAINLINE CROSS SECTIONS	
PROJECT NAME: READING	HIGHWAY NO.: VT 44
PROJECT NUMBER: BRS 0148(6)S	BRIDGE NO.: 1
	OVER: THE MILL BROOK
FILE NAME: PW/05e034/Structures/se034xst.dgn	PLOT DATE: 17-FEB-2006
PROJECT MANAGER: R. WHITCOMB	DRAWN BY: J. GILMORE
DESIGNED BY: C. CARLSON	IPARM NAME: se034m2.J
BRIDGE SHEET NUMBER:	SHEET 64 OF 83