




18" X 36' CPEP (SL) PIPE
15+88 LT. - 16+20 LT.

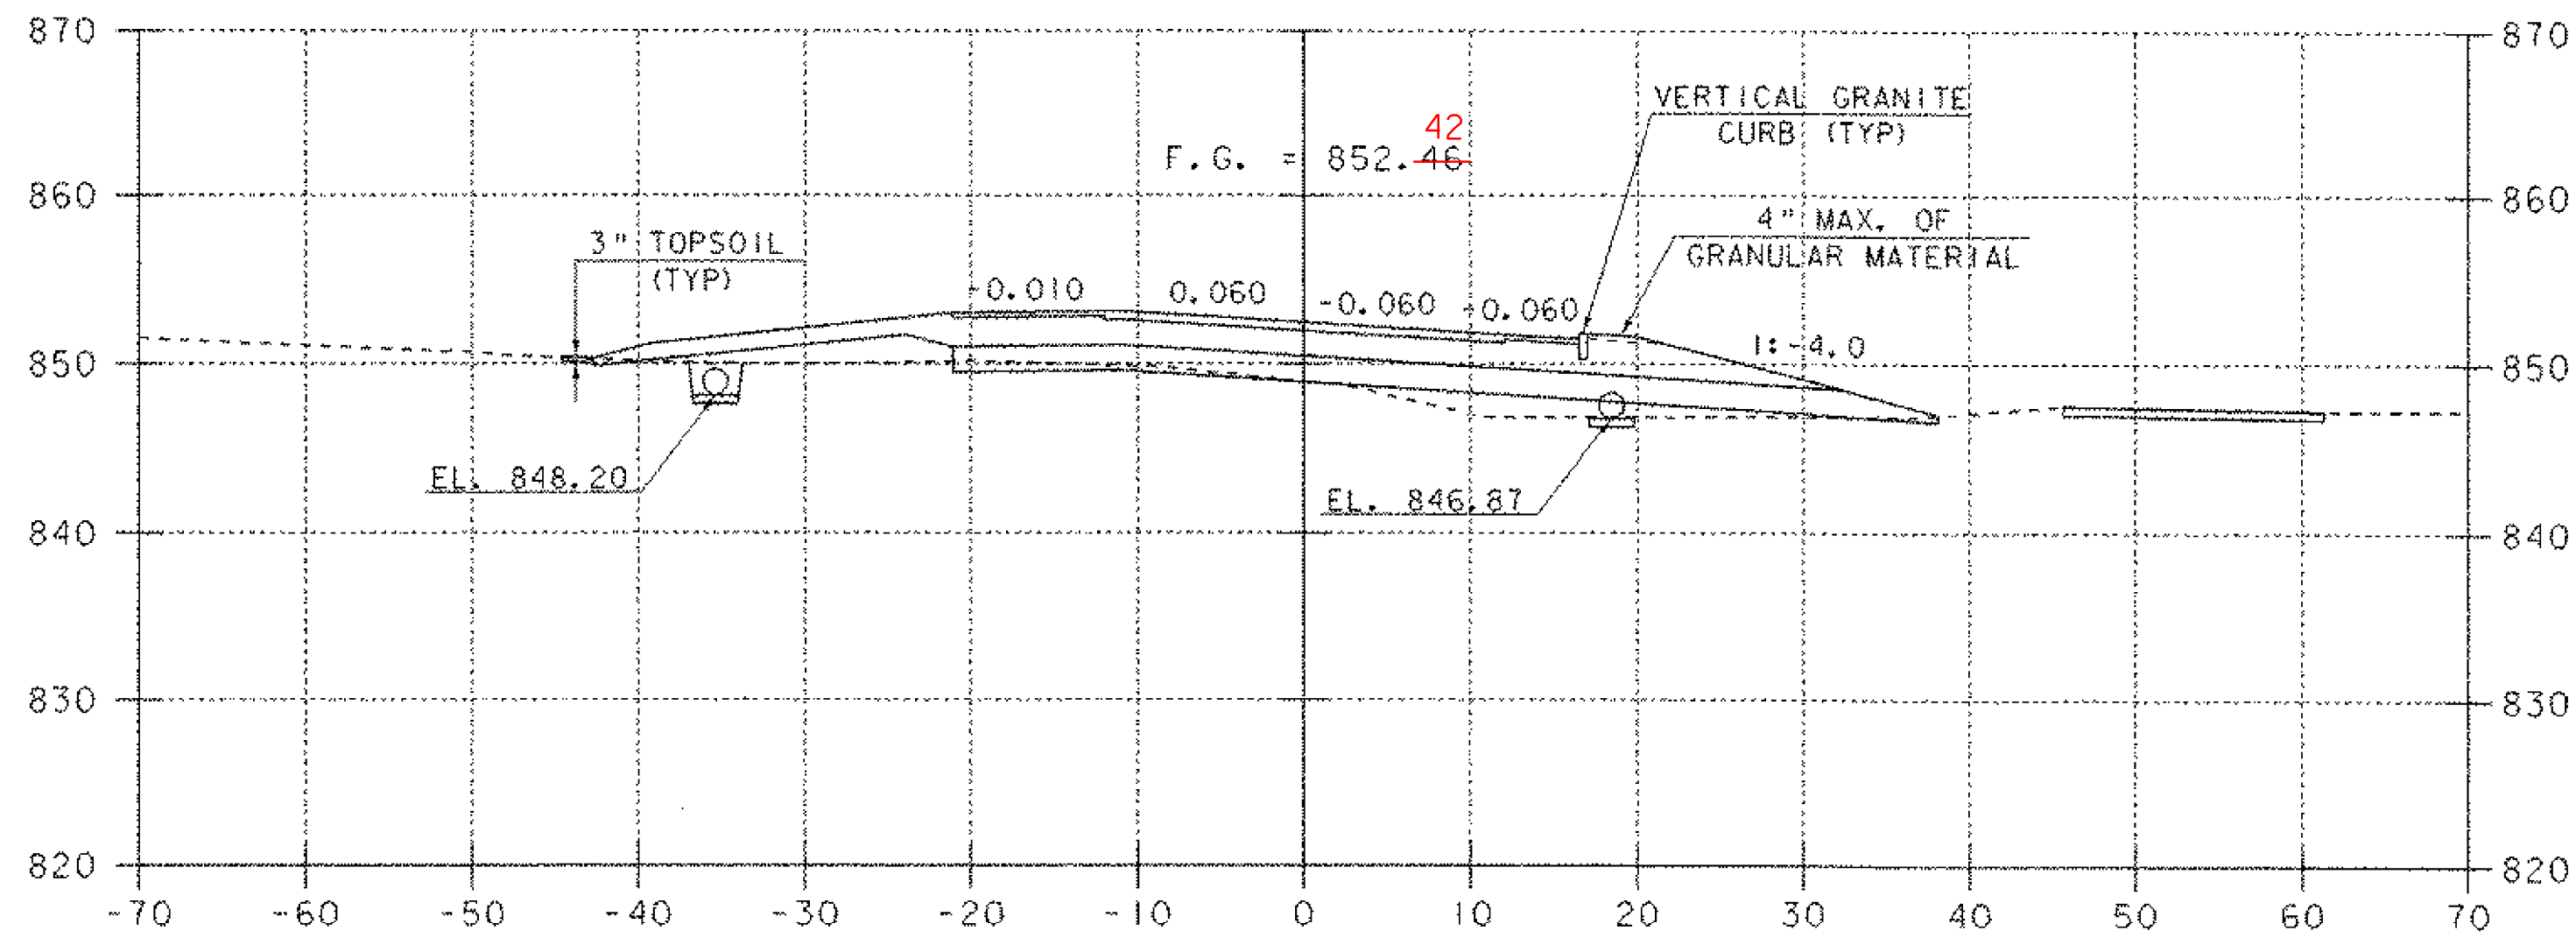


16+00
END PROJECT
BEGIN APPROACH

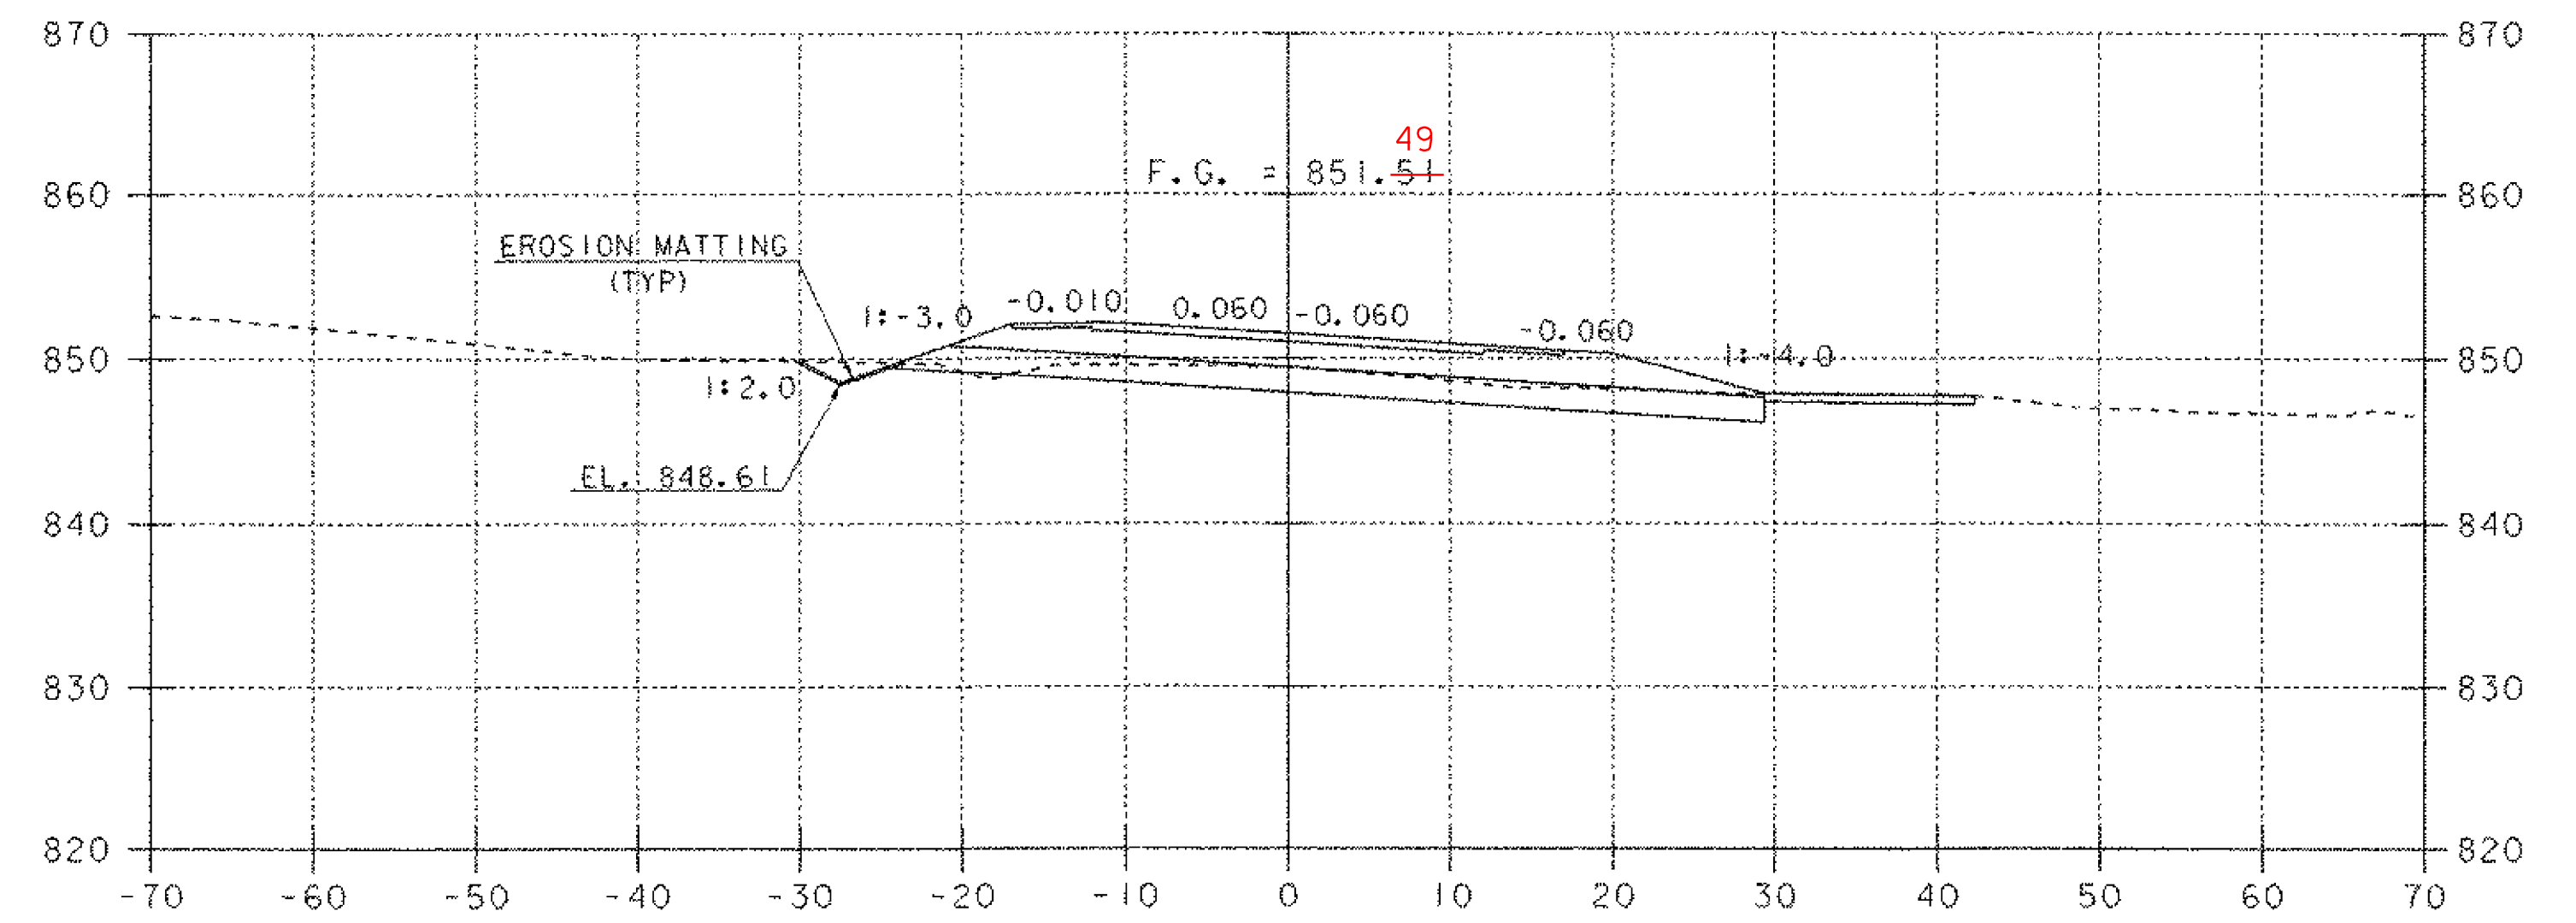

16+50

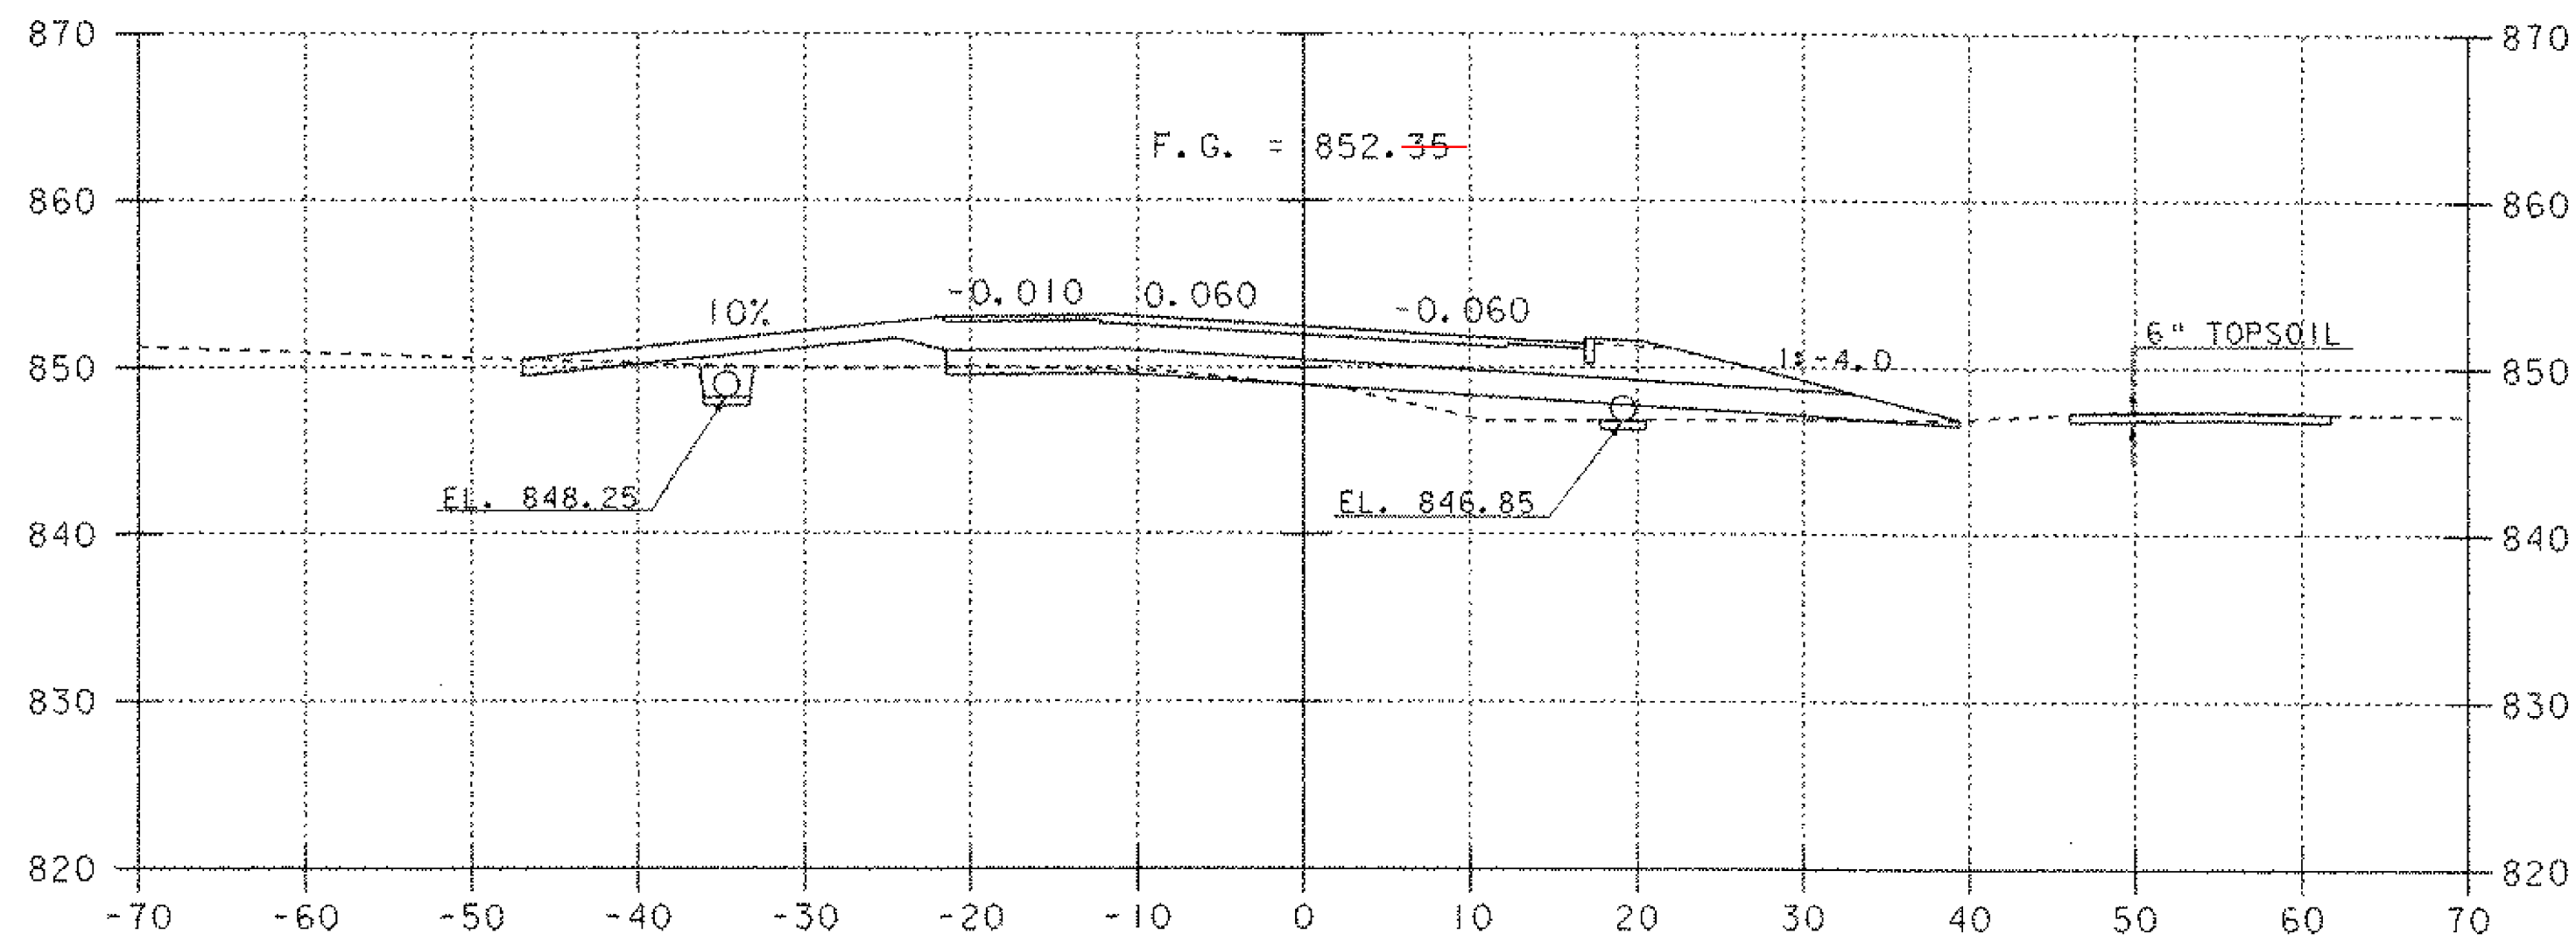

15+99
DRIVE LEFT
SKEW = 12°

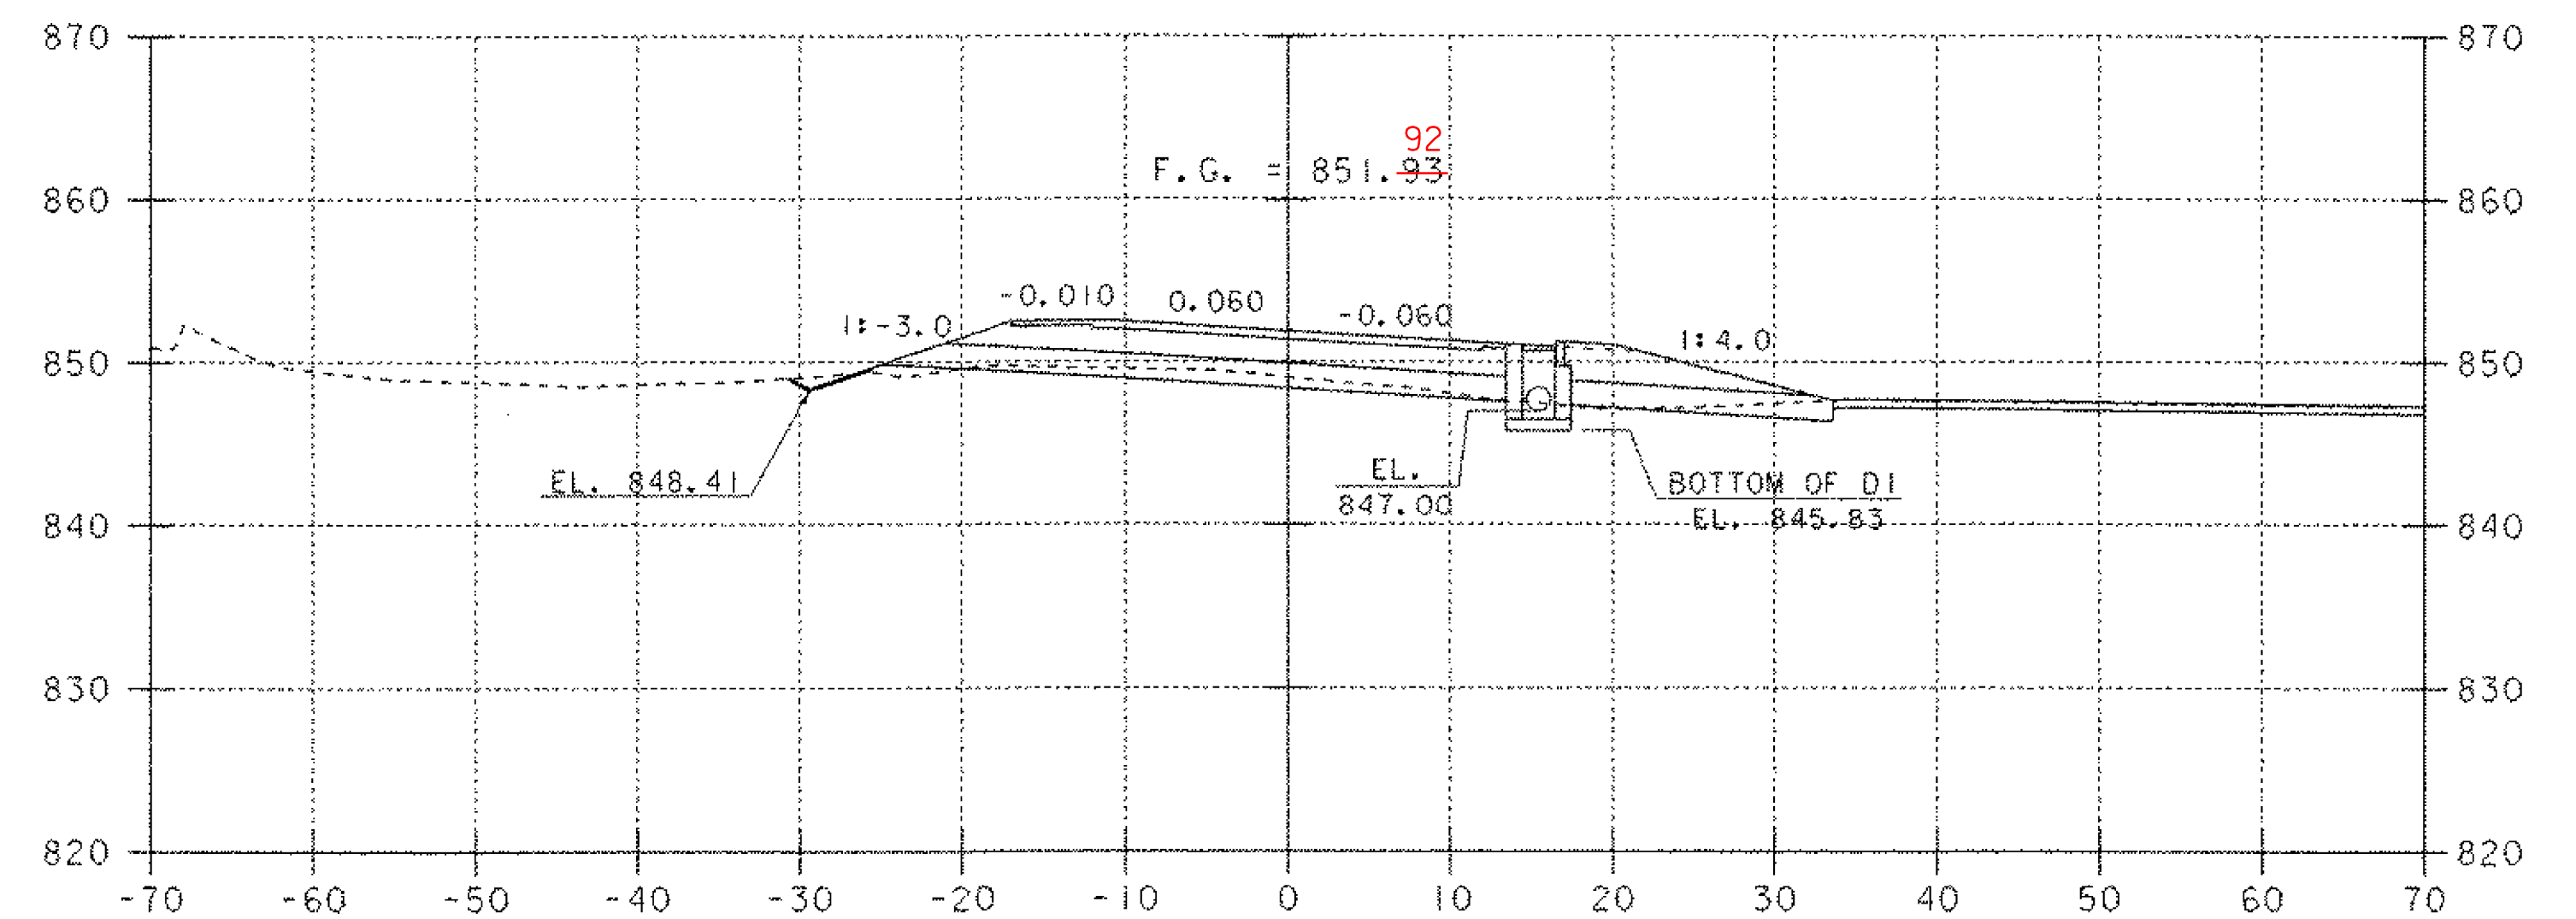

16+25
CONSTRUCT DROP INLET RIGHT

10 0 10
SCALE: 1" = 10'-0"

SHEET NAME: MAINLINE CROSS SECTIONS	
PROJECT NAME: READING	HIGHWAY NO.: VT 44
PROJECT NUMBER: BRS 0148(6)S	BRIDGE NO.: 1
	OVER: THE MILL BROOK
FILE NAME: PW/85e034/Structures/se034xsl.dgn	PLOT DATE: 17-FEB-2006
PROJECT MANAGER: R. WHITCOMB	DRAWN BY: J. GILMORE
DESIGNED BY: C. CARLSON	IPARM NAME: se034m7.1
BRIDGE SHEET NUMBER:	SHEET 69 OF 83