


TYPICAL DRIVE I SECTION

NTS

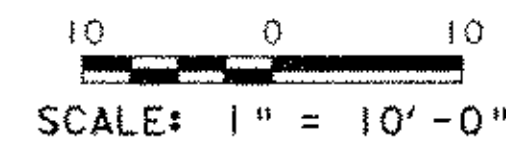

DRIVE I

|  |                        |
|--|------------------------|
| SHEET NAME: PARKING LOT DRIVE CROSS SECTIONS |                        |
| PROJECT NAME: READING                        | HIGHWAY NO.: VT 44     |
| PROJECT NUMBER: BRS 0148(6)S                 | BRIDGE NO.: 1          |
|  | OVER: THE MILL BROOK   |
| FILE NAME: PW/85e034/Structures/se034xsl.dgn | PLOT DATE: 17-FEB-2006 |
| PROJECT MANAGER: R. WHITCOMB                 | DRAWN BY: J. GILMORE   |
| DESIGNED BY: C. CARLSON                      | IPARM NAME: se034dxl1  |
| BRIDGE SHEET NUMBER:                         | SHEET 73 OF 83         |