



4+27
 DRIVE LEFT
 SKEW = 90° FROM CENTERLINE

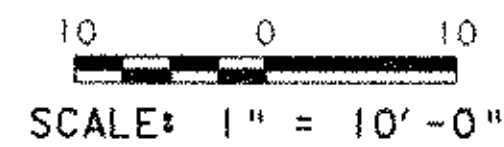

* THE COST OF CONCRETE BASES SHALL BE INCIDENTAL TO ITEM 620.21, "BRACING ASSEMBLY FOR CHAIN LINK FENCE, 6 FEET".

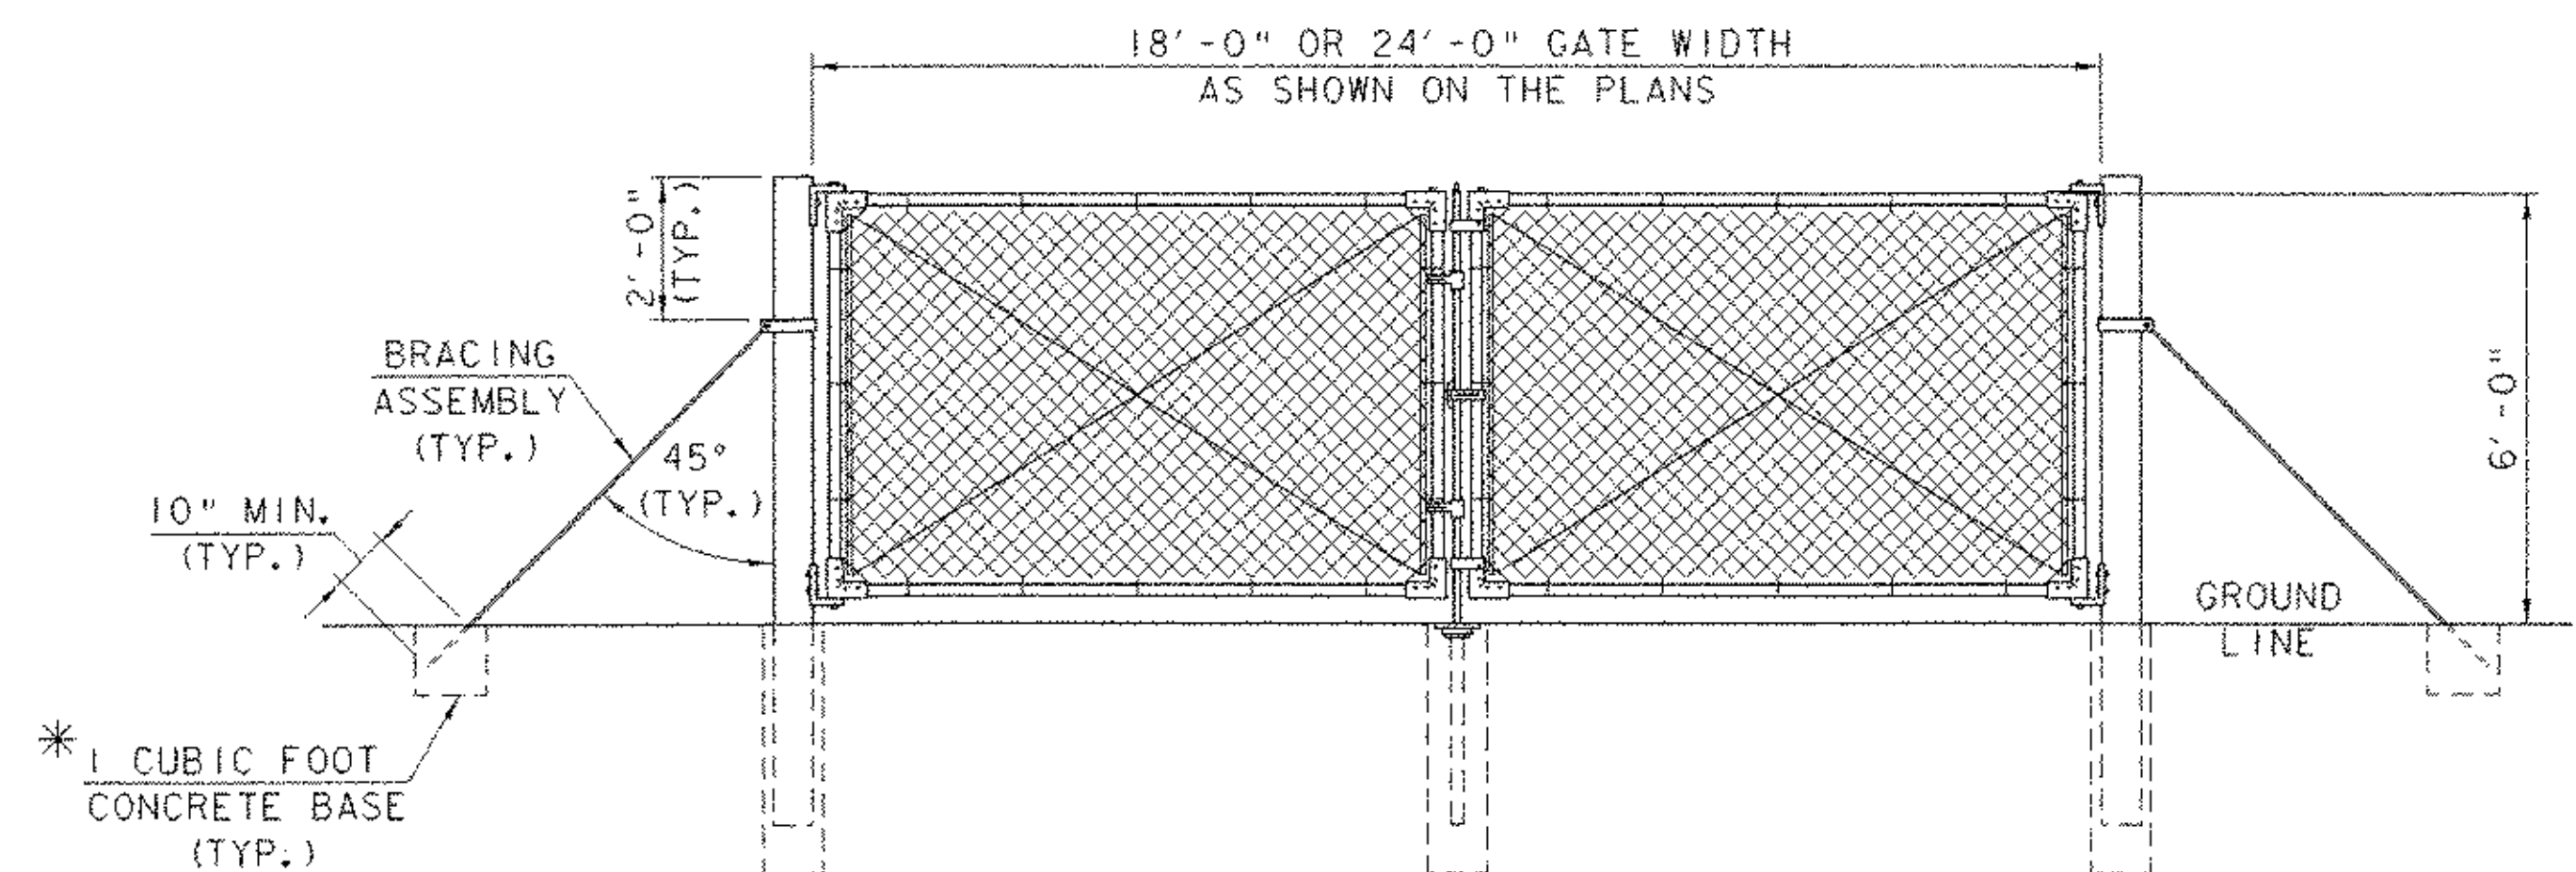

DRIVE GATE DETAIL Δ
 NOT TO SCALE
 (SEE STANDARD F-4 FOR ADDITIONAL DETAILS)

DRIVE 4

KEY	DATE	BY	REVISION
Δ	03/22/2006	VAOT	ADDED DRIVE GATE DETAIL

SHEET NAME: CIRCLE DRIVE CROSS SECTIONS	
PROJECT NAME: READING	HIGHWAY NO.: VT 44
PROJECT NUMBER: BRS 0148(6)S	BRIDGE NO.: 1
	OVER: THE MILL BROOK
FILE NAME: PW/85e034/Structures/se034xsl.dgn	PLOT DATE: 28-MAR-2006
PROJECT MANAGER: R. WHITCOMB	DRAWN BY: J. GILMORE
DESIGNED BY: C. CARLSON	IPARM NAME: se034wd3.1
BRIDGE SHEET NUMBER:	SHEET 78 OF 83