

FOR INDEX, SEE SHEET 2

# STATE OF VERMONT AGENCY OF TRANSPORTATION



## PROPOSED IMPROVEMENT BRIDGE PROJECT

TOWN OF STOWE


COUNTY OF LAMOILLE

ROUTE NO : VT 100 (MINOR ARTERIAL) BRIDGE NO : 208


PROJECT LOCATION : BEGINNING AT A POINT APPROXIMATELY 300 FEET SOUTH OF THE JUNCTION OF VT 100 AND TH 52 (GOLD BROOK ROAD) AND EXTENDING NORTHERLY ALONG VT 100 FOR 225 FEET.

PROJECT DESCRIPTION : THE PROJECT SHALL CONSIST OF REPLACEMENT OF THE EXISTING STRUCTURE WITH A NEW INTEGRAL ABUTMENT STRUCTURE INCLUDING RELATED ROADWAY AND CHANNEL WORK.

LENGTH OF STRUCTURE : 75.78 FEET.  
LENGTH OF ROADWAY : 149.22 FEET.  
LENGTH OF PROJECT : 225.00 FEET.

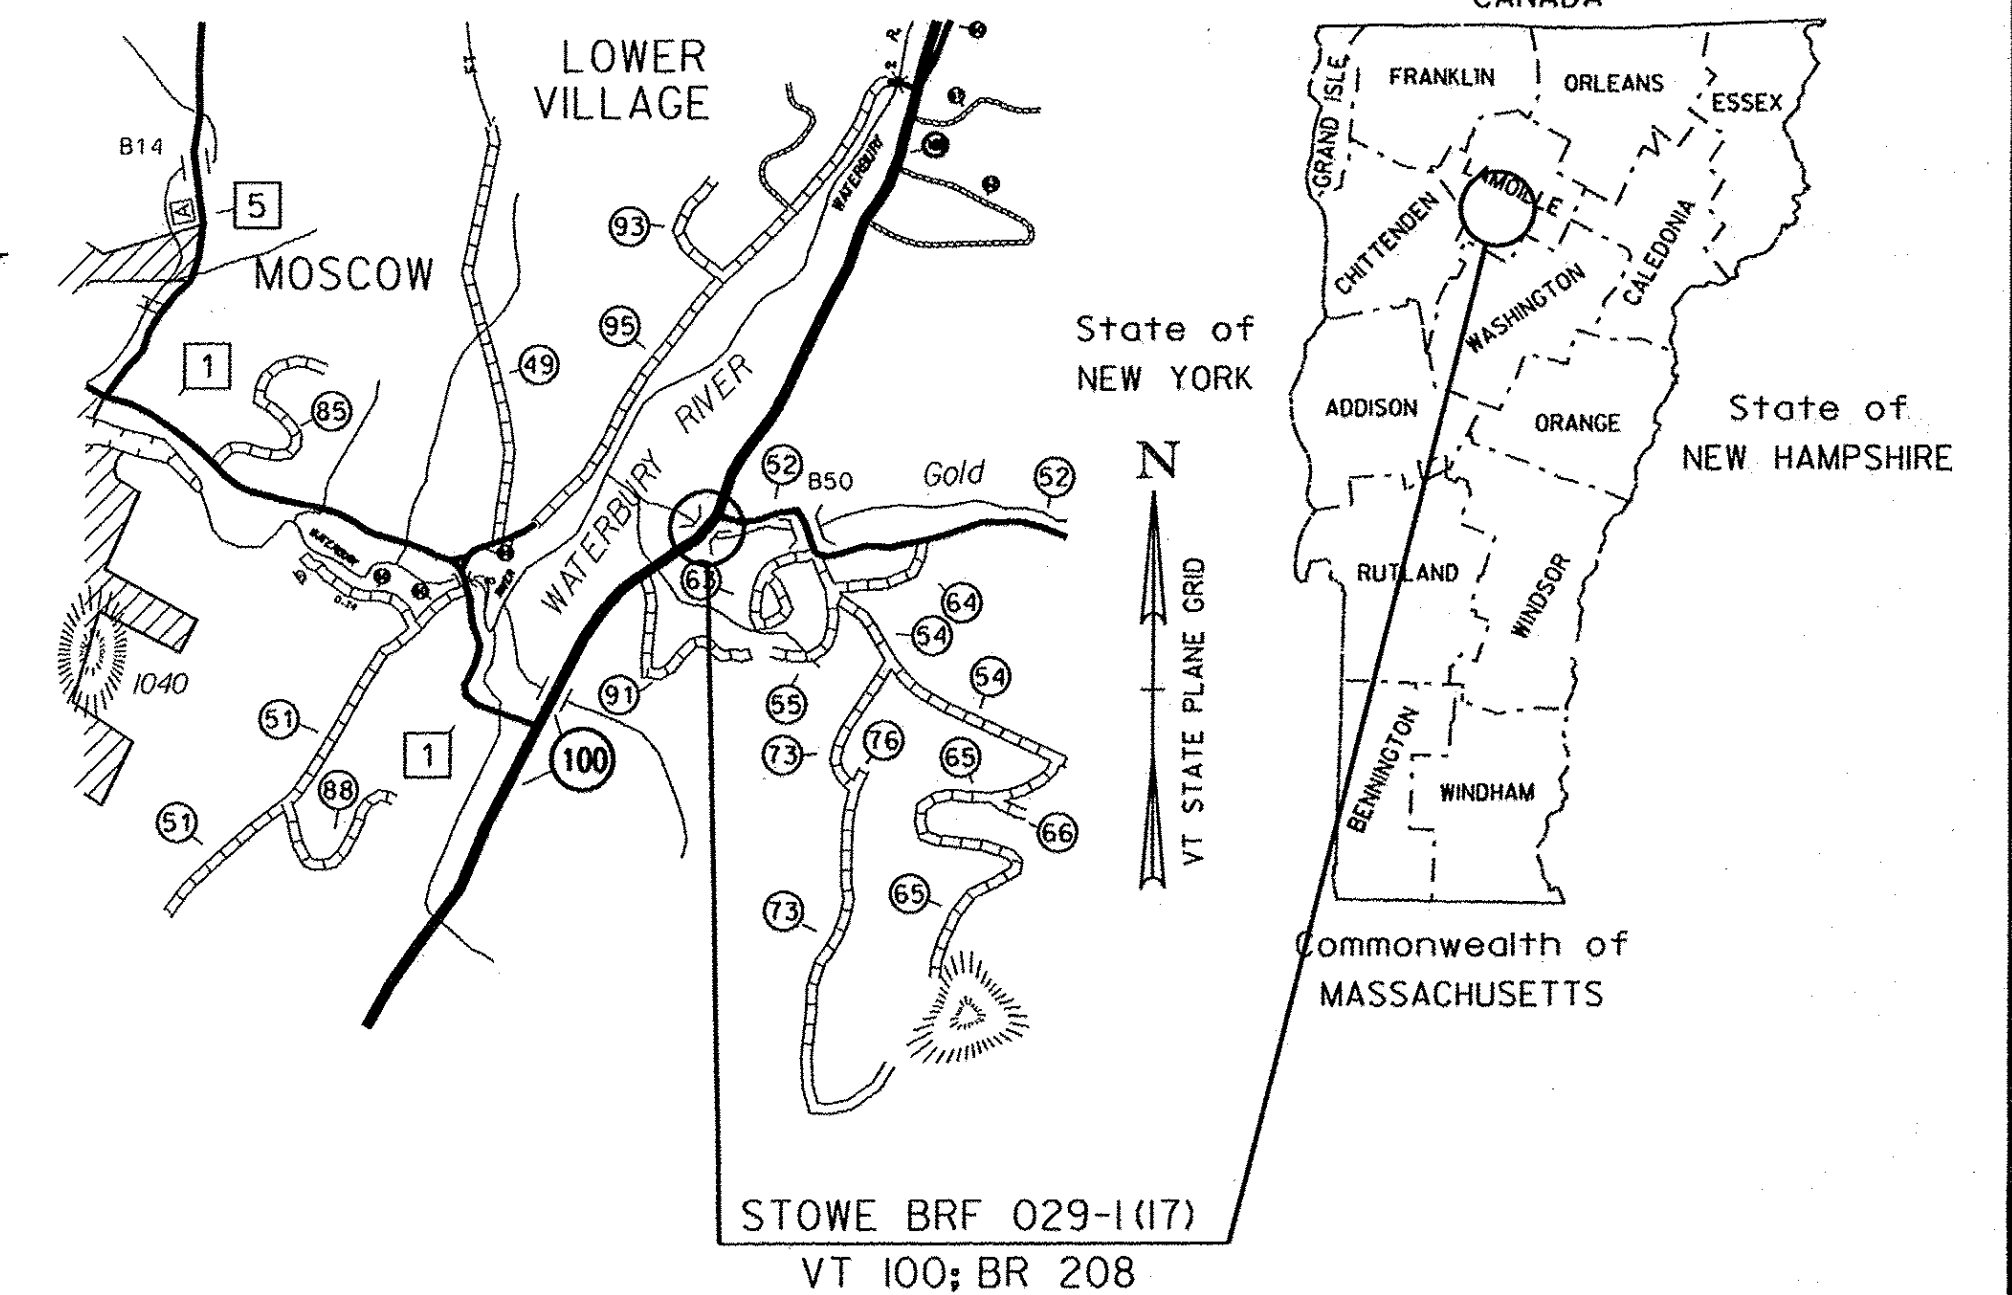

RECORD PLANS	
CONTRACTOR:	AUSTIN CONSTRUCTION, INC. - CONCORD, VT
RESIDENT ENGINEER:	RICK HALE
CONSTRUCTION BEGAN:	APRIL 14, 2014
CONSTRUCTION COMPLETE:	SEPTEMBER 26, 2014
RECORD PLANS BY:	RICK HALE & KEVIN KING
I HEREBY CERTIFY THAT ALL THE CONSTRUCTION REQUIRED BY THIS SET OF DRAWINGS HAS BEEN ACCOMPLISHED AS INDICATED HEREIN.	
BY	<i>Rick Hale</i> RESIDENT ENGINEER
DATE	6/1/16
NOTE: Any further information concerning final quantities, amounts or other details relative to this project may be found at Central Files in the electronic archives.	

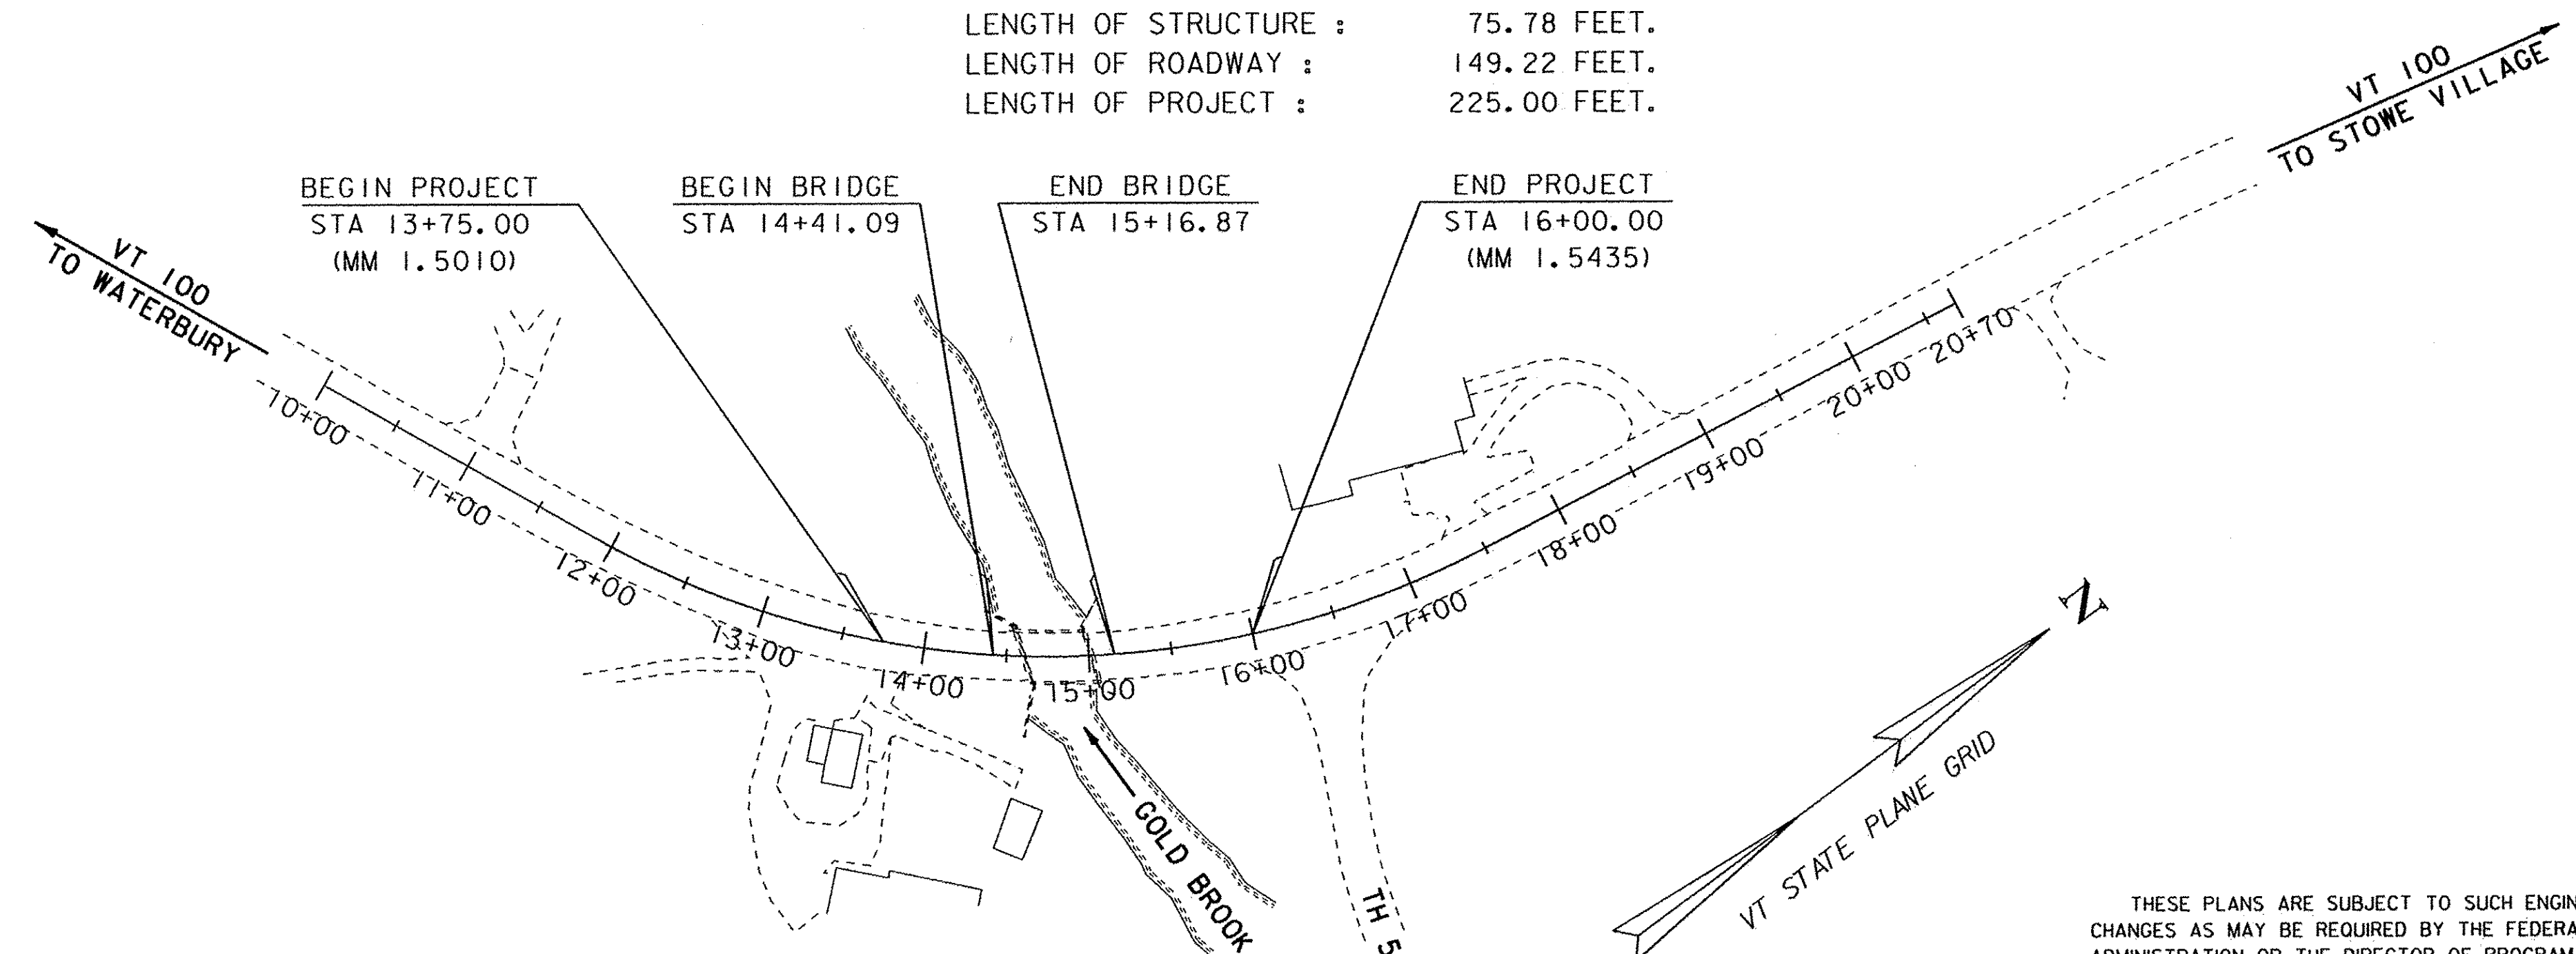

QUALITY ASSURANCE PROGRAM: LEVEL 2

CONVENTIONAL SYMBOLS	
COUNTY LINE	
TOWN LINE	
LIMITS OF ACCESS	
POINT OF ACCESS	
FENCE LINE	
STONE WALL	
TRAVELED WAY	
GUARD RAIL	
RAILROAD	
SURVEY LINE	
CULVERT	
POWER POLE	
TELEPHONE POLE	
TREES	
CONTROL OF ACCESS	
PROPERTY LINE	
R.O.W. TAKING LINE	
SLOPE RIGHTS	
TOP OF CUT	
TOE OF SLOPE	

SURVEYED BY :	R. GILMAN
SURVEYED DATE :	7/27/2007
DATUM	
VERTICAL	NAVD88
HORIZONTAL	NAD83

SCALE: 1" = 80'-0"

THESE PLANS ARE SUBJECT TO SUCH ENGINEERING CHANGES AS MAY BE REQUIRED BY THE FEDERAL HIGHWAY ADMINISTRATION OR THE DIRECTOR OF PROGRAM DEVELOPMENT.  
CONSTRUCTION IS TO BE CARRIED ON IN ACCORDANCE WITH THESE PLANS AND THE STANDARD SPECIFICATIONS FOR CONSTRUCTION DATED 2011, AS APPROVED BY THE FEDERAL HIGHWAY ADMINISTRATION ON JULY 20, 2011 FOR USE ON THIS PROJECT, INCLUDING ALL SUBSEQUENT REVISIONS AND SUCH REVISED SPECIFICATIONS AND SPECIAL PROVISIONS AS ARE INCORPORATED IN THESE PLANS.

DIRECTOR OF PROGRAM DEVELOPMENT	
APPROVED <i>Richard Schmidt</i>	DATE 6-12-13
PROJECT MANAGER : CAROLYN CARLSON P.E.	
PROJECT NAME :	STOWE
PROJECT NUMBER :	BR F 029-1 (17)
SHEET 1 OF 70 SHEETS	