



VT 100 PROFILE

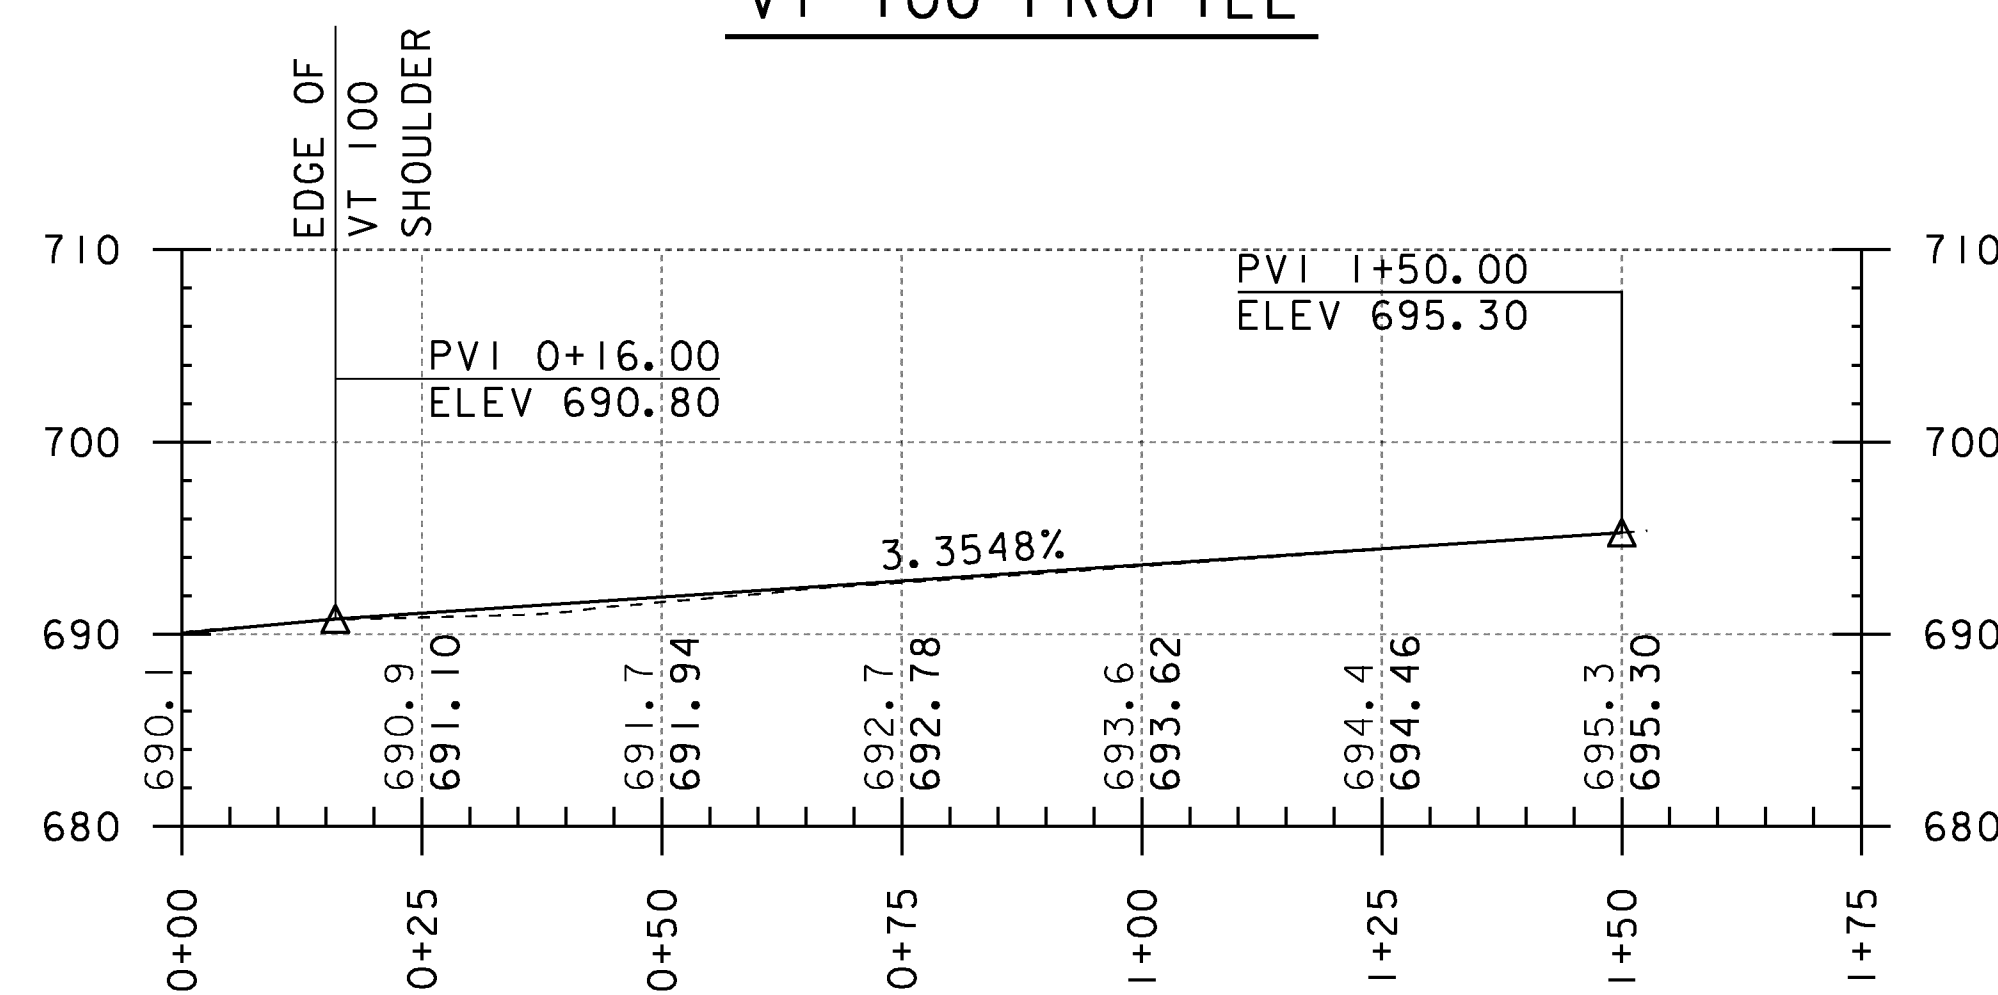

TH 52 PROFILE

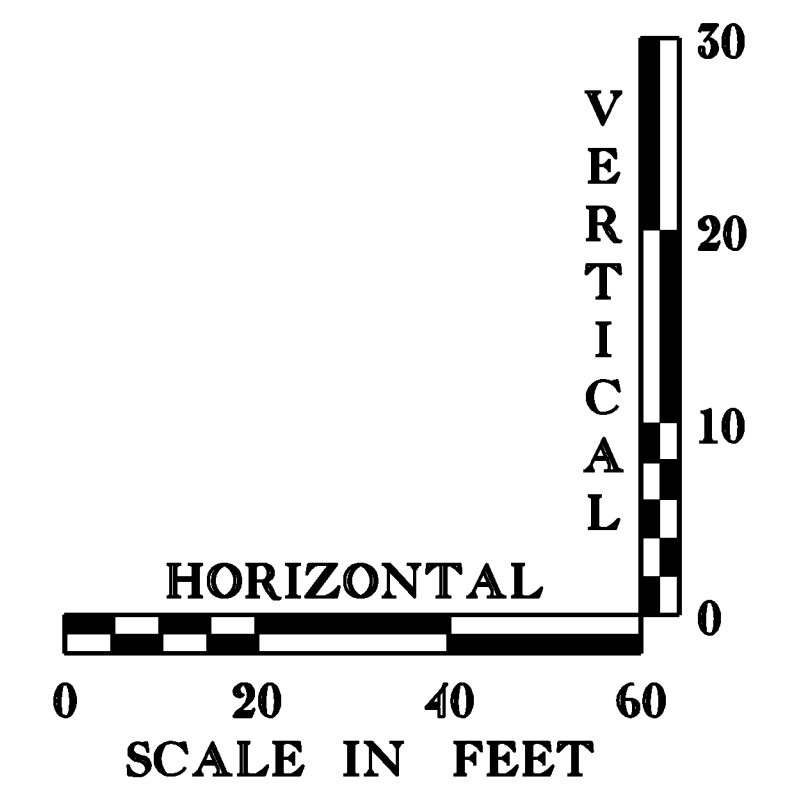

NOTES:

GRADES SHOWN TO THE NEAREST TENTH ARE EXISTING GROUND ALONG ϕ .

GRADES SHOWN TO THE NEAREST HUNDRETH ARE FINISH GRADE ALONG ϕ .

PROJECT NAME: STOWE
PROJECT NUMBER: BRF 029-1(17)

FILE NAME: s85e037pro.dgn
PROJECT LEADER: C. CARLSON
DESIGNED BY: H. SALLS
PROFILES

PLOT DATE: 17-JUN-2013
DRAWN BY: R. PELLET
CHECKED BY: G. ROY
SHEET 14 OF 70