

4 INCH WHITE LINE
 VT 100 STA 12+75.0 LT - VT 100 STA 17+00.0 LT
 VT 100 STA 12+75.0 RT - TH 52 STA 0+45.0 RT
 TH 52 STA 0+45.0 LT - VT 100 STA 17+00.0 RT

4 INCH YELLOW LINE
 VT 100 STA 12+75.0 - VT 100 STA 16+10.0 C (DOUBLE)
 VT 100 STA 16+50.0 - VT 100 STA 17+00.0 C (DOUBLE)
 TH 52 STA 0+21.0 - TH 52 STA 1+50.0 C (DOUBLE)

DURABLE 24 INCH STOP BAR

STA 0+21.0 LT
 0+25.0

DURABLE LETTER OR SYMBOL

STA 0+35.0 LT (4 EA)
 0+39.0

TRAFFIC SIGNS, TYPE A



STA 14+39.0 RT (1 EA)
 STA 15+21.4 LT (1 EA)
 STA 0+39.5 LT (1 EA)
 STA 0+49.7 RT (1 EA)
 STA 14+23.4 RT (1 EA)

REMOVING SIGNS

STA 14+22.6 RT (1 EA) 15+21.4 LT
 STA 14+62.4 RT (1 EA)
 STA 14+64.2 RT (1 EA)
 STA 15+09.5 RT (1 EA)
 STA 15+61.8 RT (1 EA)
 STA 0+39.1 LT (1 EA)
 STA 0+57.5 LT (2 EA)

ERECTING SALVAGED SIGNS


STA 14+23.4 RT (1 EA)
 STA 15+61.1 RT (1 EA)
 STA 0+39.5 LT (1 EA)

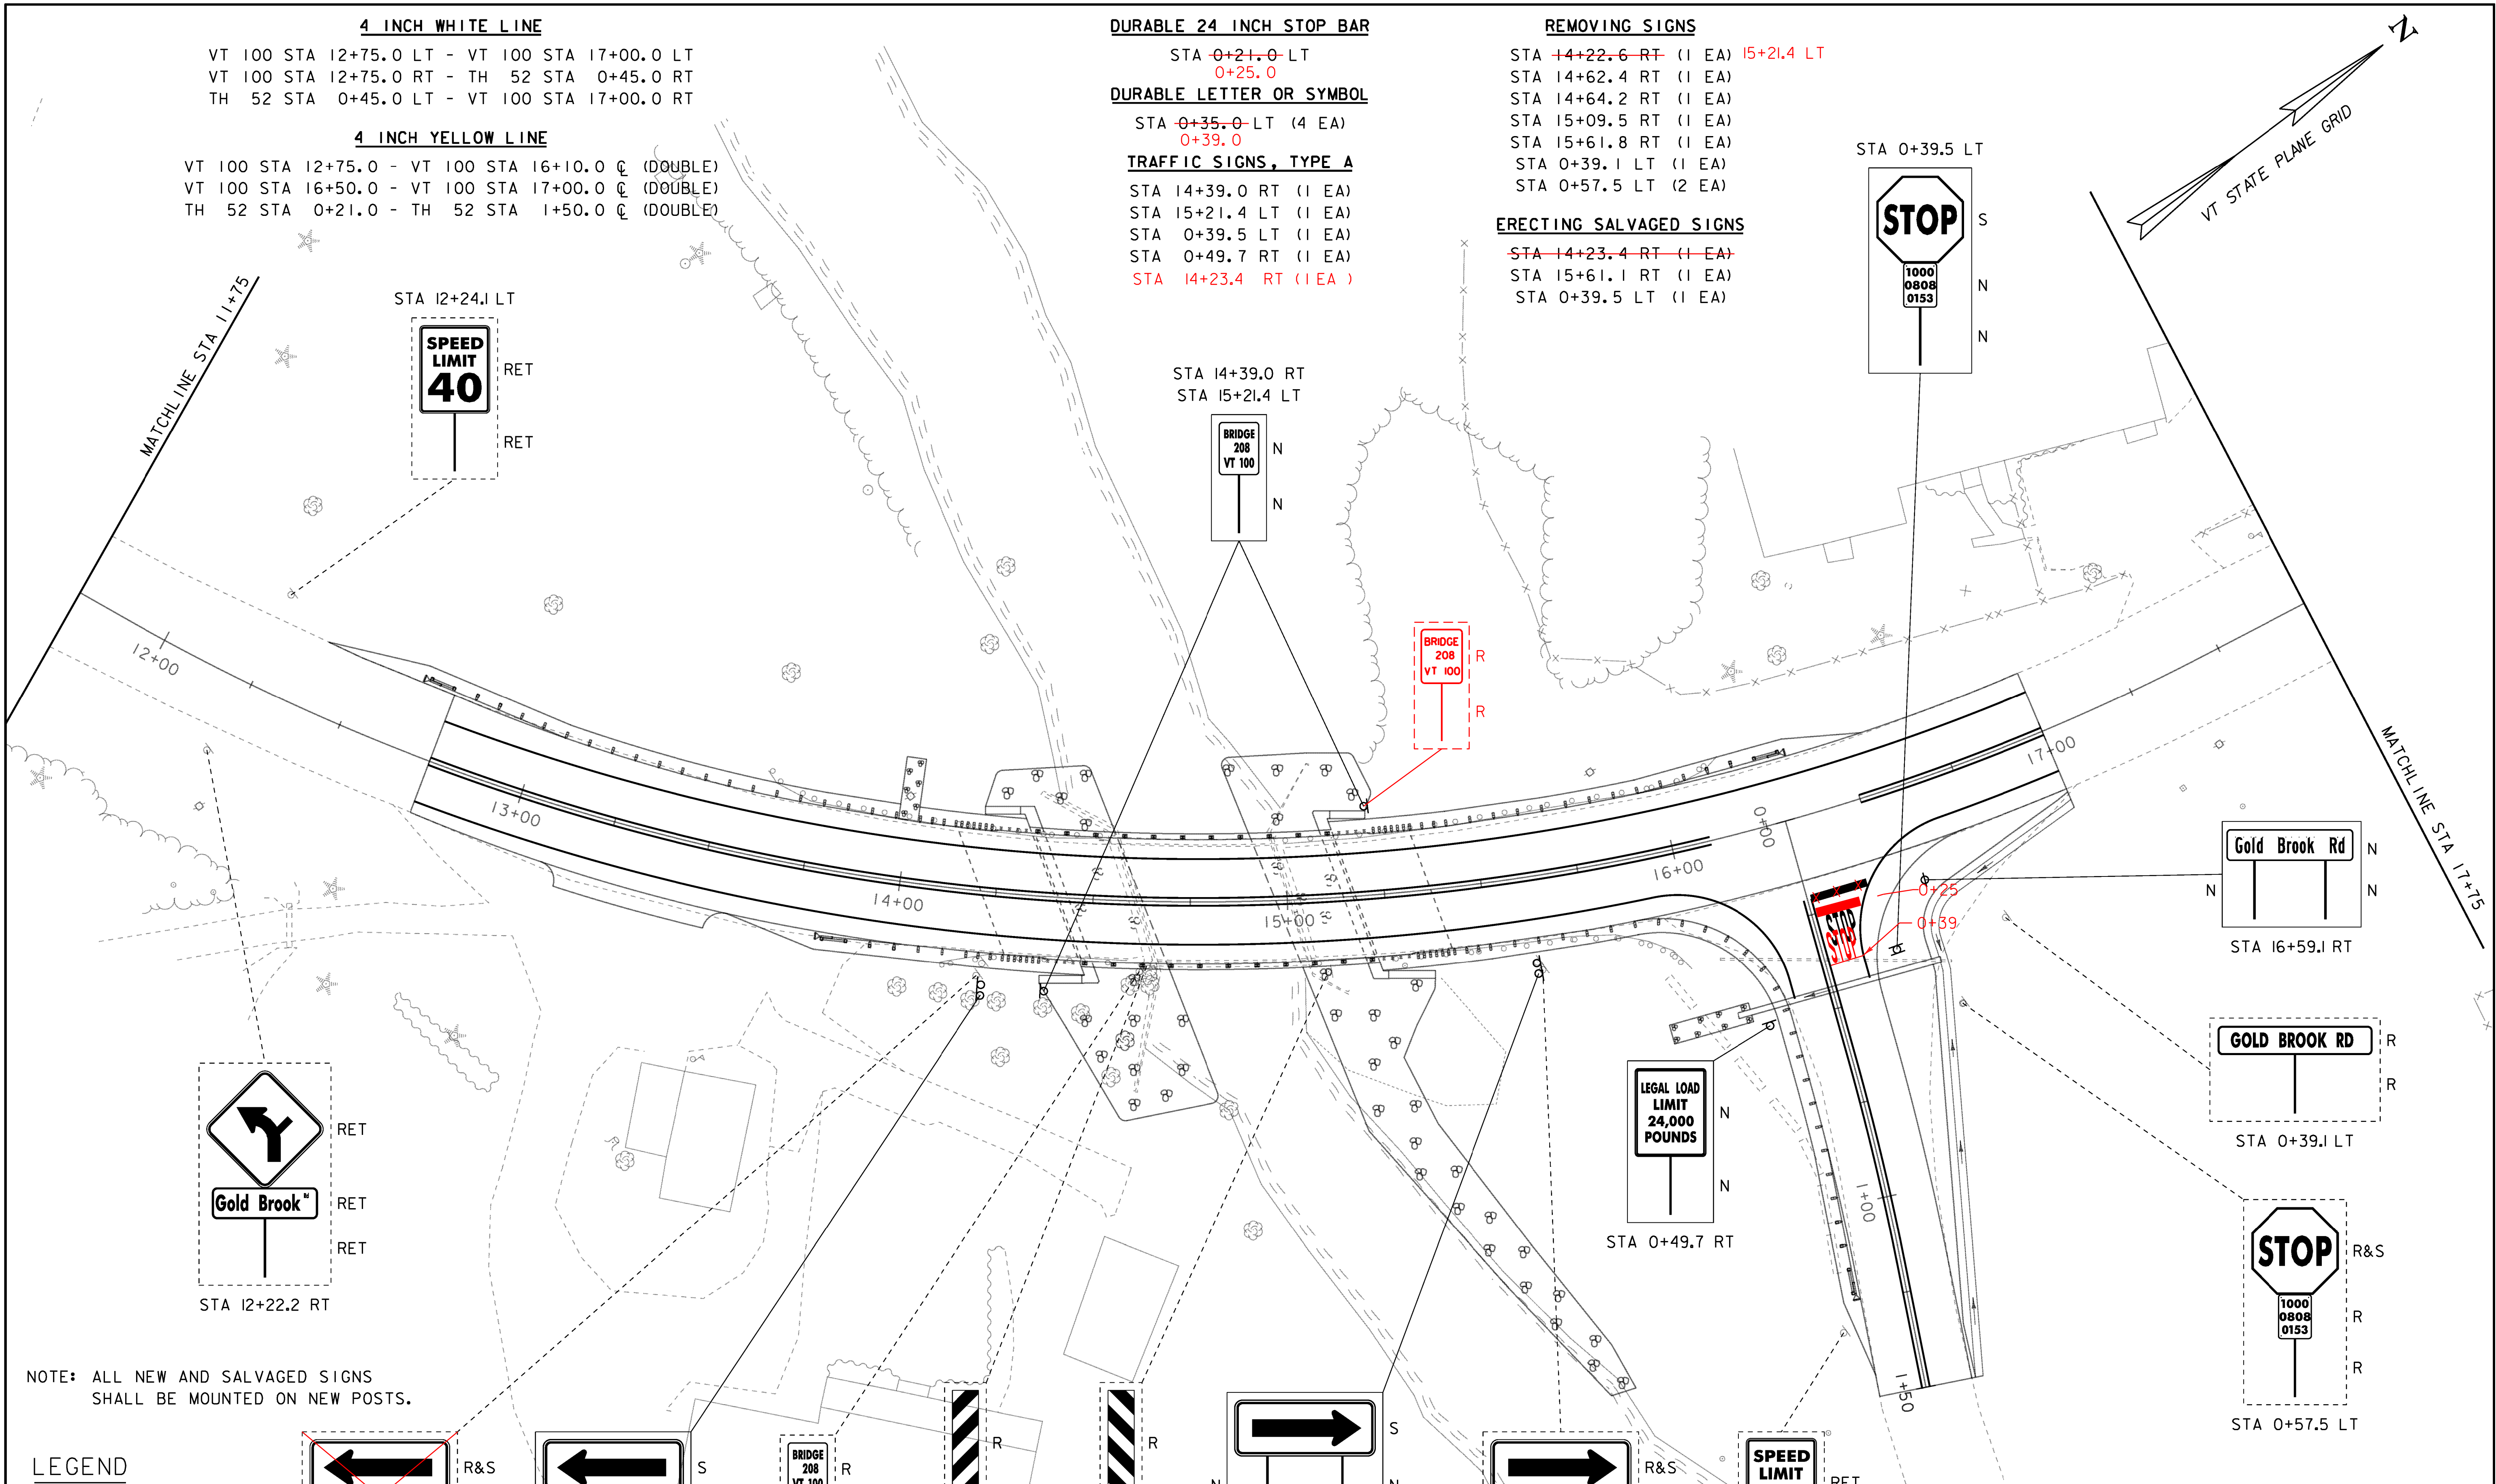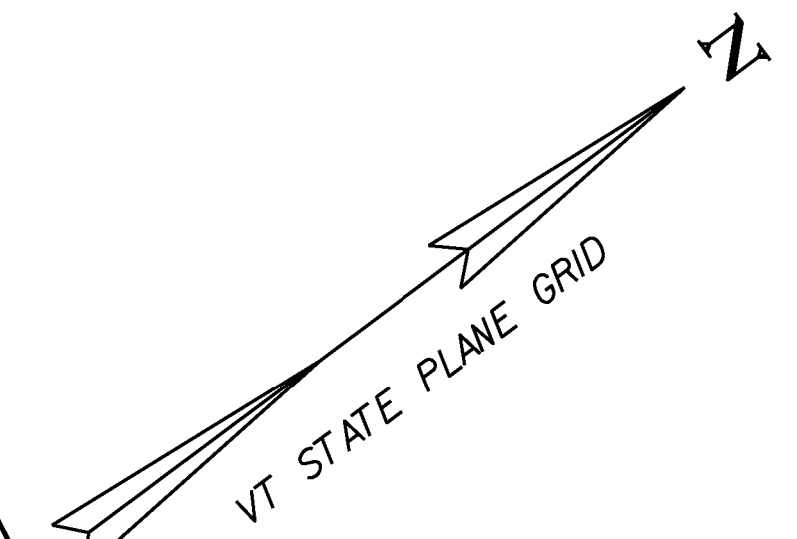

NOTE: ALL NEW AND SALVAGED SIGNS SHALL BE MOUNTED ON NEW POSTS.

LEGEND

RET: RETAIN
 N: NEW
 R: REMOVE
 R&S: REMOVE AND SALVAGE
 S: SALVAGE SIGN

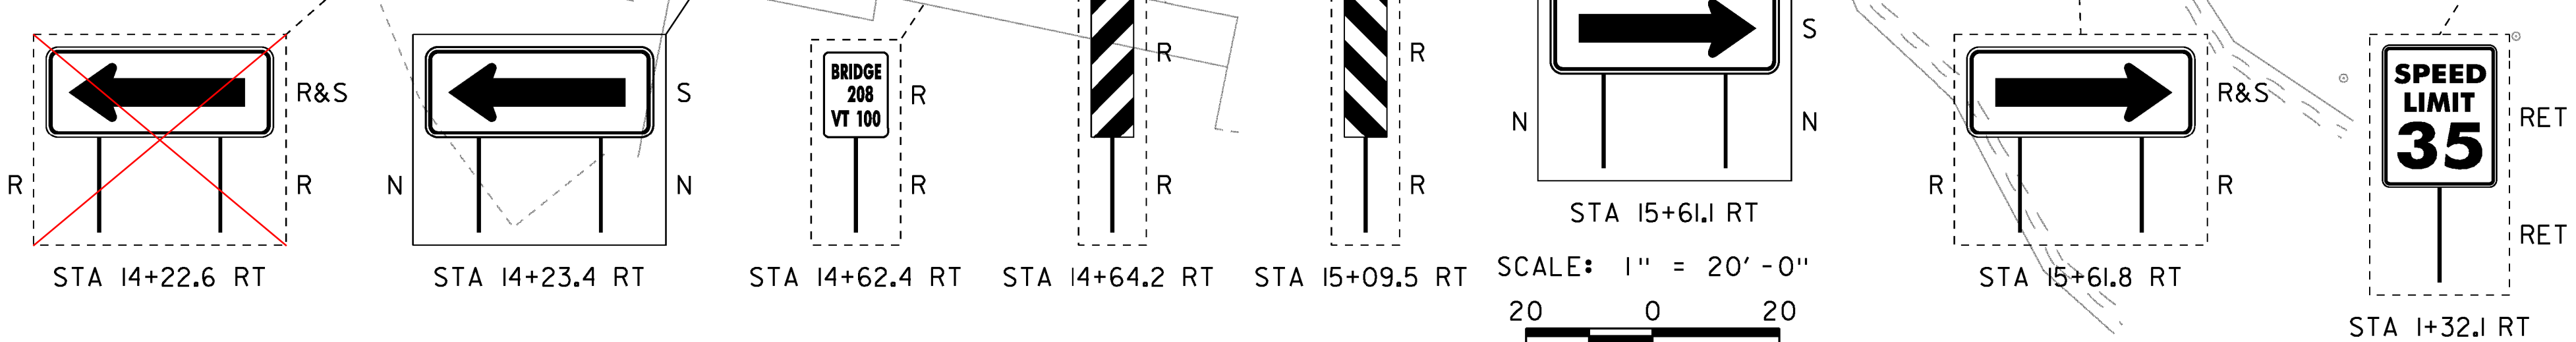

SCALE: 1" = 20' - 0"
 20 0 20

PROJECT NAME: STOWE
 PROJECT NUMBER: BRF 029-1(17)
 FILE NAME: s85e037sign.dgn PLOT DATE: 17-JUN-2013
 PROJECT LEADER: C. CARLSON DRAWN BY: R. PELLETT
 DESIGNED BY: H. SALLS CHECKED BY: G. ROY
 TRAFFIC SIGNS & PAVEMENT MARKINGS 2 SHEET 22 OF 70