


MATCHLINE STA 17+75

18+00 19+00 20+00 20+70

**LEGEND**

- RET: RETAIN
- N: NEW
- R: REMOVE
- R&S: REMOVE AND SALVAGE
- S: SALVAGE SIGN

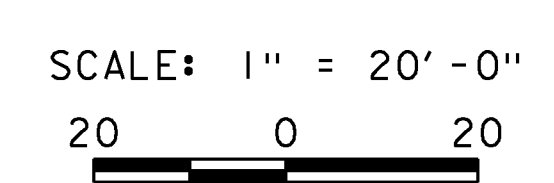

PROJECT NAME: STOWE	
PROJECT NUMBER: BRF 029-1(17)	
FILE NAME: s85e037sign.dgn	PLOT DATE: 17-JUN-2013
PROJECT LEADER: C. CARLSON	DRAWN BY: R. PELLETT
DESIGNED BY: H. SALLS	CHECKED BY: EVANS-MONGEON
TRAFFIC SIGNS & PAVEMENT MARKINGS 3	SHEET 23 OF 70