



ABUTMENT NO. 2 PLAN

SCALE: 1/4" = 1'-0"

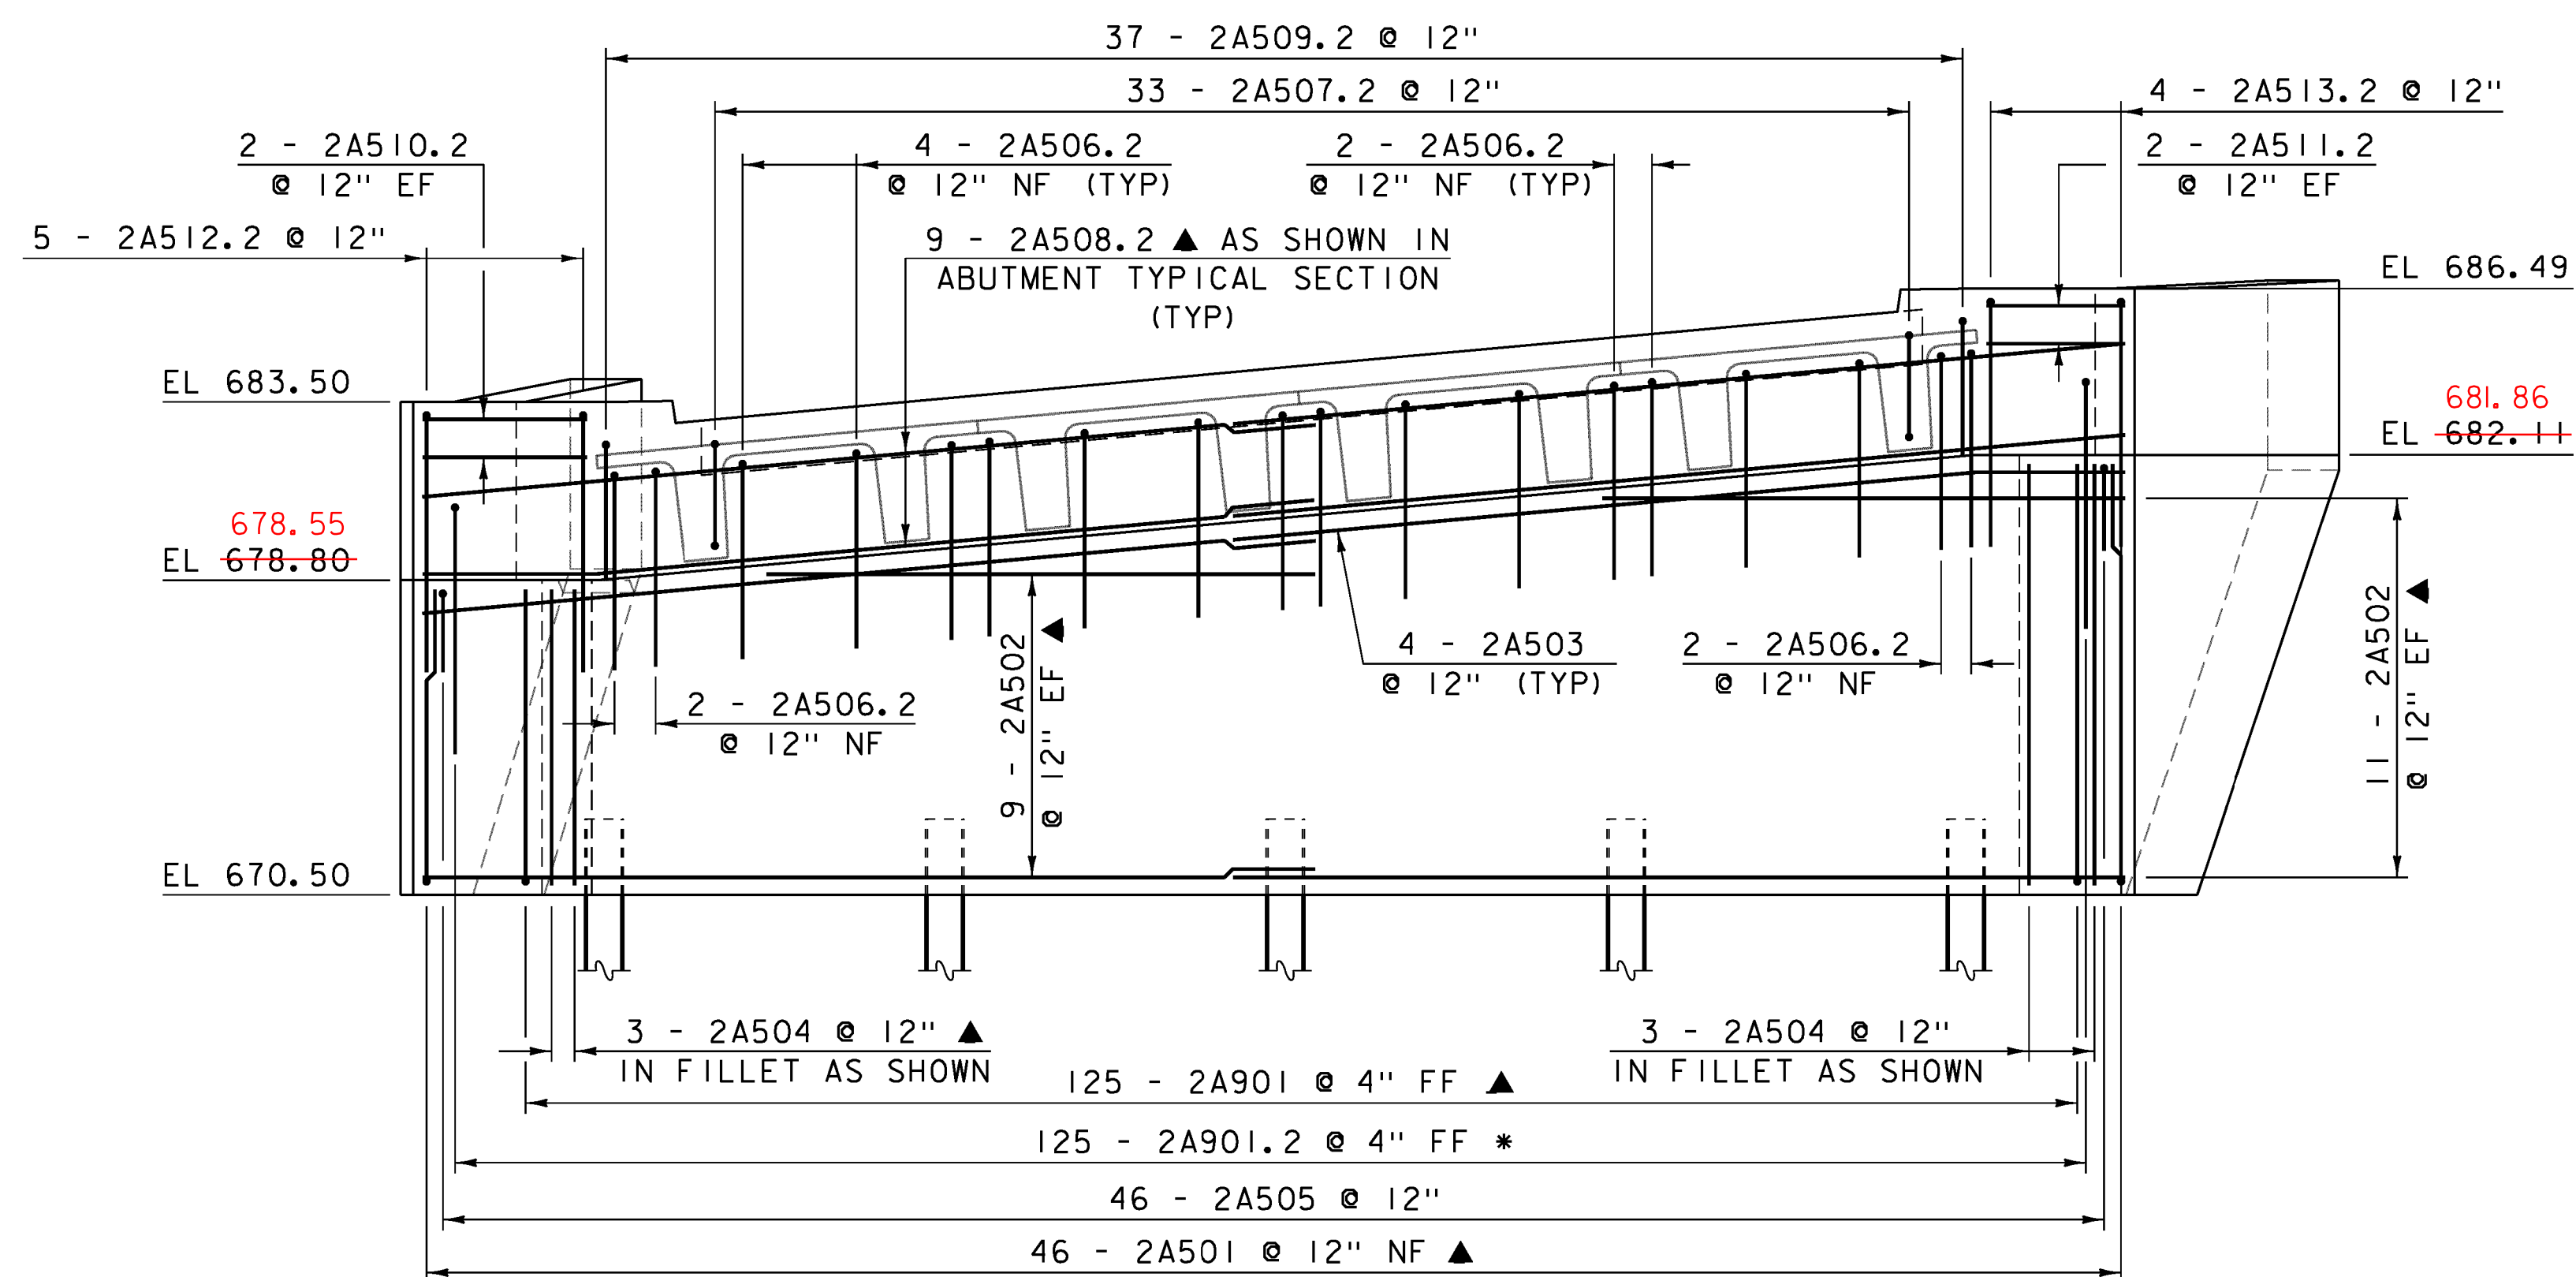


ABUTMENT NO. 2 ELEVATION

SCALE: 1/4" = 1'-0"

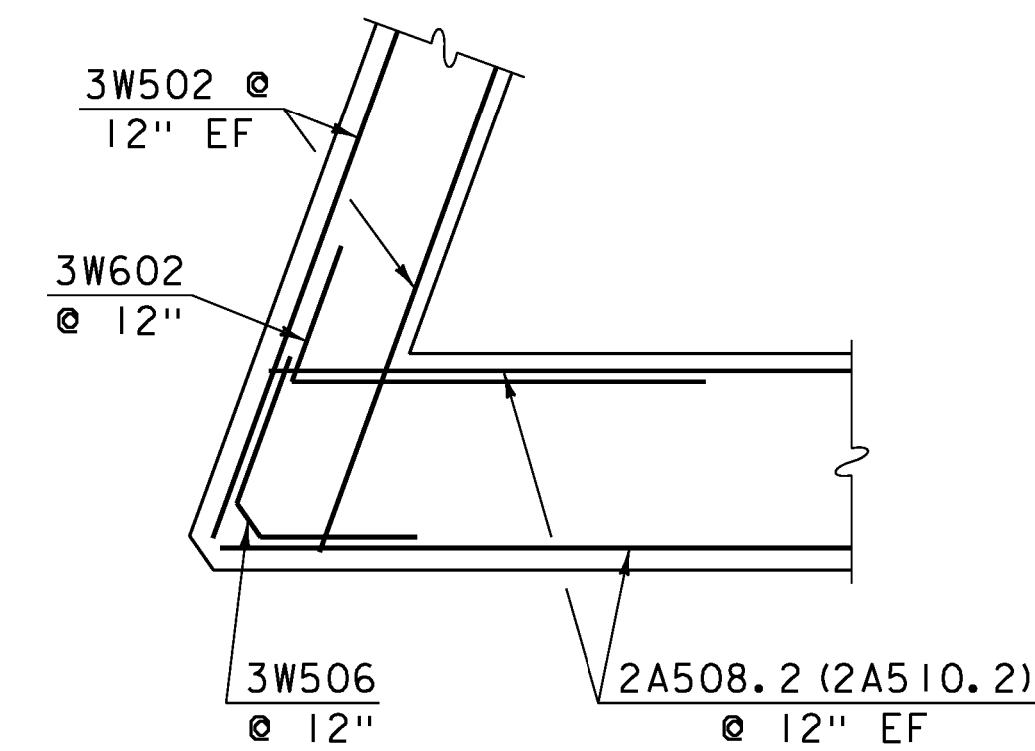


WINGWALL NO. 3 CORNER REINFORCING ABOVE CONSTRUCTION JOINT

SCALE: 3/8" = 1'-0" (WINGWALL 2 SIMILAR)

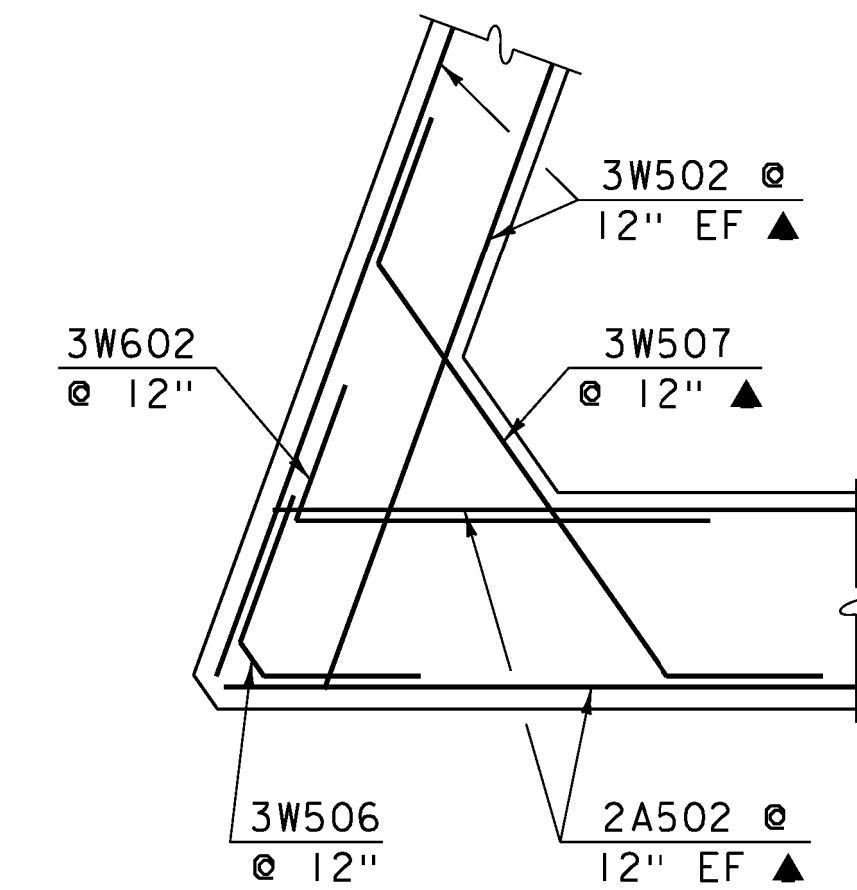


WINGWALL NO. 3 CORNER REINFORCING BELOW CONSTRUCTION JOINT

SCALE: 3/8" = 1'-0" (WINGWALL 2 SIMILAR)

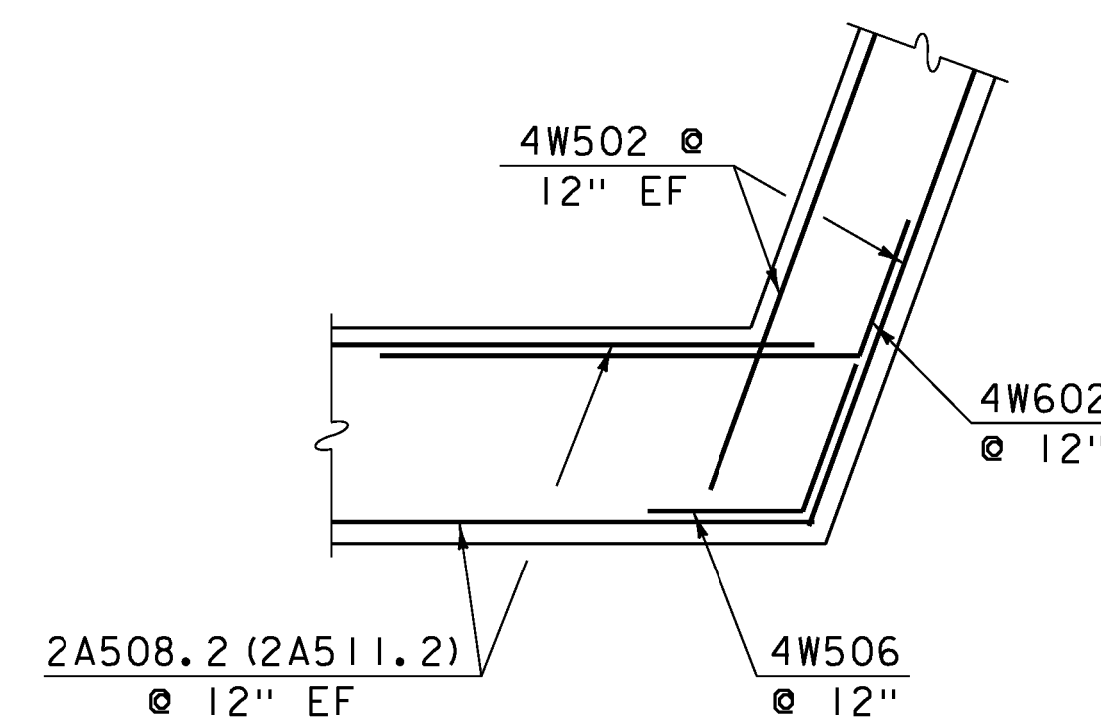

WINGWALL NO. 4 CORNER REINFORCING ABOVE CONSTRUCTION JOINT

SCALE: 3/8" = 1'-0" (WINGWALL 1 SIMILAR)

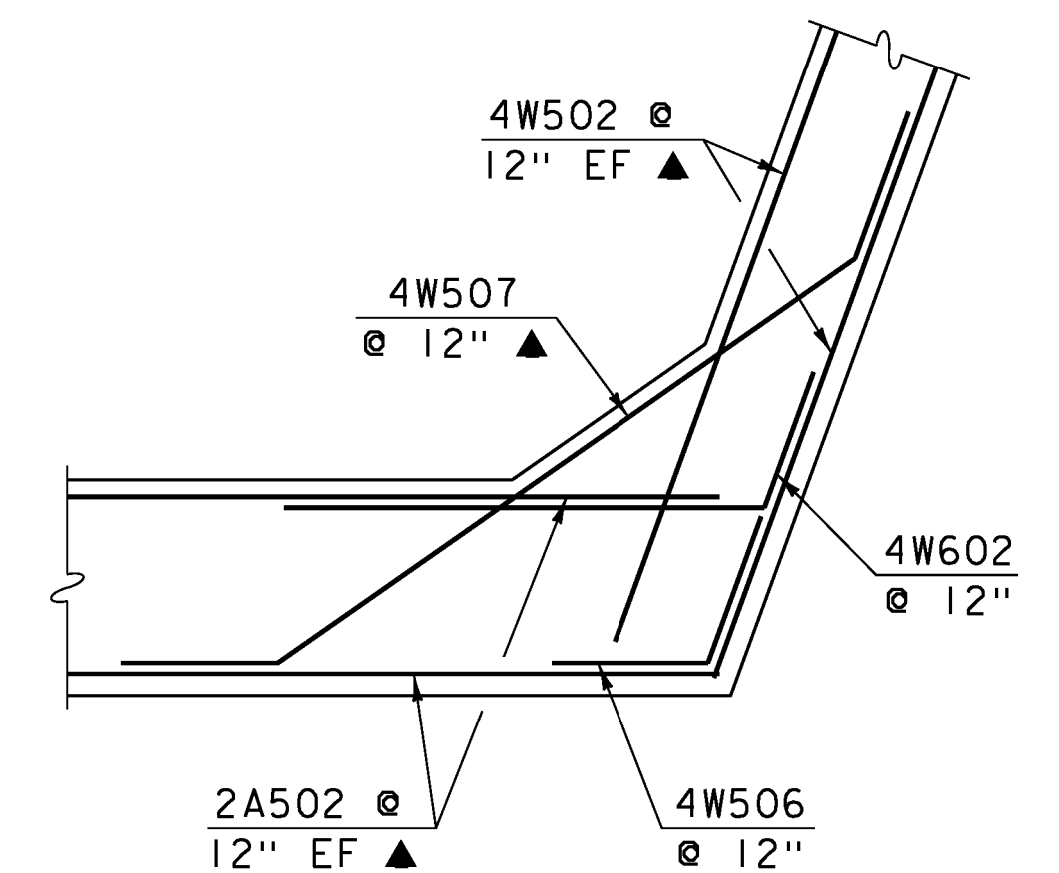

WINGWALL NO. 4 CORNER REINFORCING BELOW CONSTRUCTION JOINT

SCALE: 3/8" = 1'-0" (WINGWALL 1 SIMILAR)

NOTE:

- NF = NEAR FACE
- FF = FAR FACE
- EF = EACH FACE
- ▲ = CUT TO FIT IN FIELD
- 3" CLR. UNLESS OTHERWISE NOTED
- 2'-2" BAR LAP UNLESS OTHERWISE NOTED
- * THE HOOKS WILL NEED TO BE TURNED OR REMOVED WHEN IN CONFLICT WITH THE BEAM STEMS.

BRIDGE SEAT ELEVATIONS LOWERED PER C. CARLSON

PROJECT NAME: STOWE
PROJECT NUMBER: BRF 029-1(17)

FILE NAME: s85e037sub.dgn
PROJECT LEADER: C. CARLSON
DESIGNED BY: H. I. SALLS
ABUTMENT NO. 2 DETAILS

PLOT DATE: 17-JUN-2013
DRAWN BY: G. ROY
CHECKED BY: H. I. SALLS
SHEET 38 OF 70