


ABUTMENT NO. 1 PILE LAYOUT

SCALE: 1/4" = 1'-0"

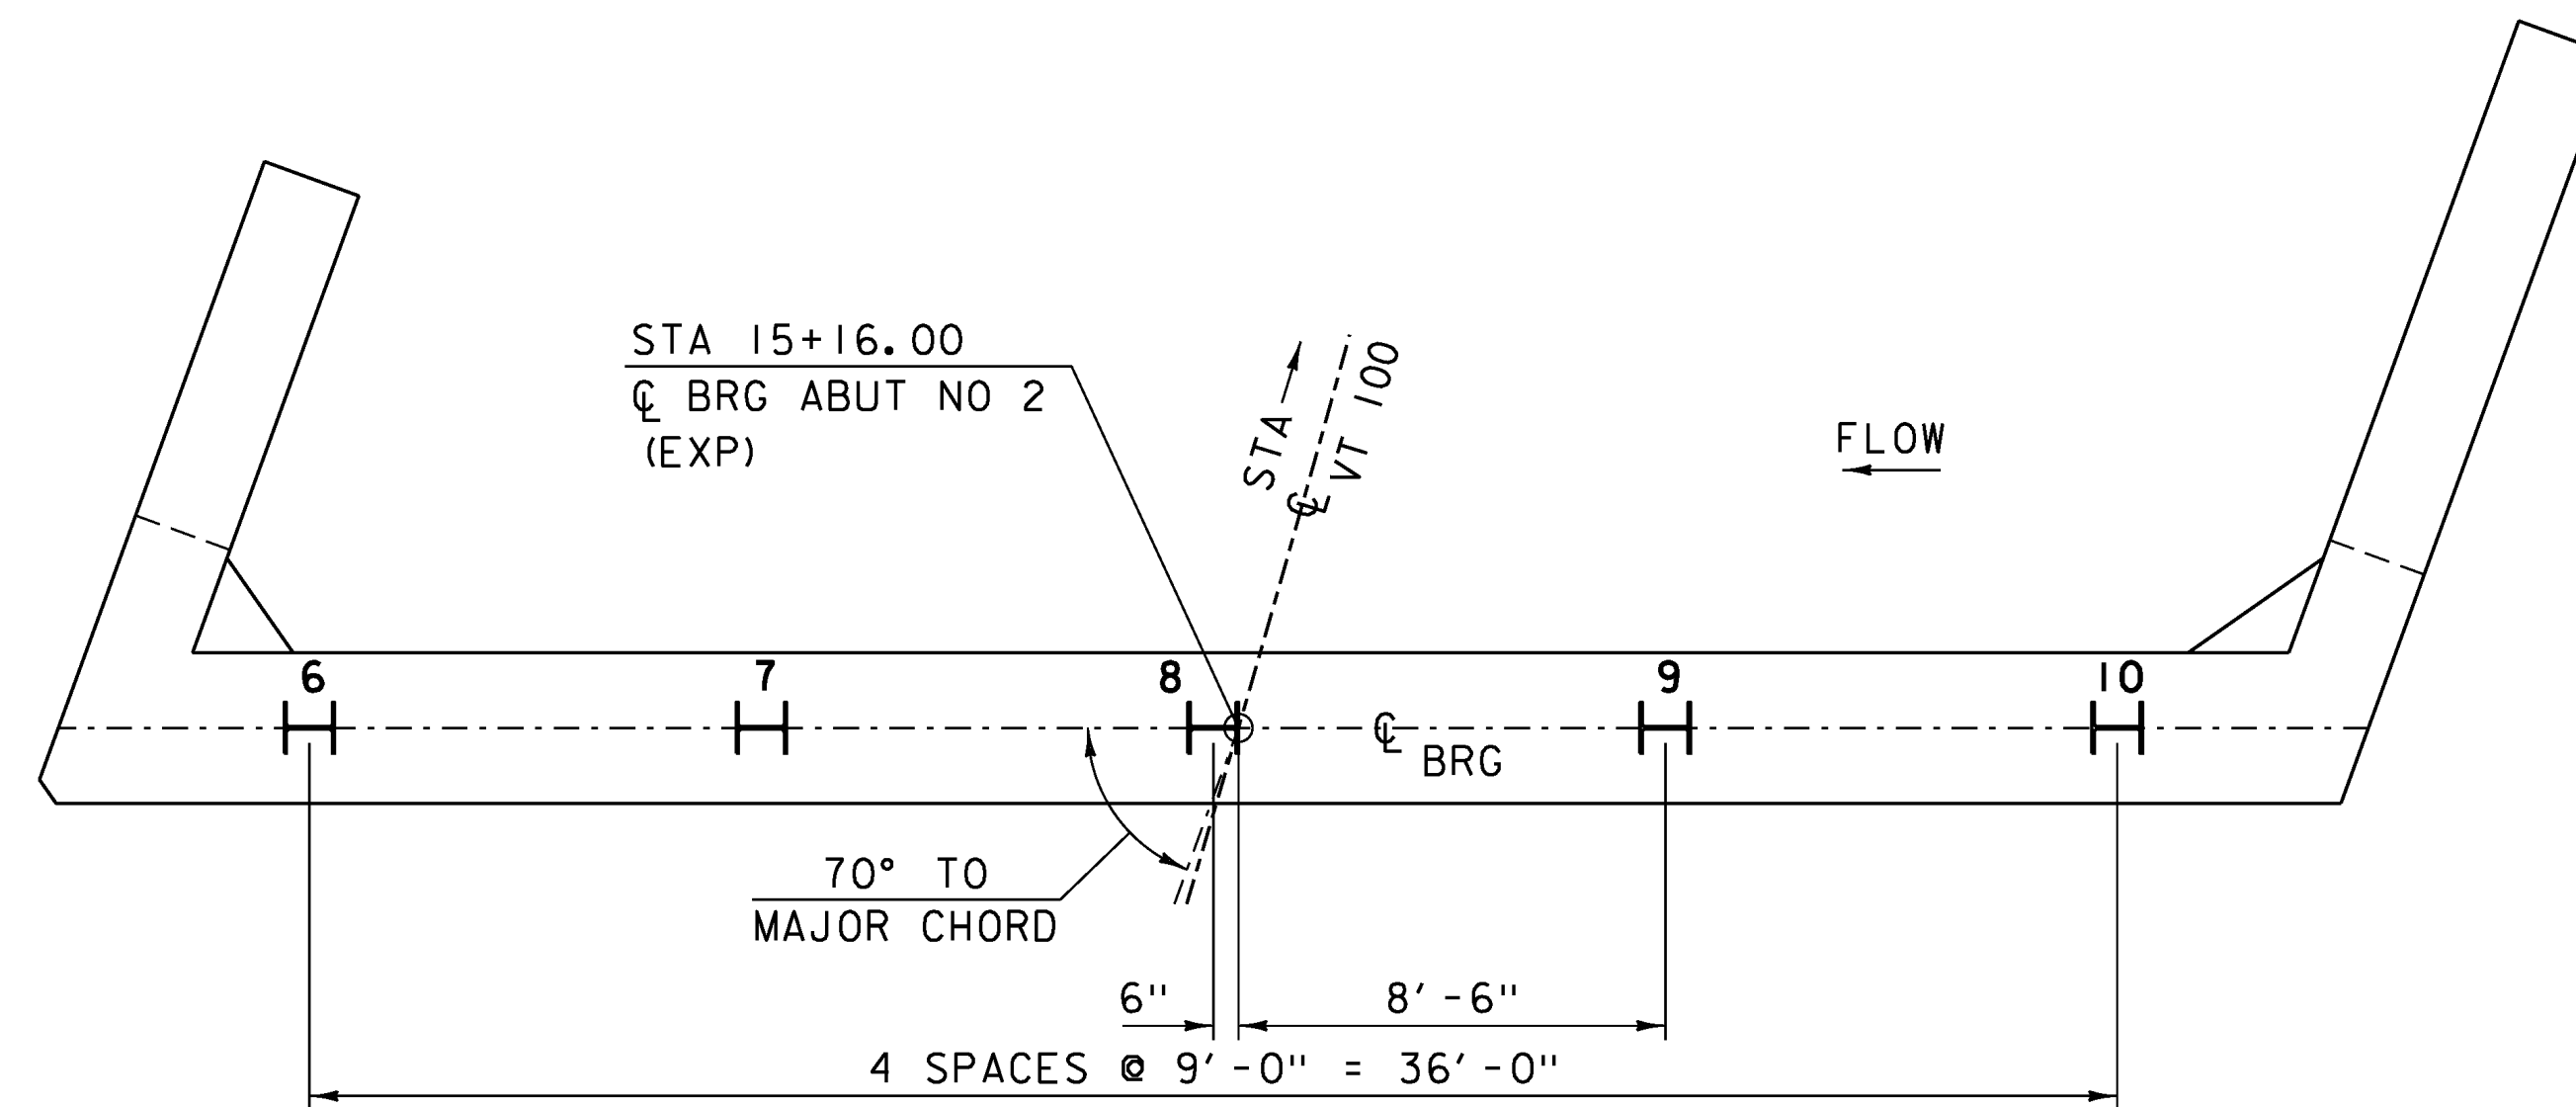

ABUTMENT NO. 2 PILE LAYOUT

SCALE: 1/4" = 1'-0"

NOTE:
SEE STRUCTURES DETAIL SD-601.00
FOR PILE SPLICE DETAIL.

PROJECT NAME: STOWE	PLOT DATE: 17-JUN-2013
PROJECT NUMBER: BRF 029-1(17)	DRAWN BY: G. ROY
FILE NAME: s85e037sub.dgn	CHECKED BY: H. I. SALLS
PROJECT LEADER: C. CARLSON	SHEET 40 OF 70
DESIGNED BY: H. I. SALLS	
PILE LAYOUT	