


BEGIN PROJECT MATERIAL TRANSITION

NOT TO SCALE

END PROJECT MATERIAL TRANSITION

NOT TO SCALE

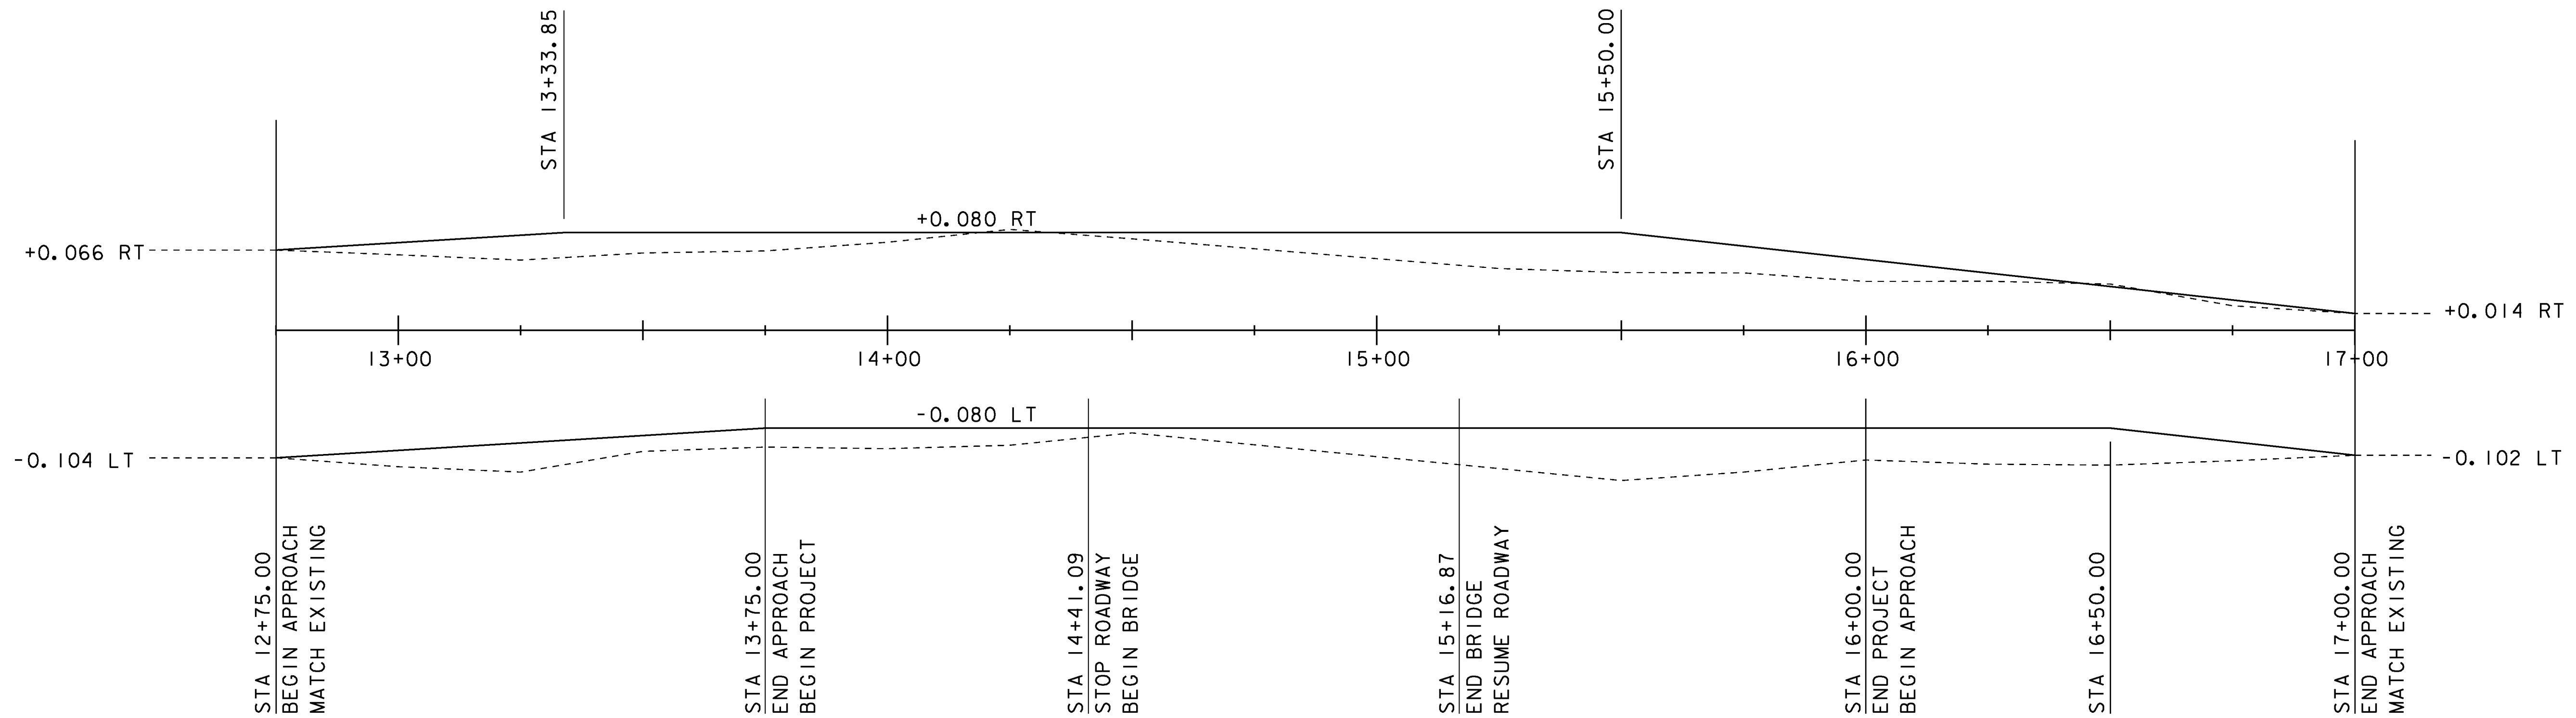

BANKING DIAGRAM

NOT TO SCALE

PROJECT NAME:	STOWE	PLOT DATE:	17-JUN-2013
PROJECT NUMBER:	BRF 029-1(17)	DRAWN BY:	R. PELLETT
FILE NAME:	s85e037pro.dgn	CHECKED BY:	G. ROY
PROJECT LEADER:	C. CARLSON		
DESIGNED BY:	H. SALLS		
BANKING DIAGRAM & MATERIAL TRANSITIONS		SHEET 42 OF 70	