




13+00

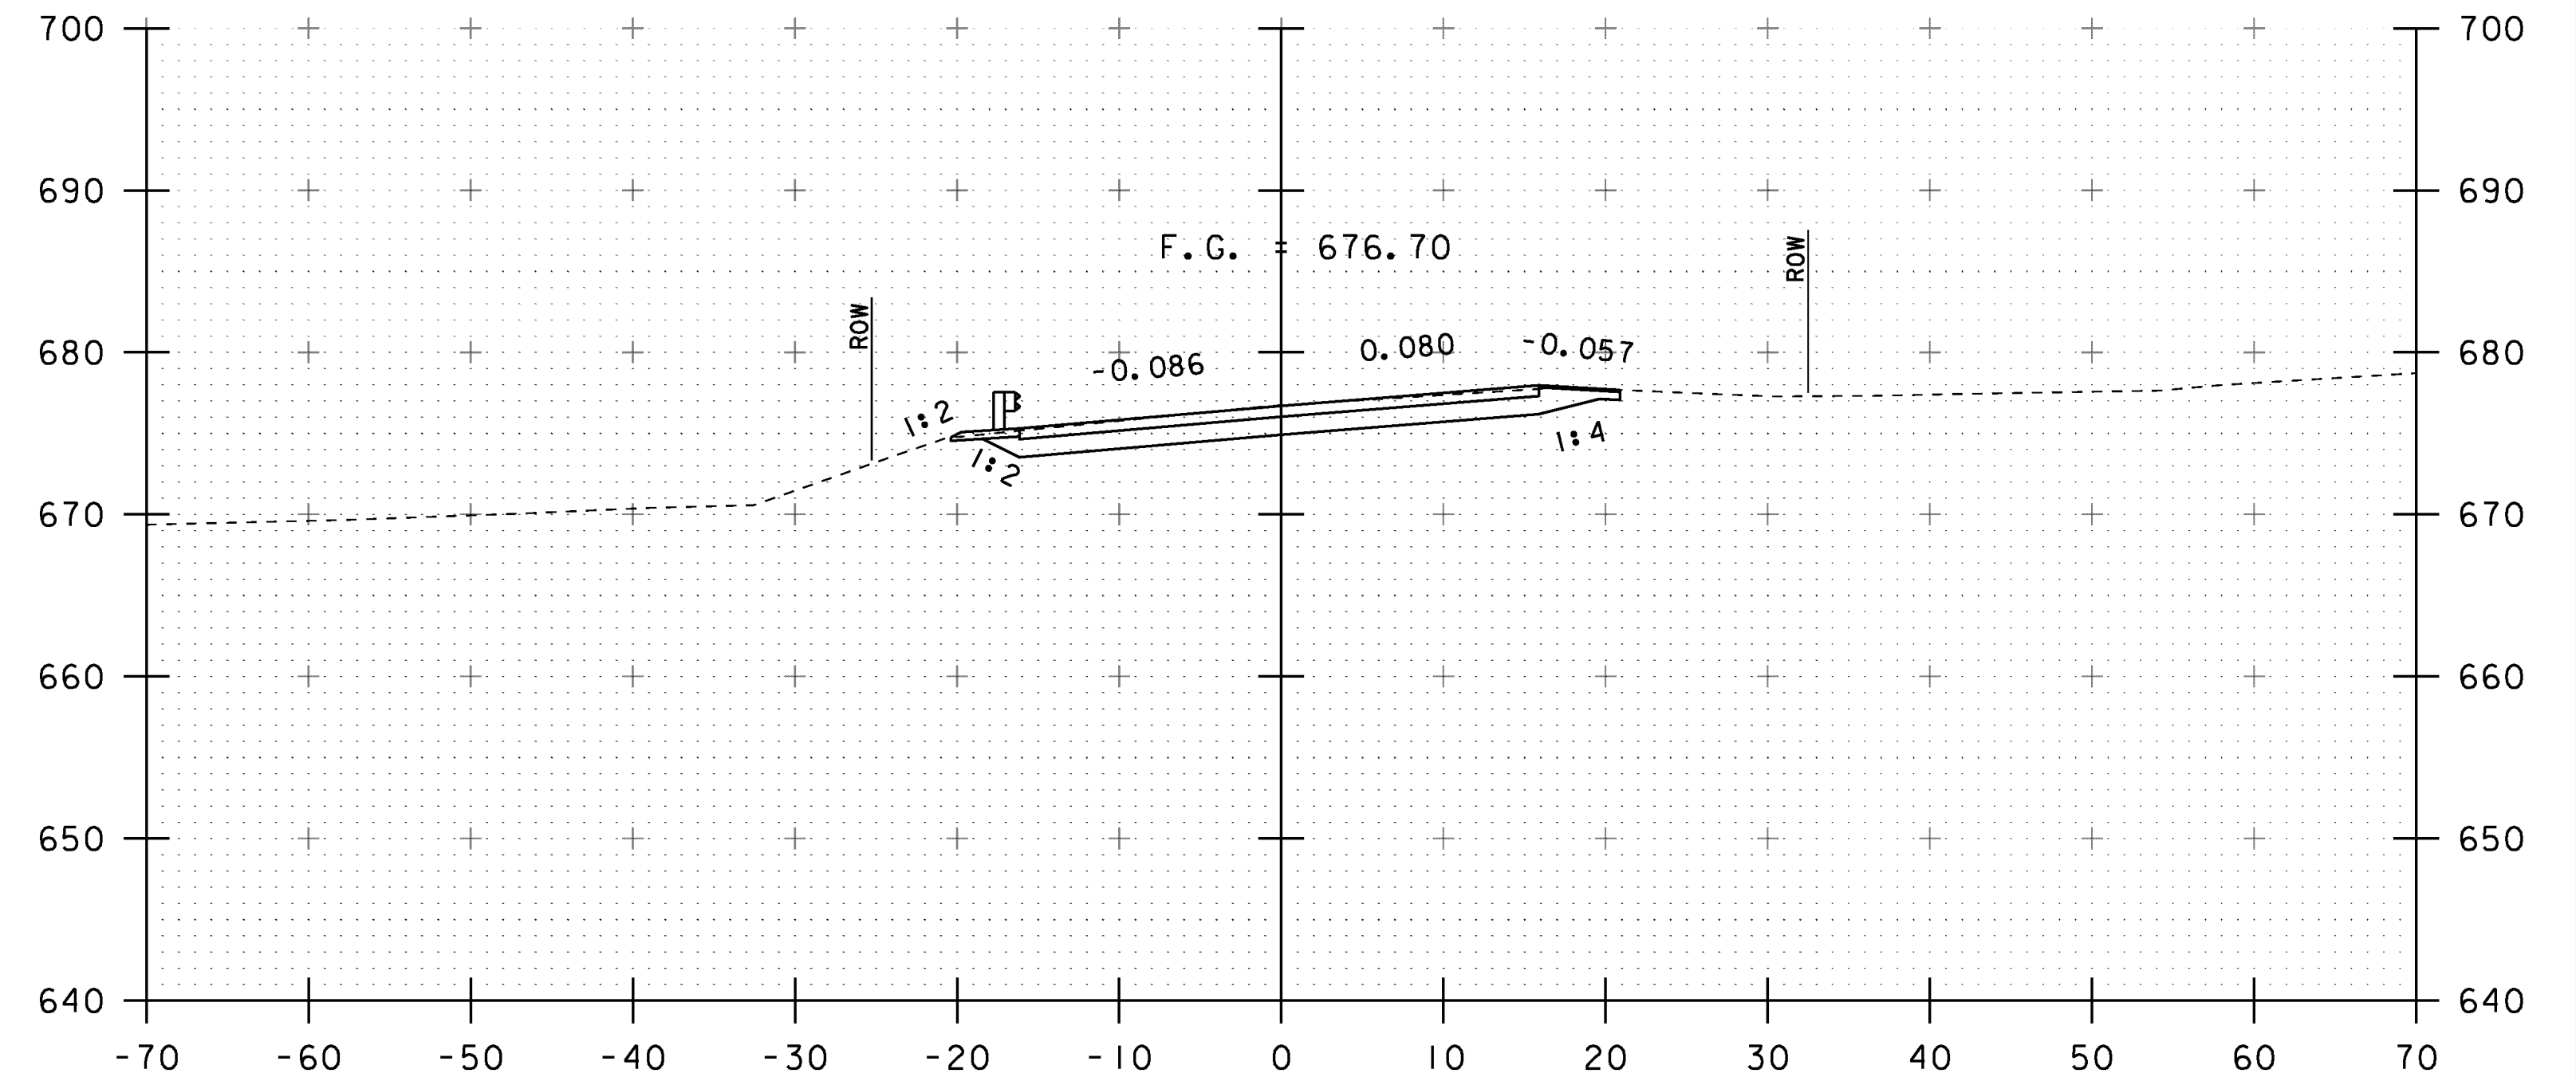

13+50

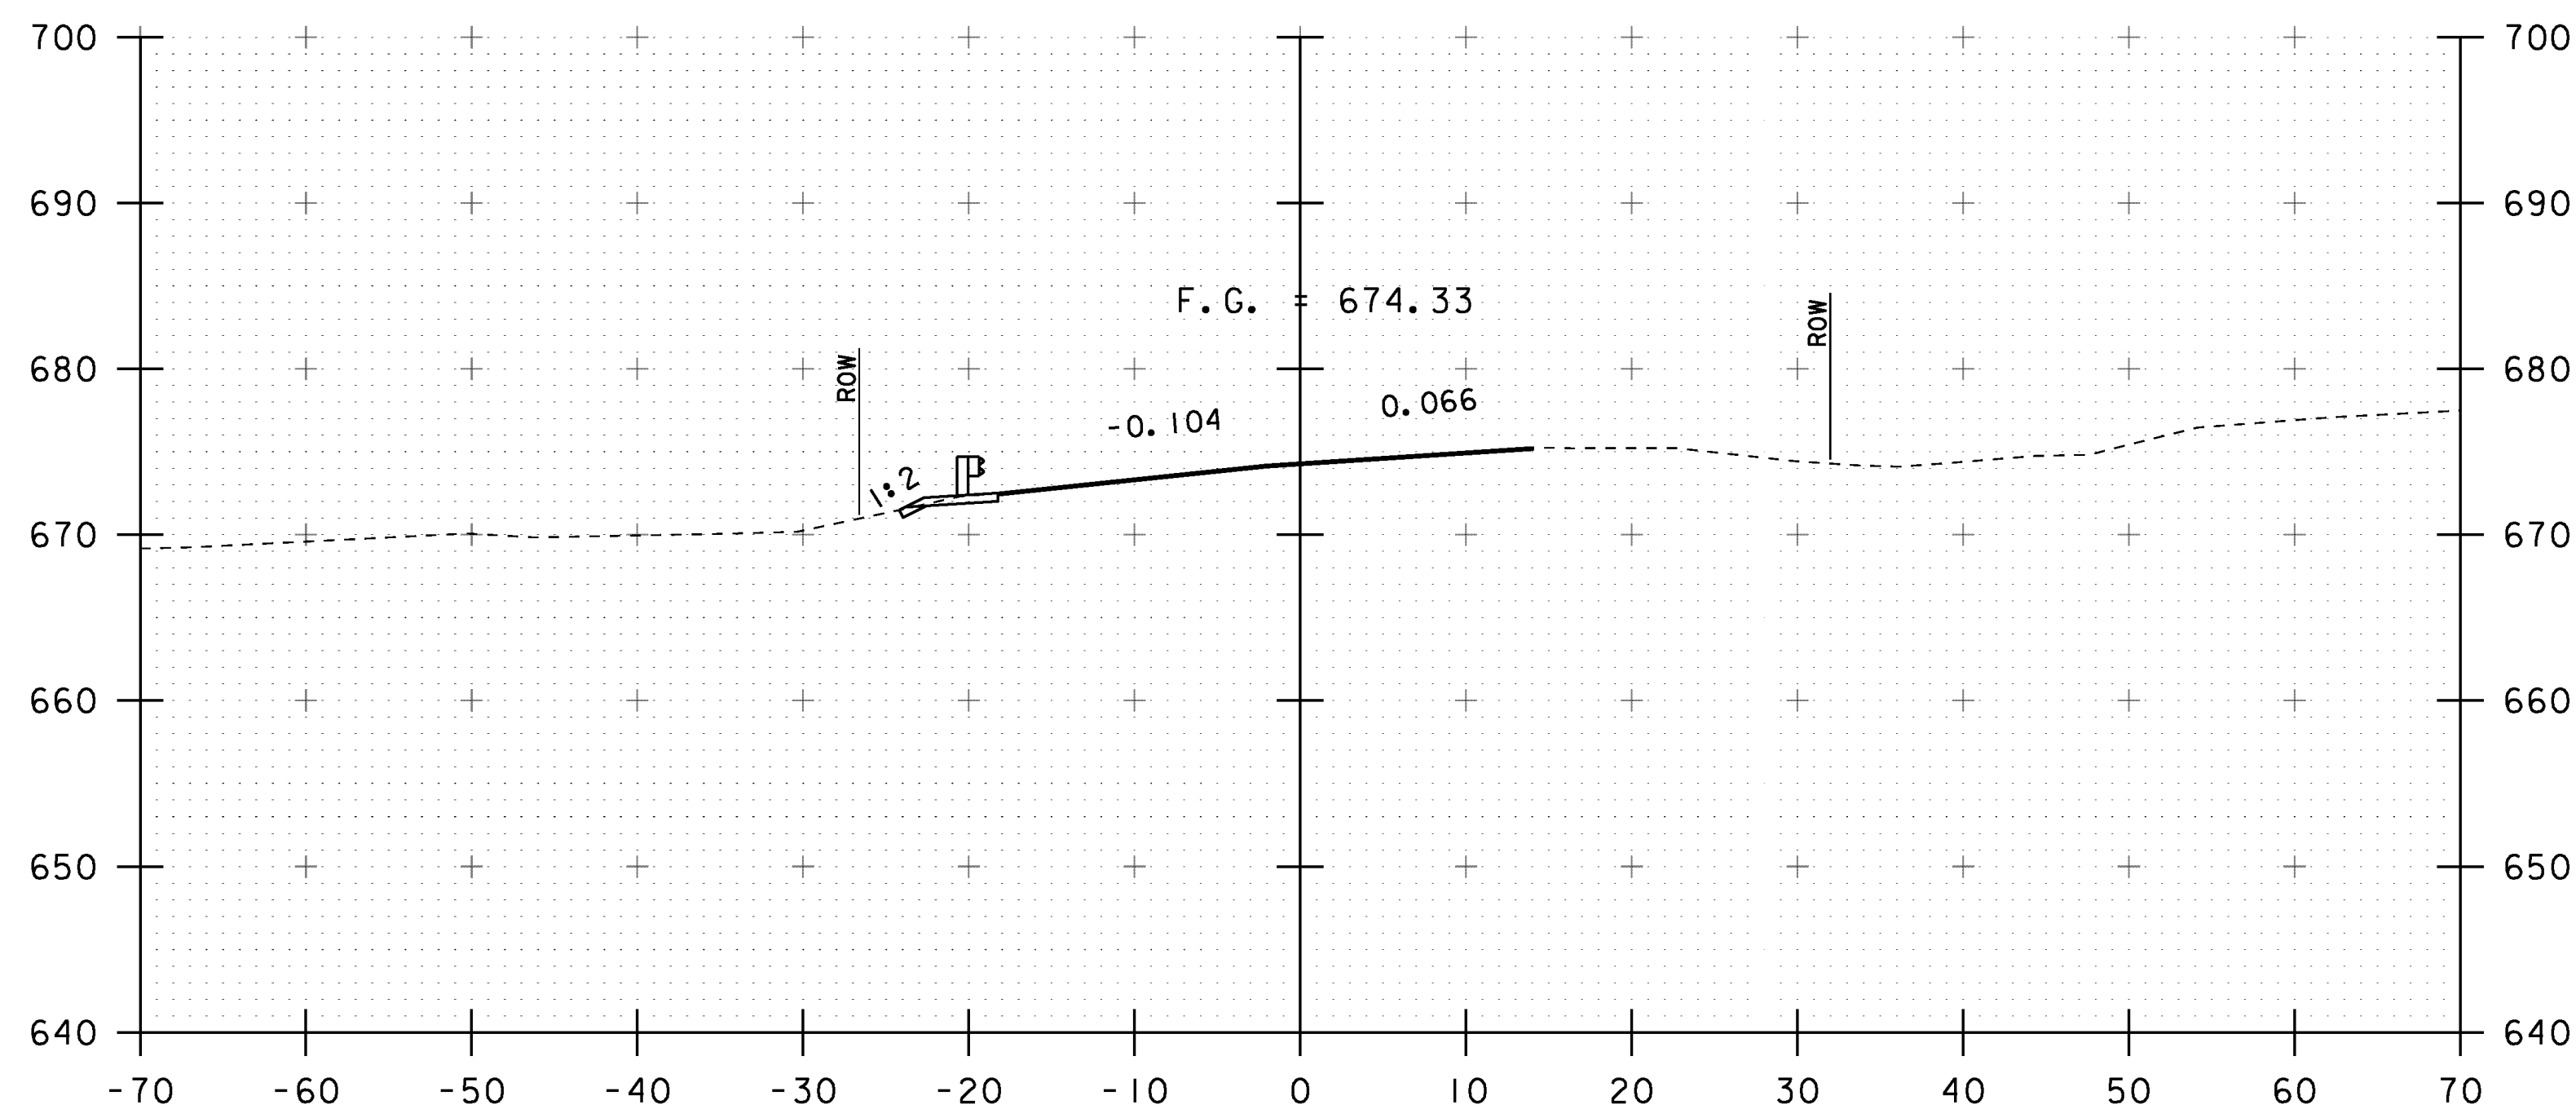

12+75

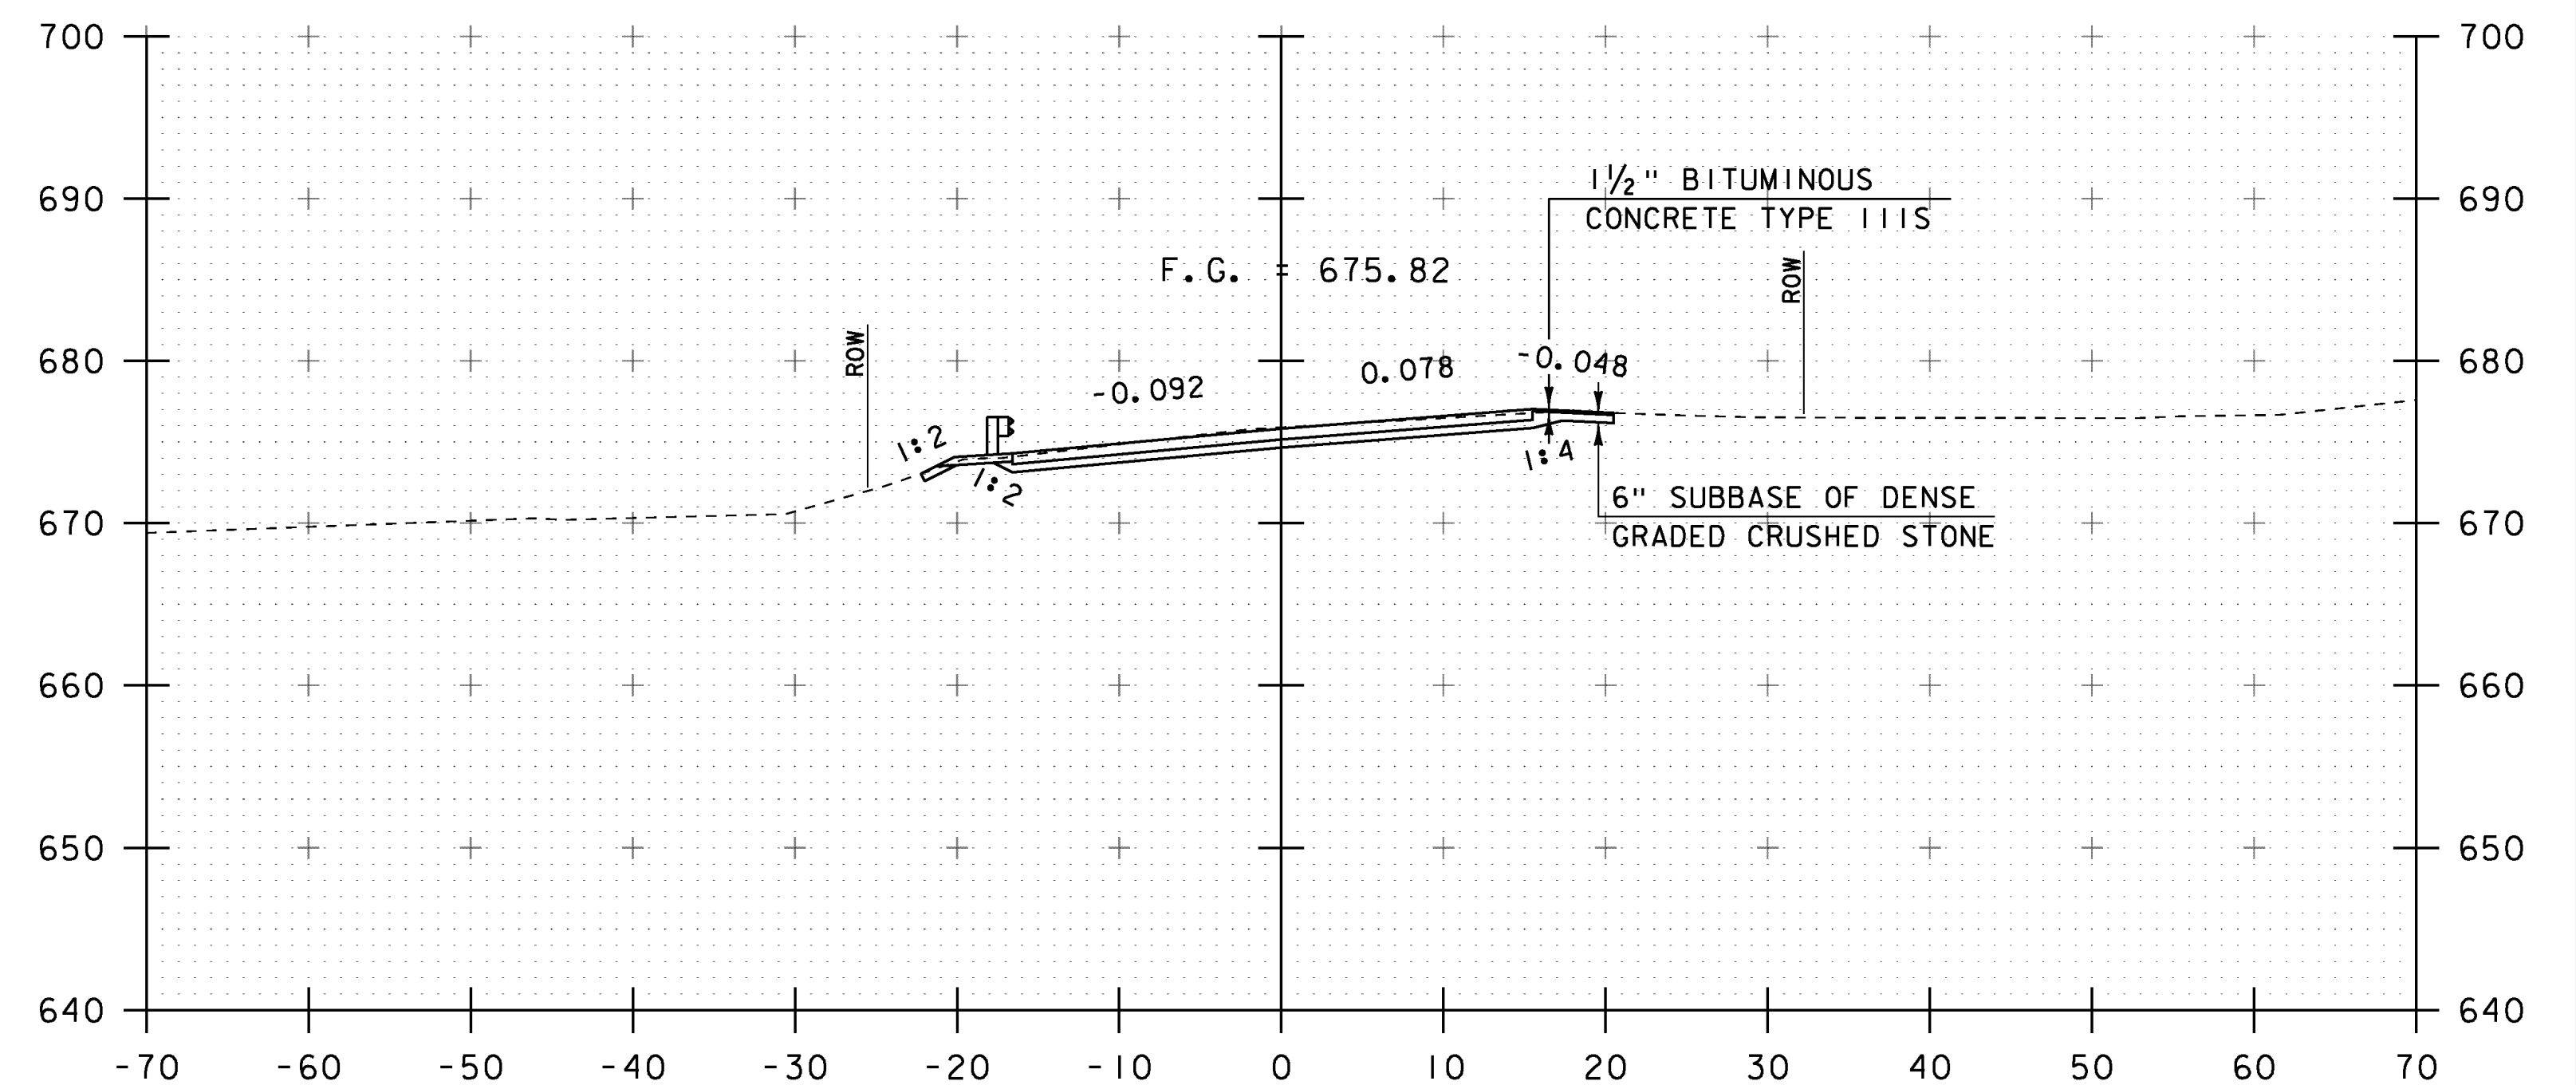

13+25

STA 13+10.0 RT - STA 13+58.0 RT
CONSTRUCT 5' PAVED APRON

STA 12+75.00
BEGIN APPROACH
MATCH EXISTING

SCALE: 1" = 10'-0"
10 0 10
STA. 12+75 TO STA. 13+50

PROJECT NAME: STOWE
PROJECT NUMBER: BRF 029-1(17)

FILE NAME: s85e037xsl.dgn
PROJECT LEADER: C. CARLSON
DESIGNED BY: H. SALLS
MAINLINE CROSS SECTIONS 1

PLOT DATE: 17-JUN-2013
DRAWN BY: R. PELLETT
CHECKED BY: G. ROY
SHEET 43 OF 70