



STA 17+00.00
 END APPROACH
 MATCH EXISTING

17+00

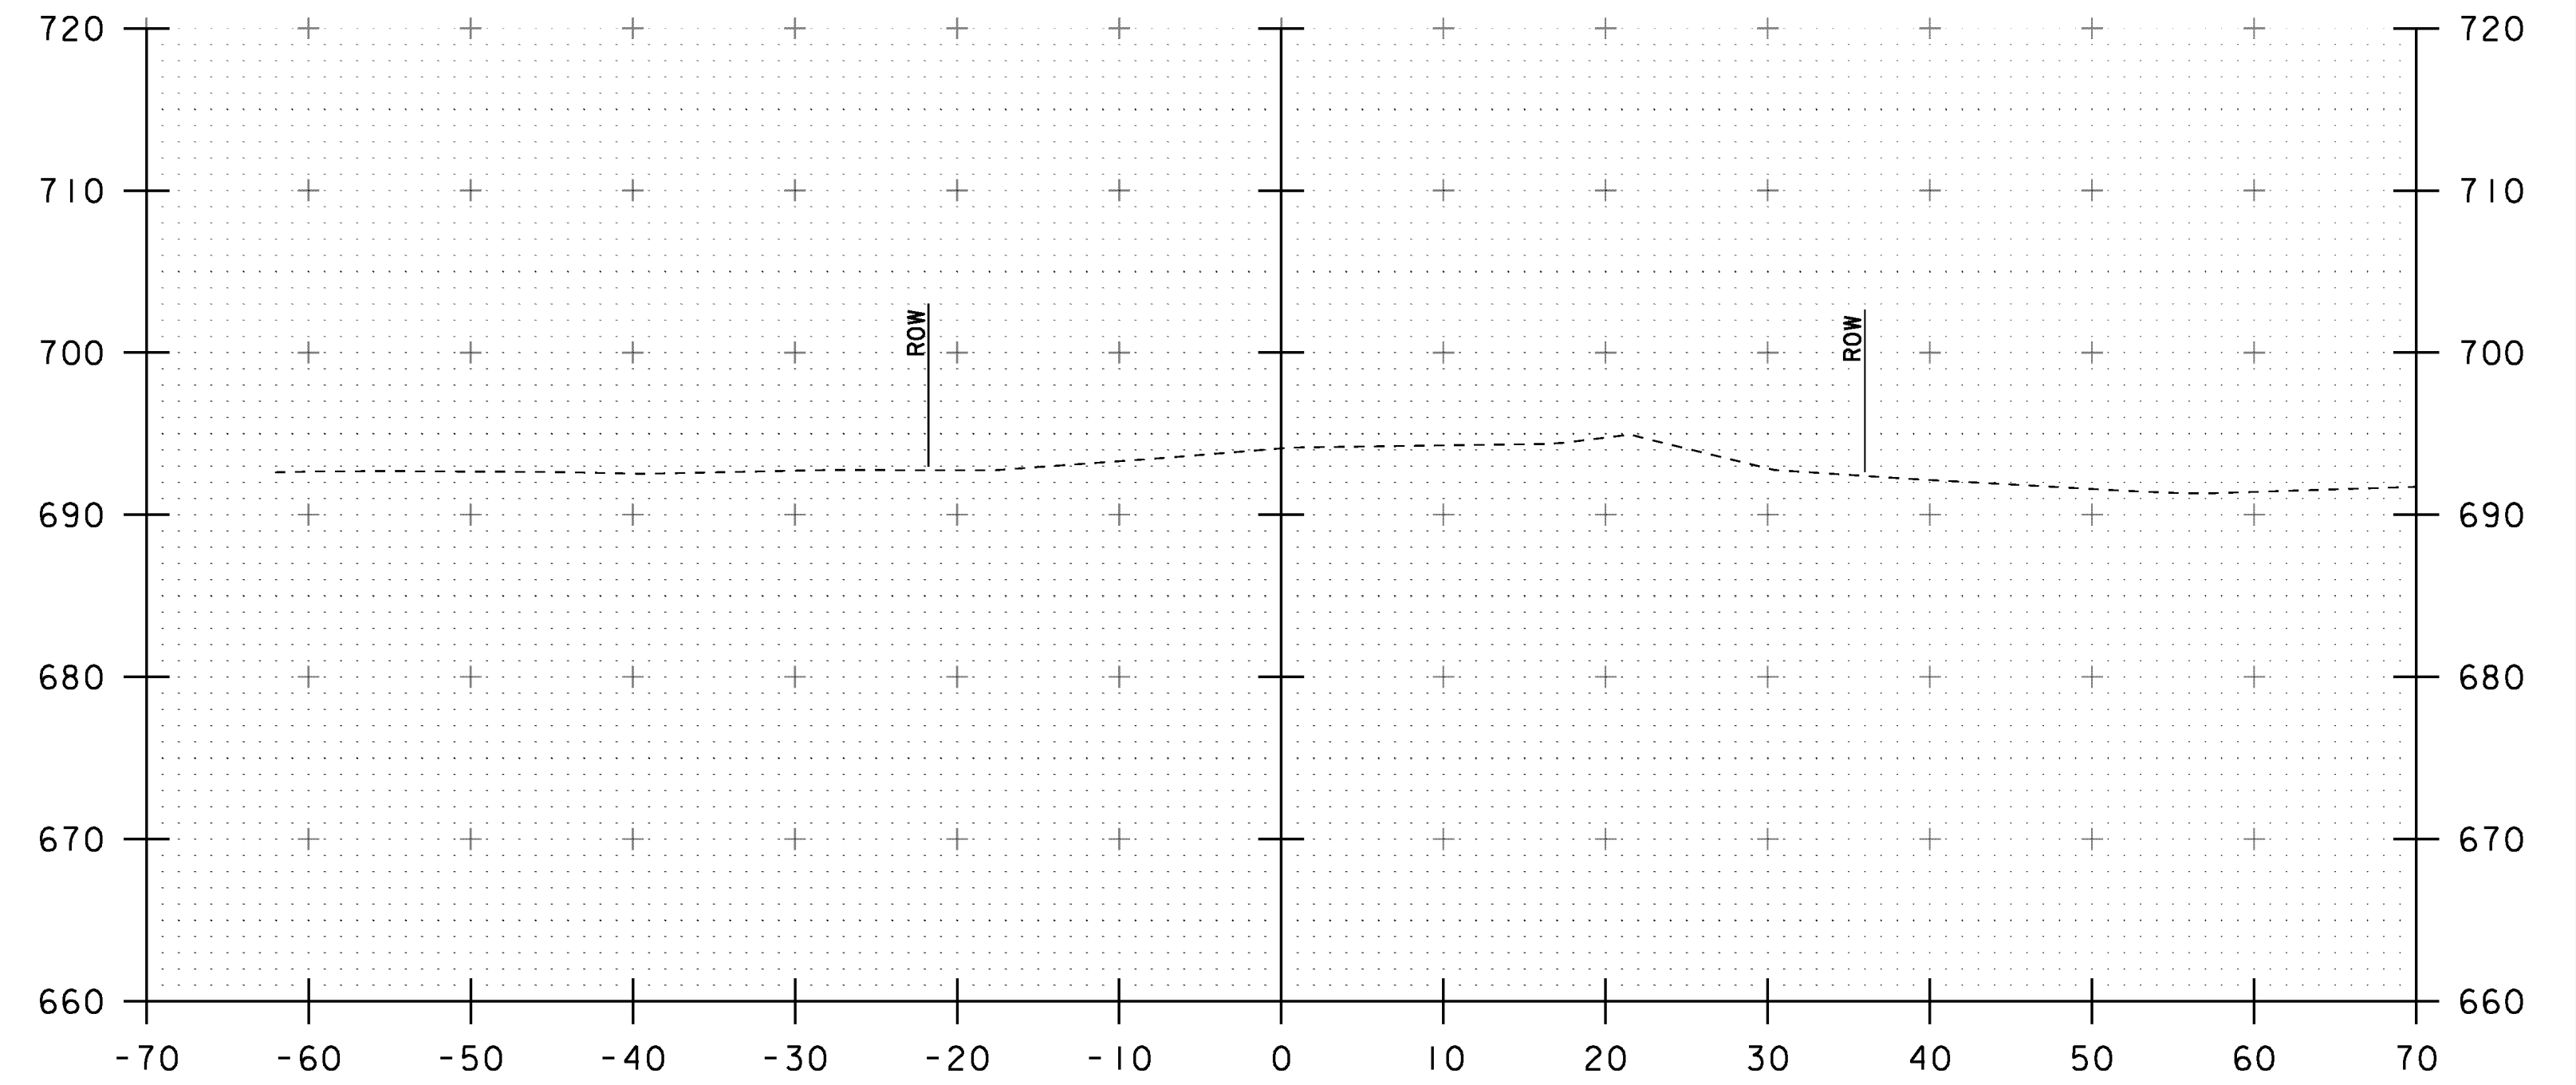


17+50

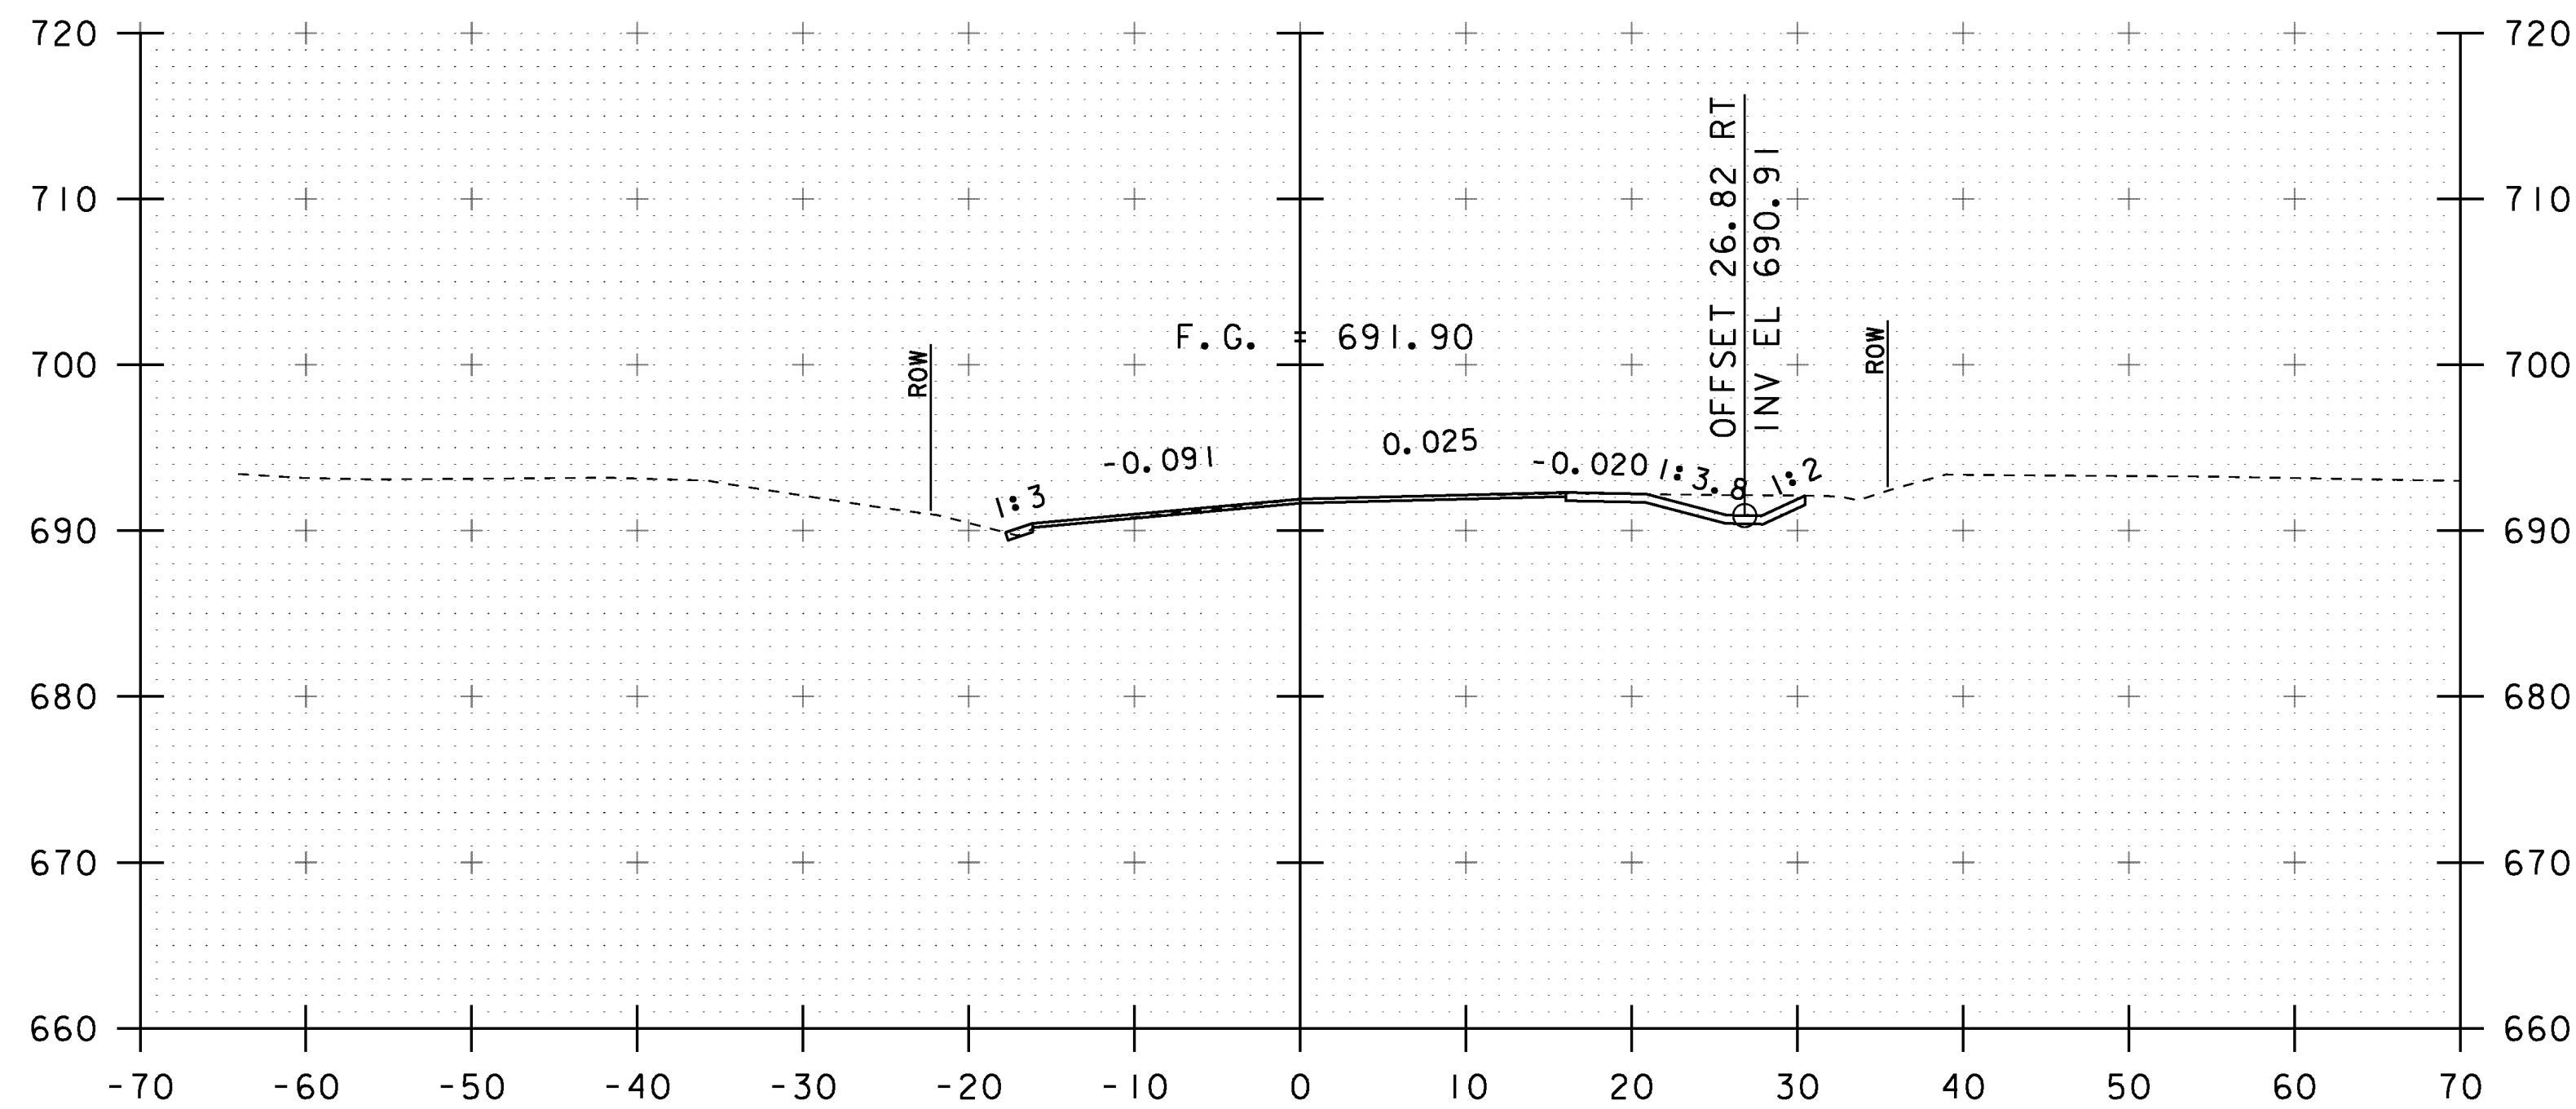


STA 16+54.6 RT - STA 17+00.0 RT
 CONSTRUCT GRASS-LINED DITCH

16+75

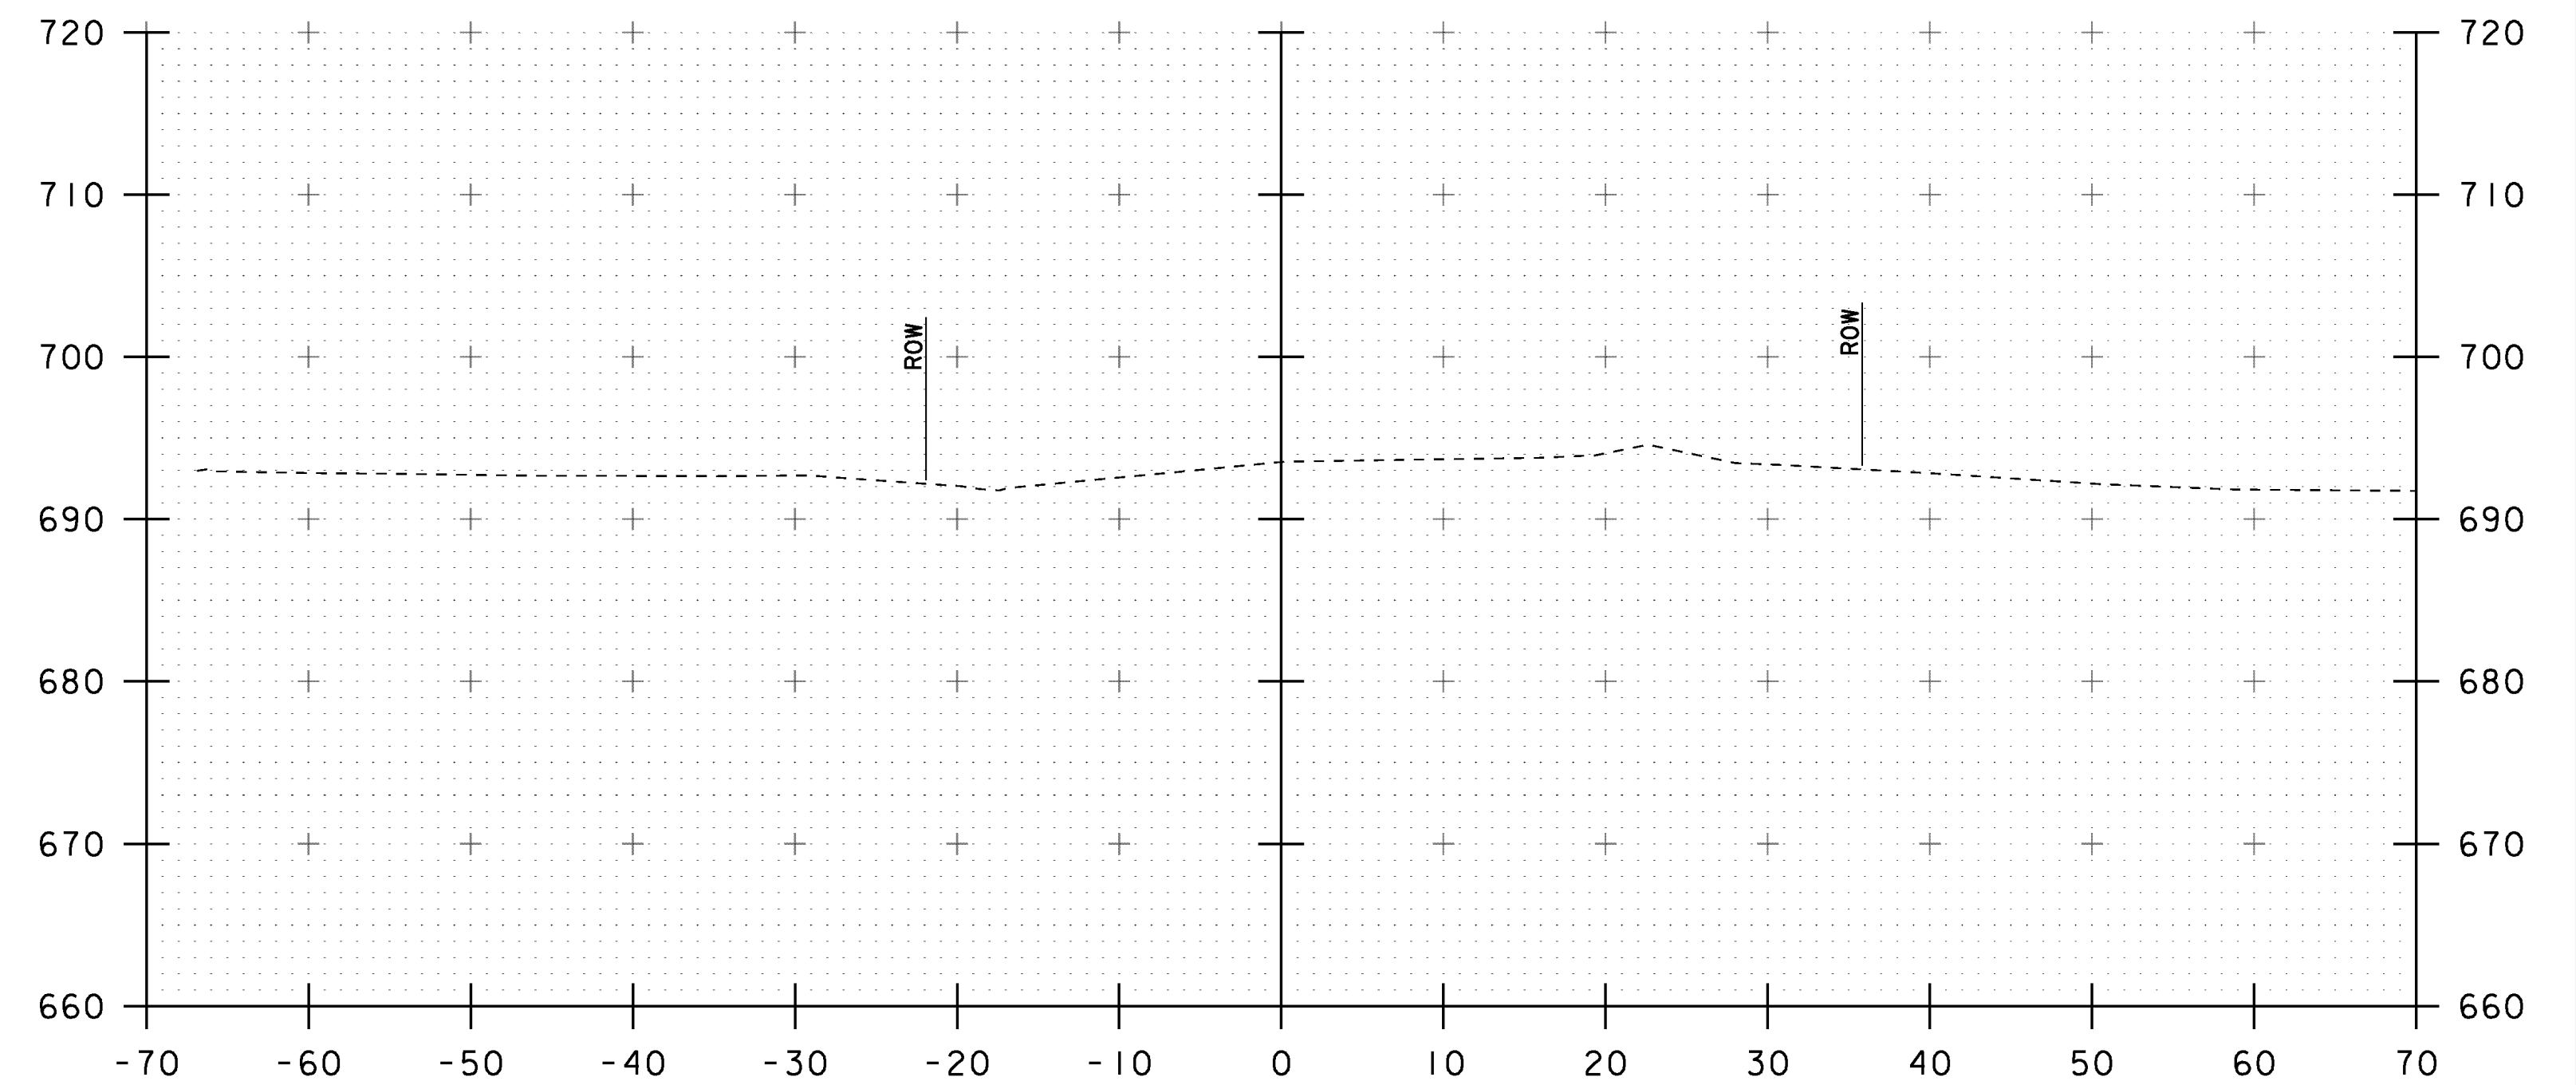

17+25

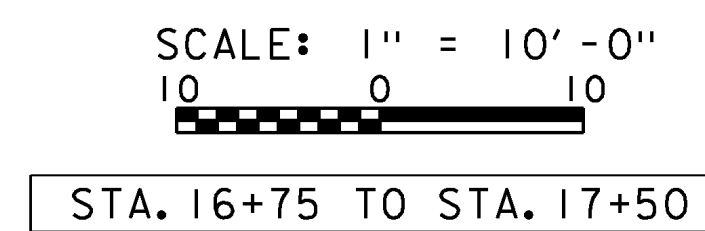

STA. 16+75 TO STA. 17+50

PROJECT NAME: STOWE	PLOT DATE: 17-JUN-2013
PROJECT NUMBER: BRF 029-1(17)	DRAWN BY: R. PELLETT
FILE NAME: s85e037xsl.dgn	CHECKED BY: G. ROY
PROJECT LEADER: C. CARLSON	SHEET 47 OF 70
DESIGNED BY: H. SALLS	
MAINLINE CROSS SECTIONS 5	