



49+25


CHANNEL STA 49+18.9 RT  
 BEGIN UNCLASSIFIED CHANNEL EXCAVATION  
 GEOTEXTILE UNDER STONE FILL  
 STONE FILL, TYPE IV  
 GRUBBING MATERIAL

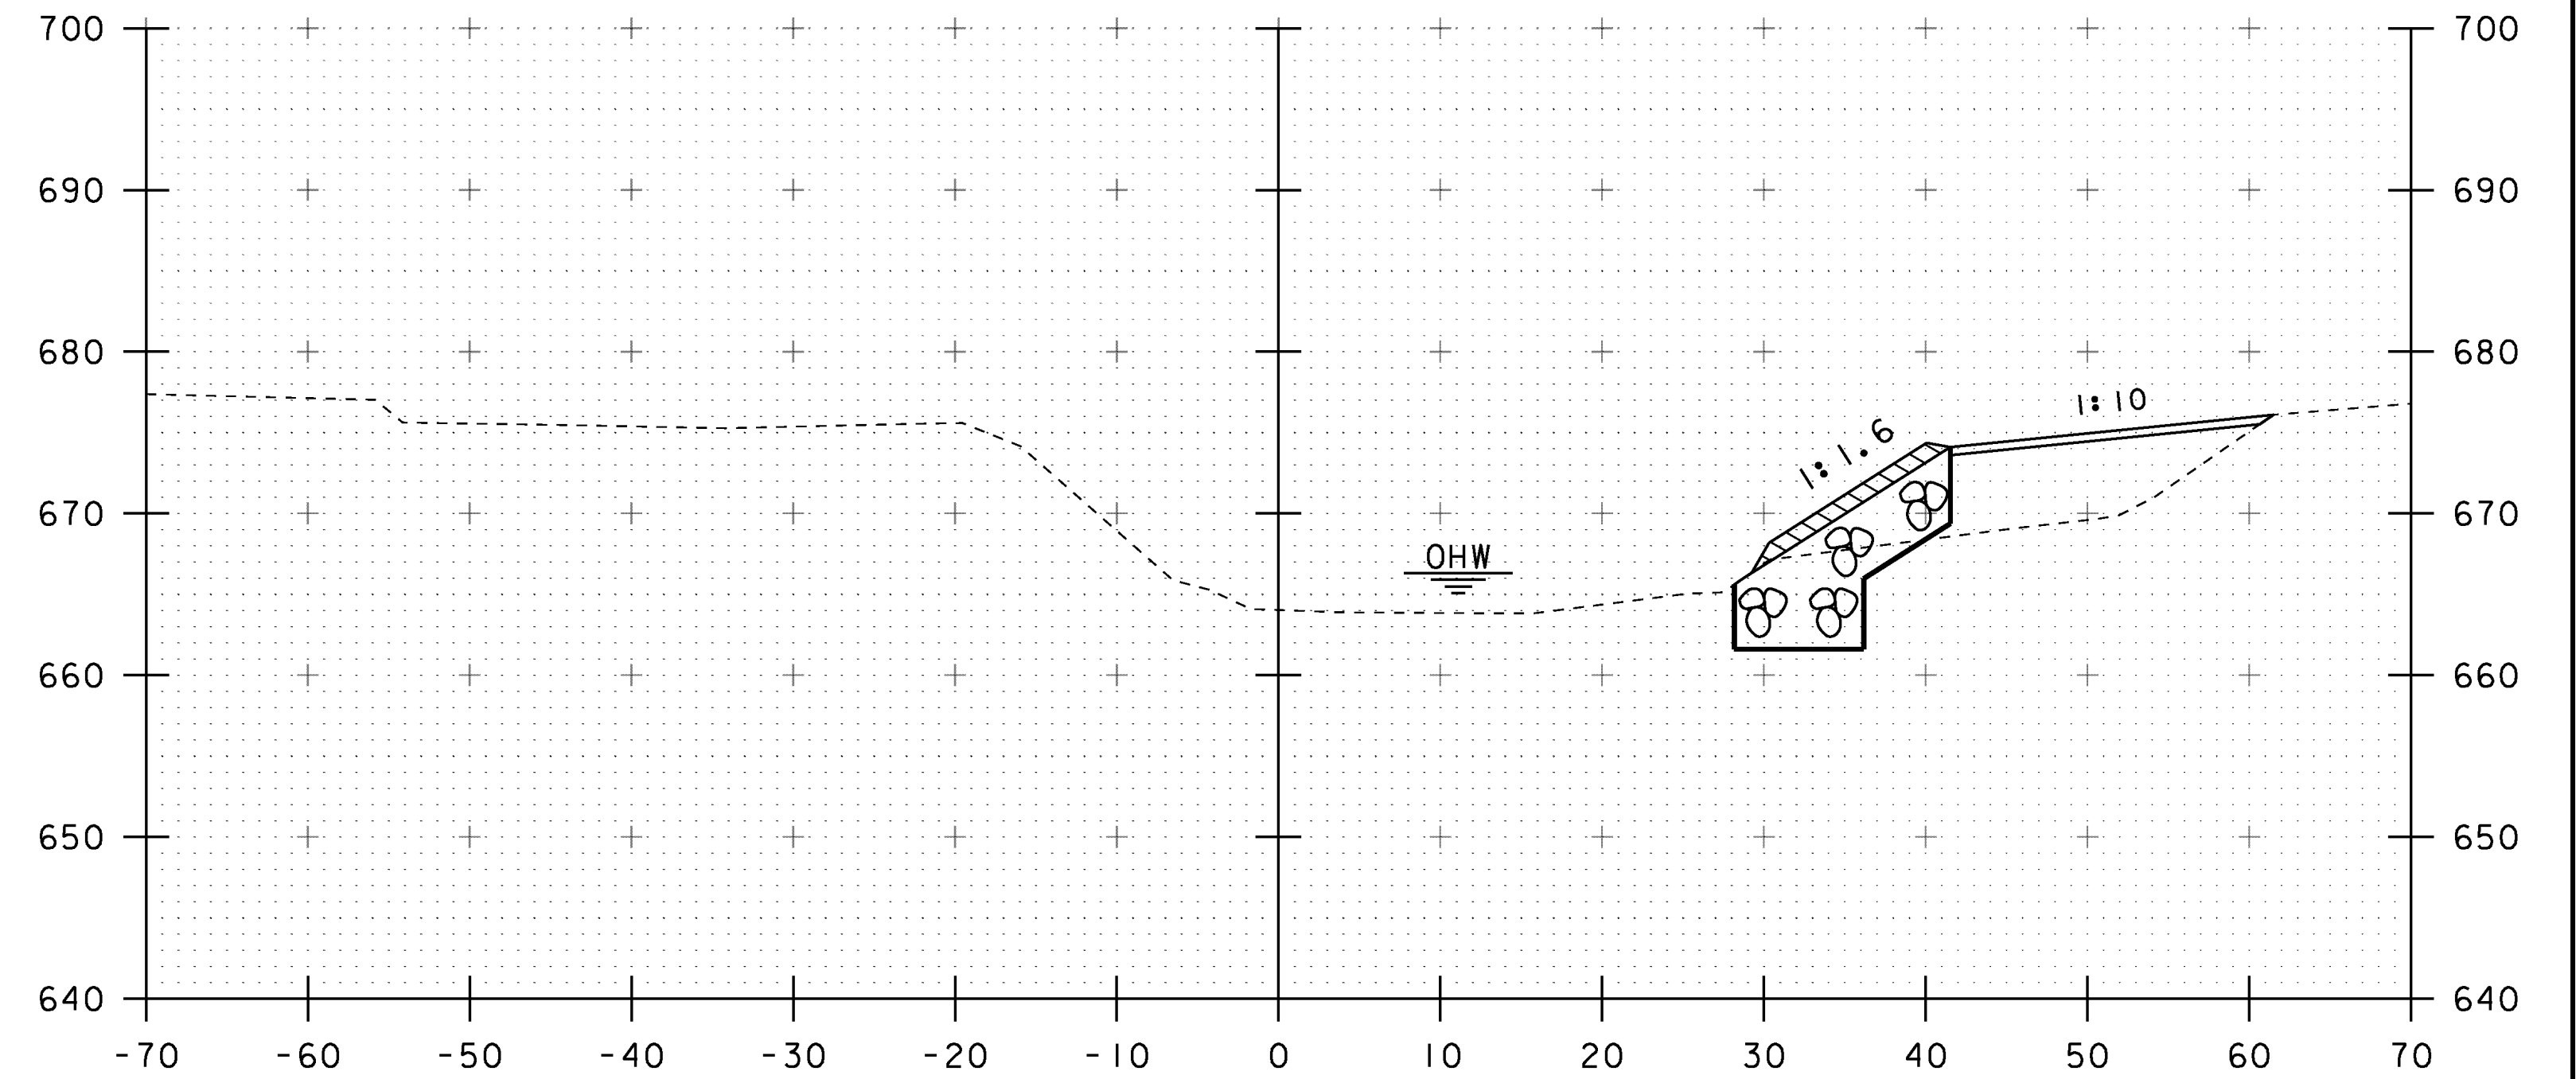


49+75

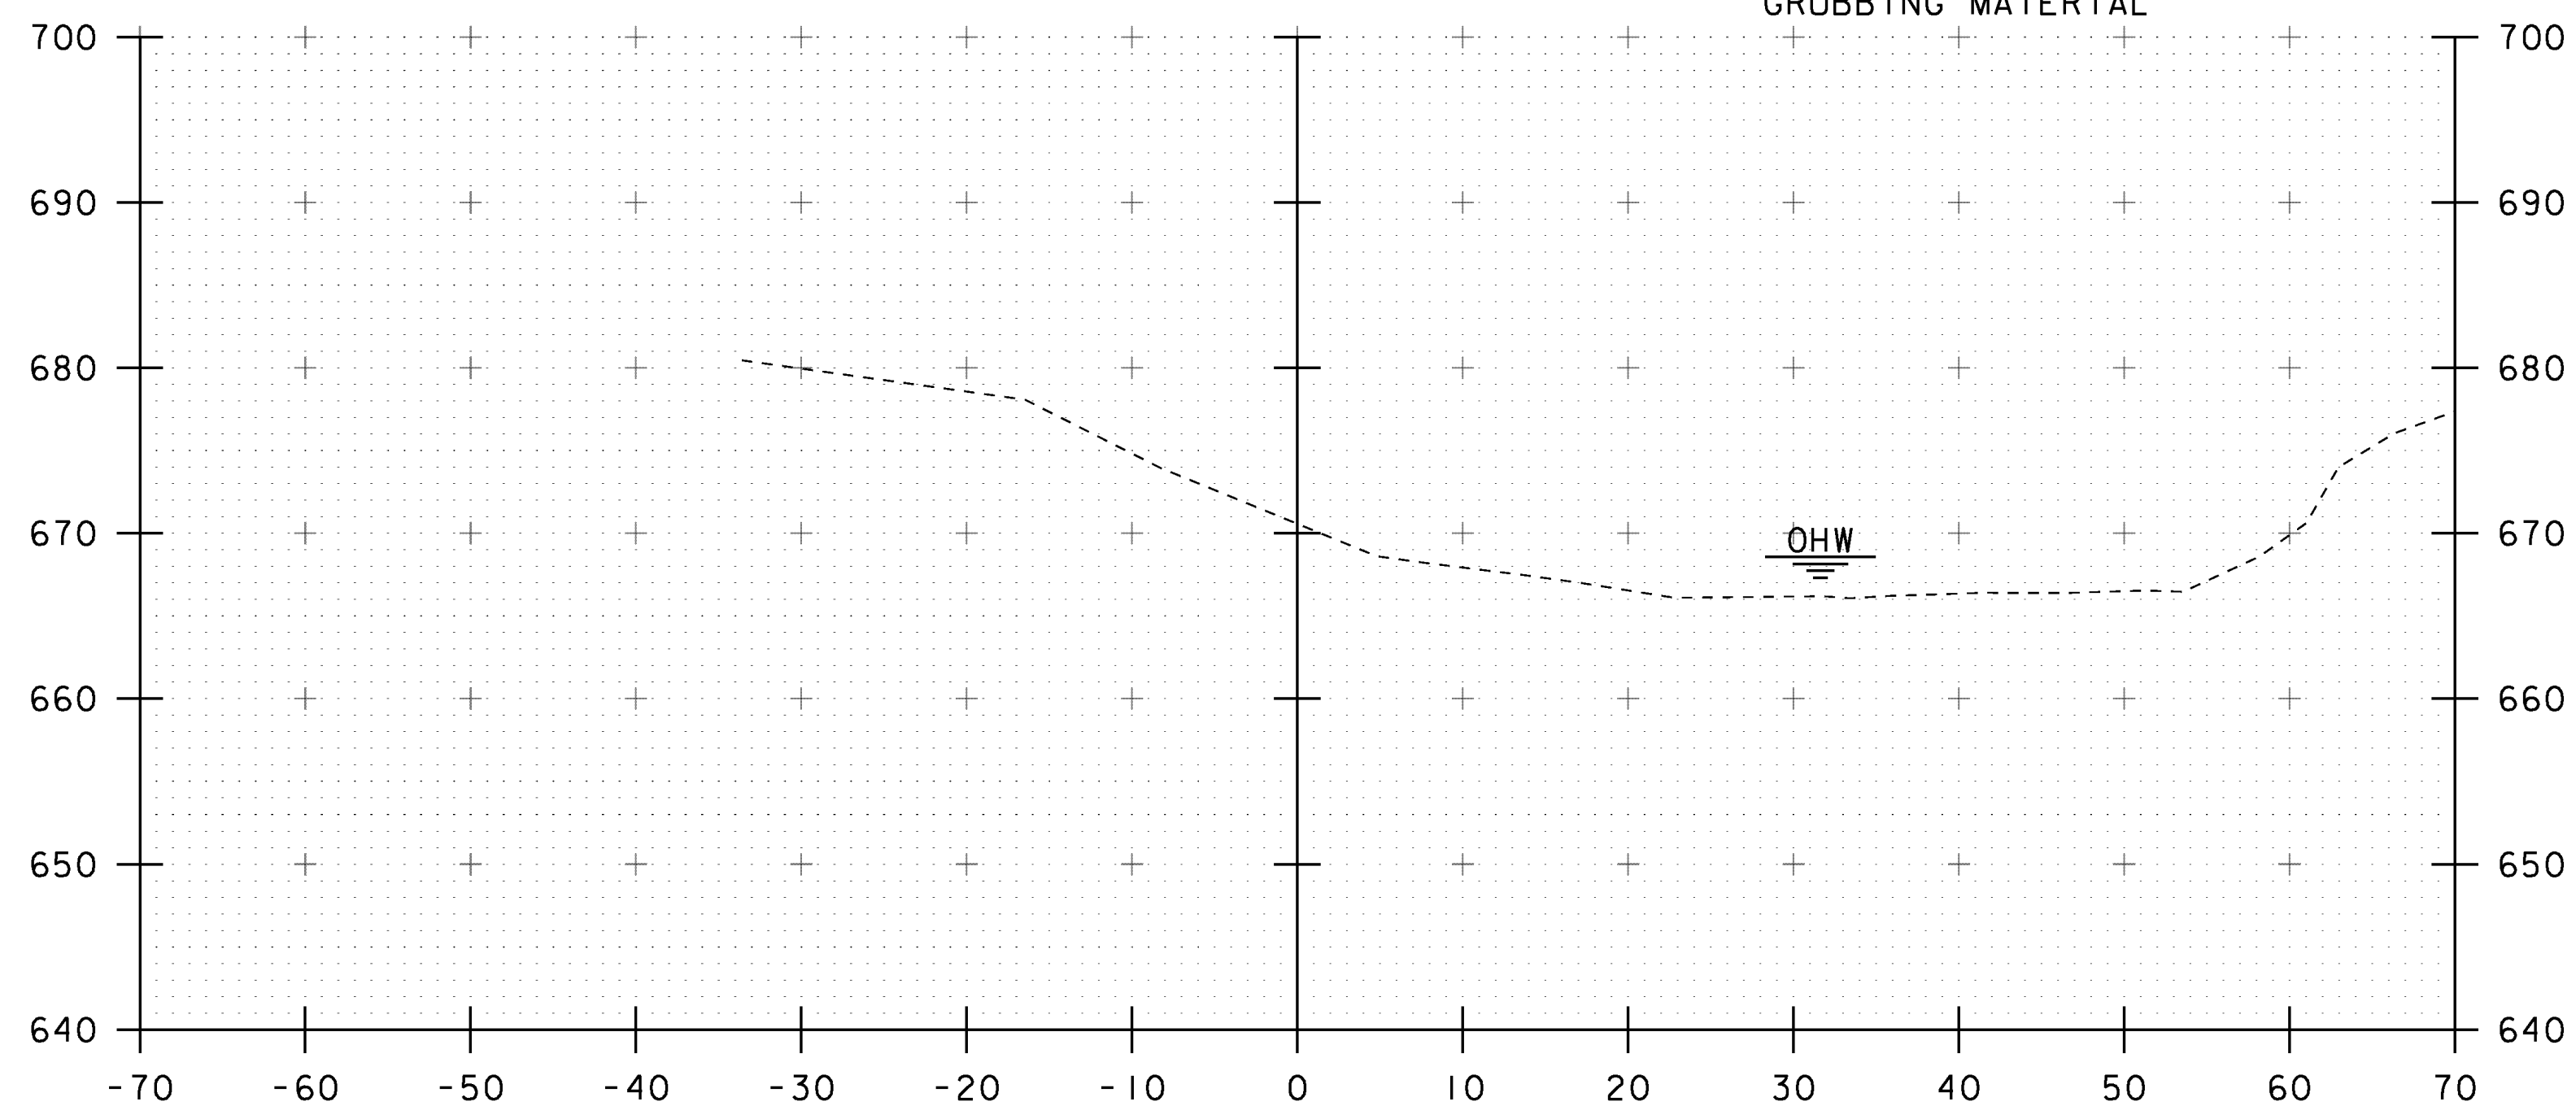

49+00

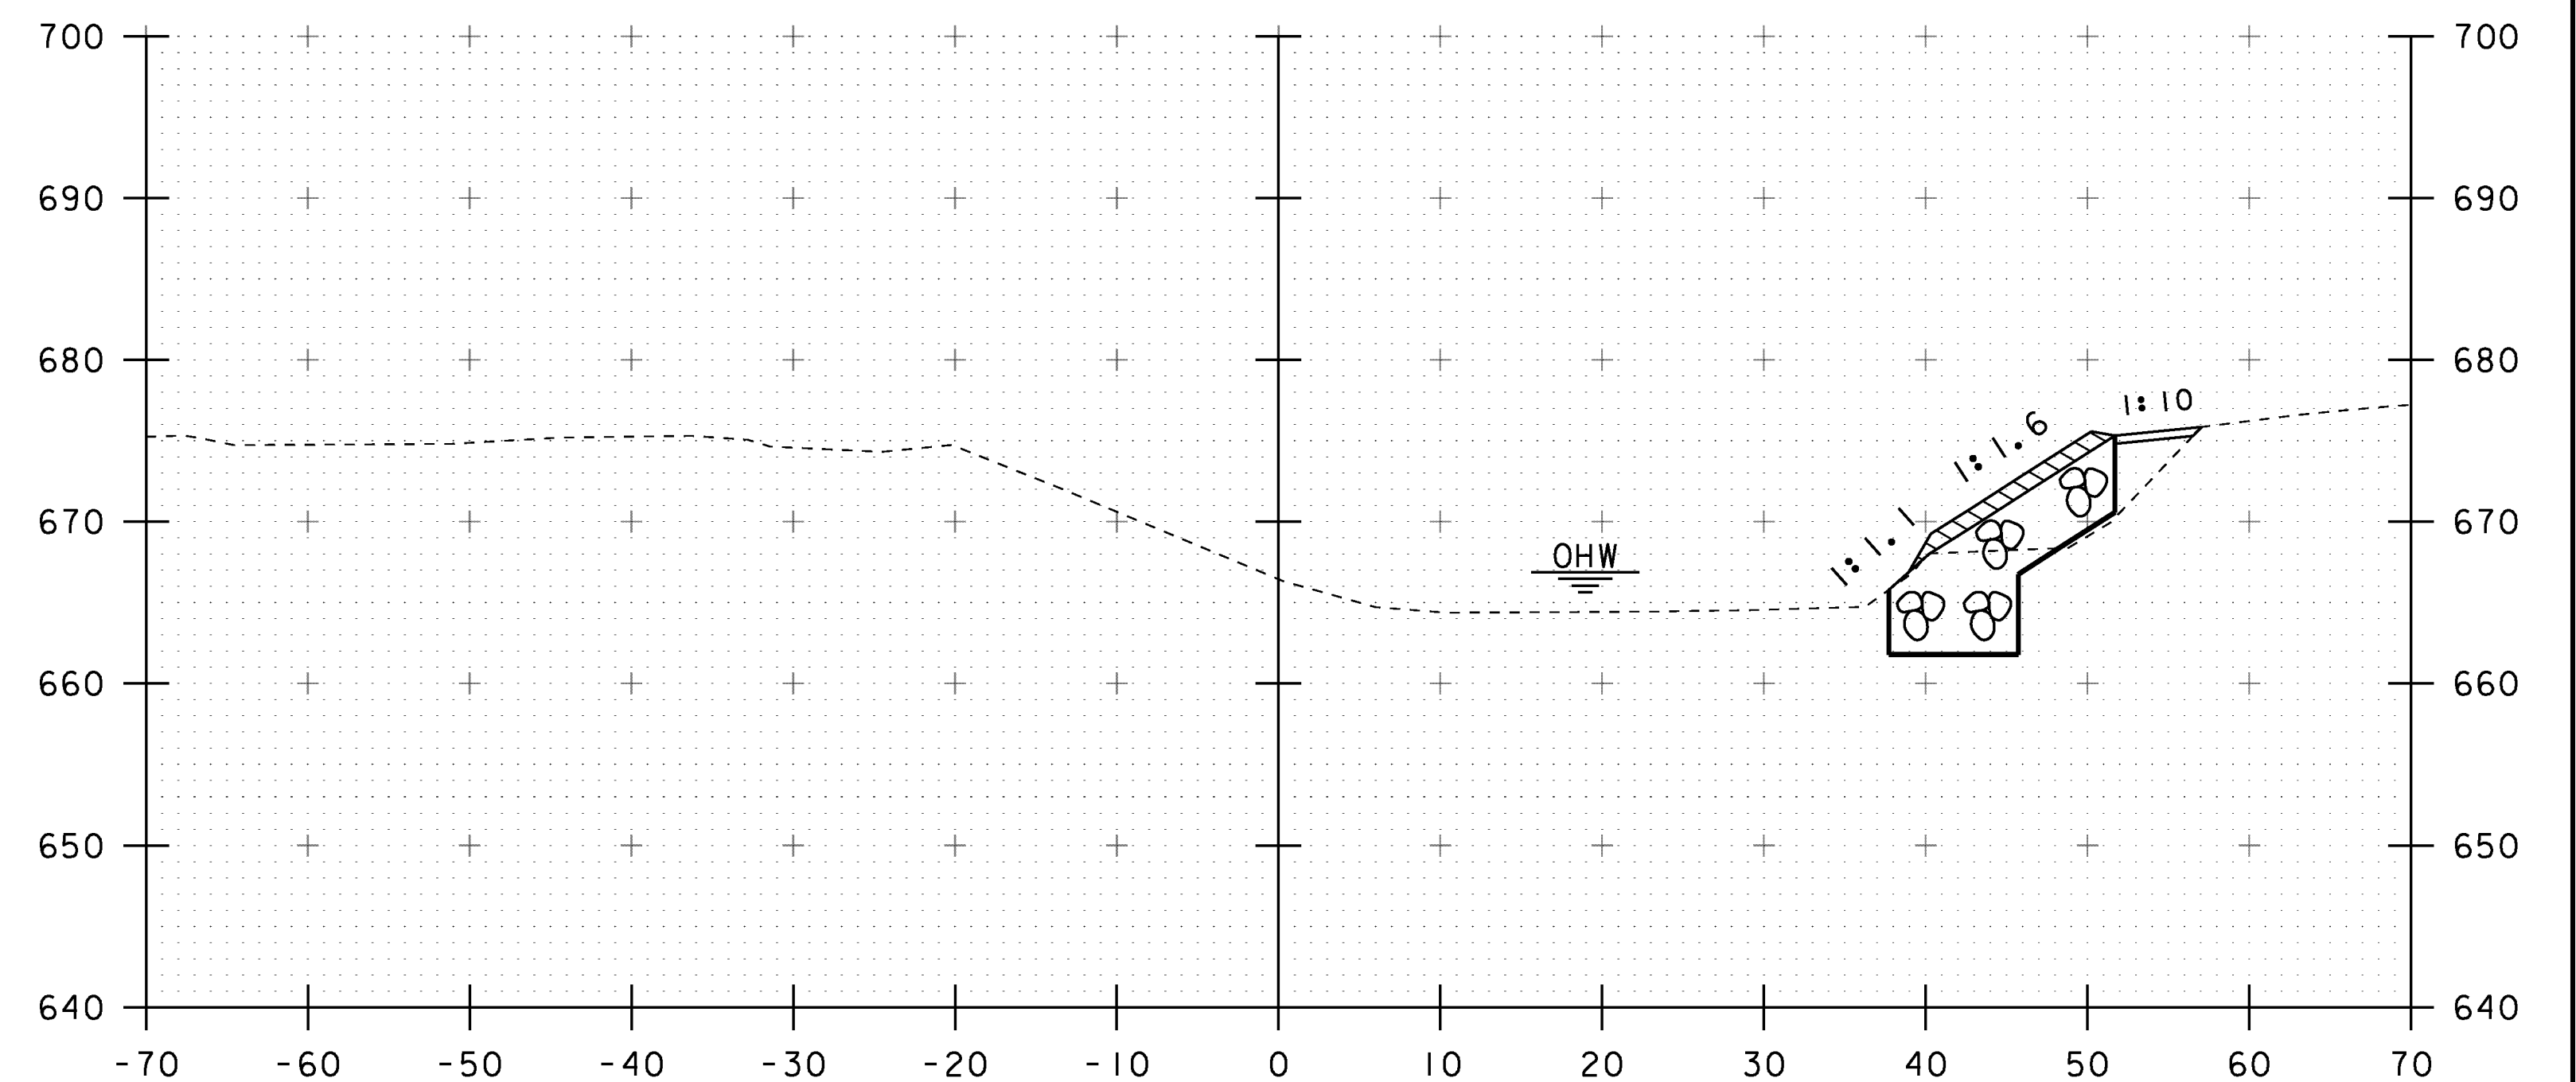

49+50

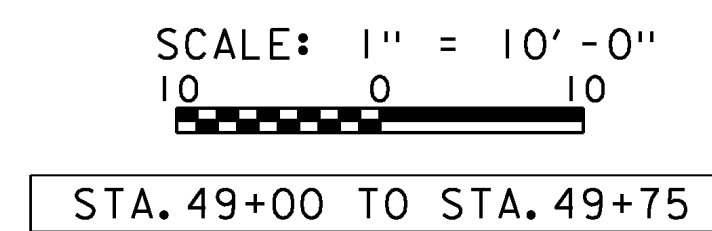

PROJECT NAME: STOWE	PLOT DATE: 17-JUN-2013
PROJECT NUMBER: BRF 029-1(17)	DRAWN BY: R. PELLETT
FILE NAME: s85e037xsl.dgn	CHECKED BY: G. ROY
PROJECT LEADER: C. CARLSON	SHEET 50 OF 70
DESIGNED BY: H. SALLS	
CHANNEL CROSS SECTIONS 1	